



Howard County  
Health Department

LOTS 7, 9

# APPLICATION

## FOR PERCOLATION TESTING AND SITE EVALUATION

TEST DATE(S) \_\_\_\_\_

TEST TIME \_\_\_\_\_

AP 522493-H

AGENCY REVIEW: \_\_\_\_\_

DATE 5/24/05

DO NOT WRITE ABOVE THIS LINE

I HEREBY APPLY FOR THE NECESSARY TESTING/EVALUATION PRIOR TO ISSUANCE OF SEWAGE DISPOSAL SYSTEM PERMIT(S) TO:

CHECK AS NEEDED:

- CONSTRUCT NEW SEPTIC SYSTEM(S)
- REPAIR/ADD TO AN EXISTING SEPTIC SYSTEM
- REPLACE AN EXISTING SEPTIC SYSTEM

CHECK ONE:

- CREATE NEW LOT(S)
- BUILD ON AN EXISTING LOT IN A SUBDIVISION
- BUILD ON AN EXISTING PARCEL OF RECORD

CHECK AS NEEDED:

- NEW STRUCTURE(S)
- ADDITION TO AN EXISTING STRUCTURE
- REPLACE AN EXISTING STRUCTURE

IS THE PROPERTY WITHIN 2500' OF ANY RESERVOIR?

- YES
- NO

THE TYPE OF STRUCTURE IS:

- RESIDENTIAL WITH PROPOSED BEDROOMS IN THE COMPLETED STRUCTURE (NOTE UNKNOWN IF APPROPRIATE)
- COMMERCIAL (PROVIDE DETAIL OF NUMBERS AND TYPES OF EMPLOYEES/CUSTOMERS ON ACCOMPANYING PLAN)
- INSTITUTIONAL/GOVERNMENT (PROVIDE DETAIL OF NUMBERS AND TYPES OF EMPLOYEES/USERS ON ACCOMPANYING PLAN)

PROPERTY OWNER(S) Frances Devlin

DAYTIME PHONE (410) 997-7400 (GOODIER BUILDERS) CELL \_\_\_\_\_ FAX \_\_\_\_\_

MAILING ADDRESS ECHO FARM ROUTE 3, 43 EAST LITCHFIELD ROAD, LITCHFIELD, CONNECTICUT 06750  
STREET CITY/TOWN STATE ZIP

APPLICANT Heritage Land Development

DAYTIME PHONE 410-489-7900 CELL 410-984-0408 FAX 410-489-9768

MAILING ADDRESS 3060 Washington Road, Suite 220 Glenwood MD 21738  
STREET CITY/TOWN STATE ZIP

APPLICANT'S ROLE  DEVELOPER  BUILDER  BUYER  RELATIVE/FRIEND  REALTOR  CONSULTANT

PROPERTY LOCATION  
SUBDIVISION NAME Meriweather Farm LOT NO. 9

PROPERTY ADDRESS 14944 Roxbury Road Glenelg  
STREET TOWN/POST OFFICE



TAX MAP PAGE(S) 21 GRID 16 PARCEL(S) 28 PROPOSED LOT SIZE 1 Acre

AS APPLICANT, I UNDERSTAND THE FOLLOWING: THE SYSTEM INSTALLED SUBSEQUENT TO THIS APPLICATION IS ACCEPTABLE ONLY UNTIL PUBLIC SEWAGE IS AVAILABLE. THIS APPLICATION IS COMPLETE WHEN ALL APPLICABLE FEES AND A SUITABLE SITE PLAN HAVE BEEN RECEIVED. I ACCEPT THE RESPONSIBILITY FOR COMPLIANCE WITH ALL M.O.S.H.A. AND "MISS UTILITY" REQUIREMENTS. APPROVAL IS BASED UPON SATISFACTORY REVIEW OF A PERC CERTIFICATION PLAN. TEST RESULTS WILL BE MAILED TO APPLICANT.

*Jeremy Rutter*  
SIGNATURE OF APPLICANT

HOWARD COUNTY HEALTH DEPARTMENT, BUREAU OF ENVIRONMENTAL HEALTH, WELL AND SEPTIC PROGRAM  
3525-H ELLICOTT MILLS DRIVE, ELLICOTT CITY, MARYLAND 21043-4544 (410) 313-1771 FAX (410) 313-2648  
TDD (410) 313-2323 TOLL FREE 1-877-4MD-DHMH

A/P Lot 9

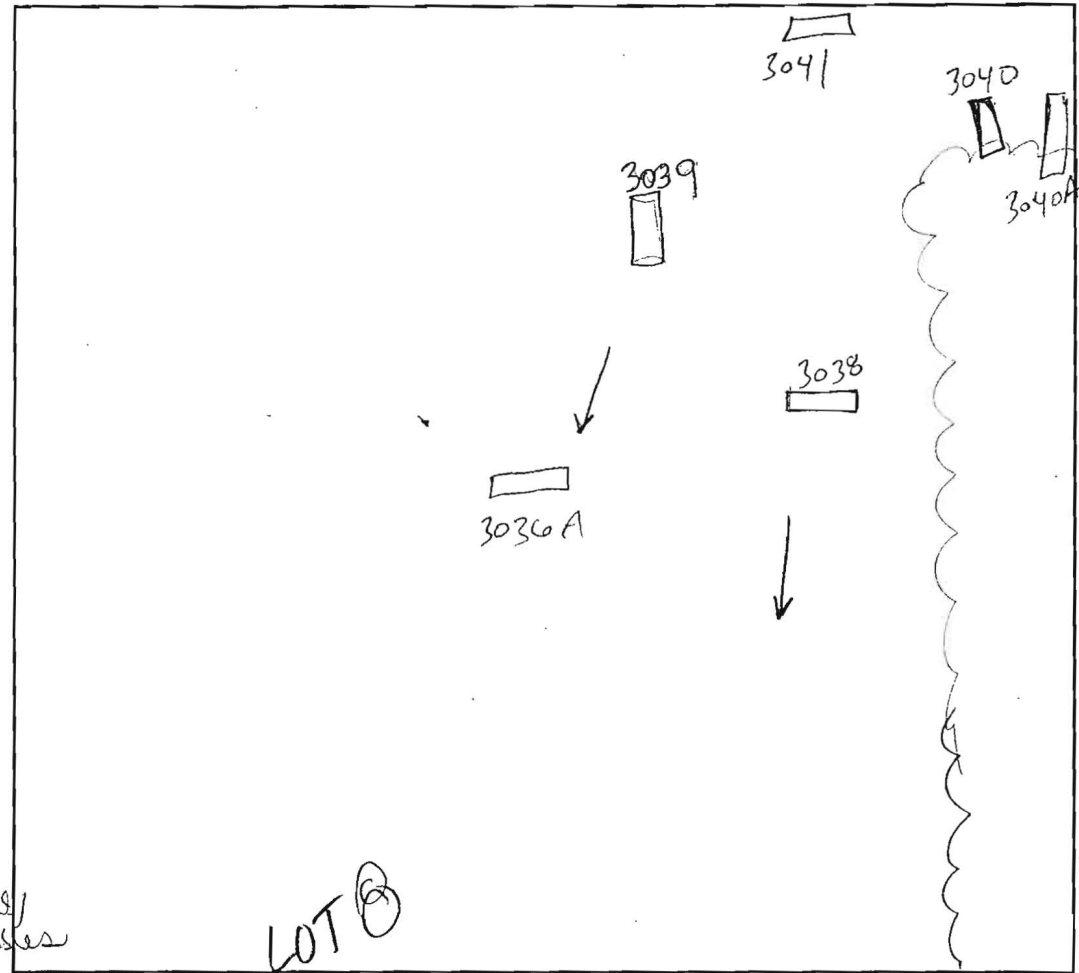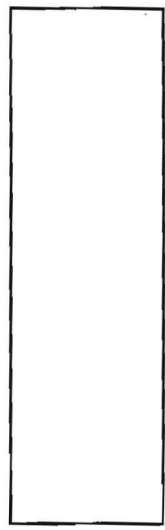


3035  
brown L  
orange brown  
CW SiL  
Sbk  
28"  
yellow brown  
SiL sg  
5% cobbles  
Stony  
11"  
3040 A  
brown L  
5% gravel/cobbles  
yellow brown  
L sbk  
CW  
2' uphill | downhill  
orange brown | orange brown  
CL? |  
sbk | DSL  
CW | CW  
6"  
10% cobbles/gravels  
7.5"

3039  
brown L  
orange brown  
SiL  
CW sbk  
5% rock gravel/cobbles  
5"  
yellow brown  
SiL sg  
CW  
trace rock  
11'8"

3038  
brown L  
1'  
orange brown  
hl-sil  
CW sbk-bk  
5'  
orange brown  
SiL sg  
CW bk  
5% gravel/cobbles

DATE	TEST #	DEPTH	START	BREAK 1" DROP	STOP 2" DROP	TIME OF 2nd INCH	P/F/H
6/27	3039	6" / 11'8"	3:34	3:50	4:02	12	P
	3038	4'10" / 10'8"	3:28 <sup>32</sup>	3:35 <sup>21</sup>	3:44 <sup>28</sup>	9 <sup>07</sup>	P
	3040	4'8" / 12'	2:13 <sup>20</sup>	2:26 <sup>30</sup>			F
6-29-05	3040A	4'6" / 7.5'	11:36 <sup>42</sup>	11:38 <sup>32</sup>	11:42 <sup>03</sup>	3 <sup>29</sup>	P
	3036A	5'10"		HB			F
	3041	5'4" / 13'	2:20 <sup>26</sup>	2:29 <sup>03</sup>	2:44 <sup>48</sup>	15 <sup>45</sup>	P
	?	3037					

REMARKS Holes dug per plan - 3036A & 3040A were field located 25' from failed holes  
 SANITARIAN SF BACKHOE Level Land OTHERS Tim Feage  
 TEST HOLES USED IN SDA \_\_\_\_\_ AVG. PERC TIME \_\_\_\_\_ SQ. FT/BR \_\_\_\_\_  
 TRENCH WIDTH \_\_\_\_\_ INLET DEPTH \_\_\_\_\_ MAX. BOT DEPTH \_\_\_\_\_ EFFECTIVE S/W \_\_\_\_\_

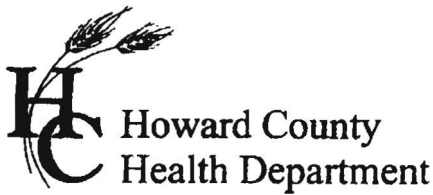

Holes Now in Pres Parcel "A"  
**APPLICATION**

**FOR PERCOLATION TESTING AND SITE EVALUATION**

TEST DATE(S) \_\_\_\_\_

TEST TIME \_\_\_\_\_

AP 522493-6

AGENCY REVIEW: \_\_\_\_\_

DATE: 5/24/05

**DO NOT WRITE ABOVE THIS LINE**

I HEREBY APPLY FOR THE NECESSARY TESTING/EVALUATION PRIOR TO ISSUANCE OF SEWAGE DISPOSAL SYSTEM PERMIT(S) TO:

CHECK AS NEEDED:

- CONSTRUCT NEW SEPTIC SYSTEM(S)
- REPAIR/ADD TO AN EXISTING SEPTIC SYSTEM
- REPLACE AN EXISTING SEPTIC SYSTEM

CHECK AS NEEDED:

- NEW STRUCTURE(S)
- ADDITION TO AN EXISTING STRUCTURE
- REPLACE AN EXISTING STRUCTURE

CHECK ONE:

- CREATE NEW LOT(S)
- BUILD ON AN EXISTING LOT IN A SUBDIVISION
- BUILD ON AN EXISTING PARCEL OF RECORD

IS THE PROPERTY WITHIN 2500' OF ANY RESERVOIR?

- YES
- NO

THE TYPE OF STRUCTURE IS:

- RESIDENTIAL WITH PROPOSED BEDROOMS IN THE COMPLETED STRUCTURE (NOTE UNKNOWN IF APPROPRIATE)
- COMMERCIAL (PROVIDE DETAIL OF NUMBERS AND TYPES OF EMPLOYEES/CUSTOMERS ON ACCOMPANYING PLAN)
- INSTITUTIONAL/GOVERNMENT (PROVIDE DETAIL OF NUMBERS AND TYPES OF EMPLOYEES/USERS ON ACCOMPANYING PLAN)

PROPERTY OWNER(S) Frances Devlin

DAYTIME PHONE (410) 997-7400 (GOODIER BUILDERS) CELL \_\_\_\_\_ FAX \_\_\_\_\_

MAILING ADDRESS ECHO FARM ROUTE 3, 43 EAST LITCHFIELD ROAD, LITCHFIELD, CONNECTICUT 06750  
STREET CITY/TOWN STATE ZIP

APPLICANT Heritage Land Development

DAYTIME PHONE 410-489-7900 CELL 410-984-0408 FAX 410-489-9768

MAILING ADDRESS 3060 Washington Road, Suite 220 Glenwood MD 21738  
STREET CITY/TOWN STATE ZIP

APPLICANT'S ROLE  DEVELOPER  BUILDER  BUYER  RELATIVE/FRIEND  REALTOR  CONSULTANT

PROPERTY LOCATION Meriweather Farm LOT NO. 8

PROPERTY ADDRESS 14944 Roxbury Road Glenelg  
STREET TOWN/POST OFFICE



TAX MAP PAGE(S) 21 GRID 16 PARCEL(S) 28 PROPOSED LOT SIZE 1 Acre

AS APPLICANT, I UNDERSTAND THE FOLLOWING: THE SYSTEM INSTALLED SUBSEQUENT TO THIS APPLICATION IS ACCEPTABLE ONLY UNTIL PUBLIC SEWAGE IS AVAILABLE. THIS APPLICATION IS COMPLETE WHEN ALL APPLICABLE FEES AND A SUITABLE SITE PLAN HAVE BEEN RECEIVED. I ACCEPT THE RESPONSIBILITY FOR COMPLIANCE WITH ALL M.O.S.H.A. AND "MISS UTILITY" REQUIREMENTS. APPROVAL IS BASED UPON SATISFACTORY REVIEW OF A PERC CERTIFICATION PLAN. TEST RESULTS WILL BE MAILED TO APPLICANT.

Jeremy Rutter  
SIGNATURE OF APPLICANT

HOWARD COUNTY HEALTH DEPARTMENT, BUREAU OF ENVIRONMENTAL HEALTH, WELL AND SEPTIC PROGRAM  
3525-H ELLICOTT MILLS DRIVE, ELLICOTT CITY, MARYLAND 21043-4544 (410) 313-1771 FAX (410) 313-2648  
TDD (410) 313-2323 TOLL FREE 1-877-4MD-DHMH

A/P Lot 8

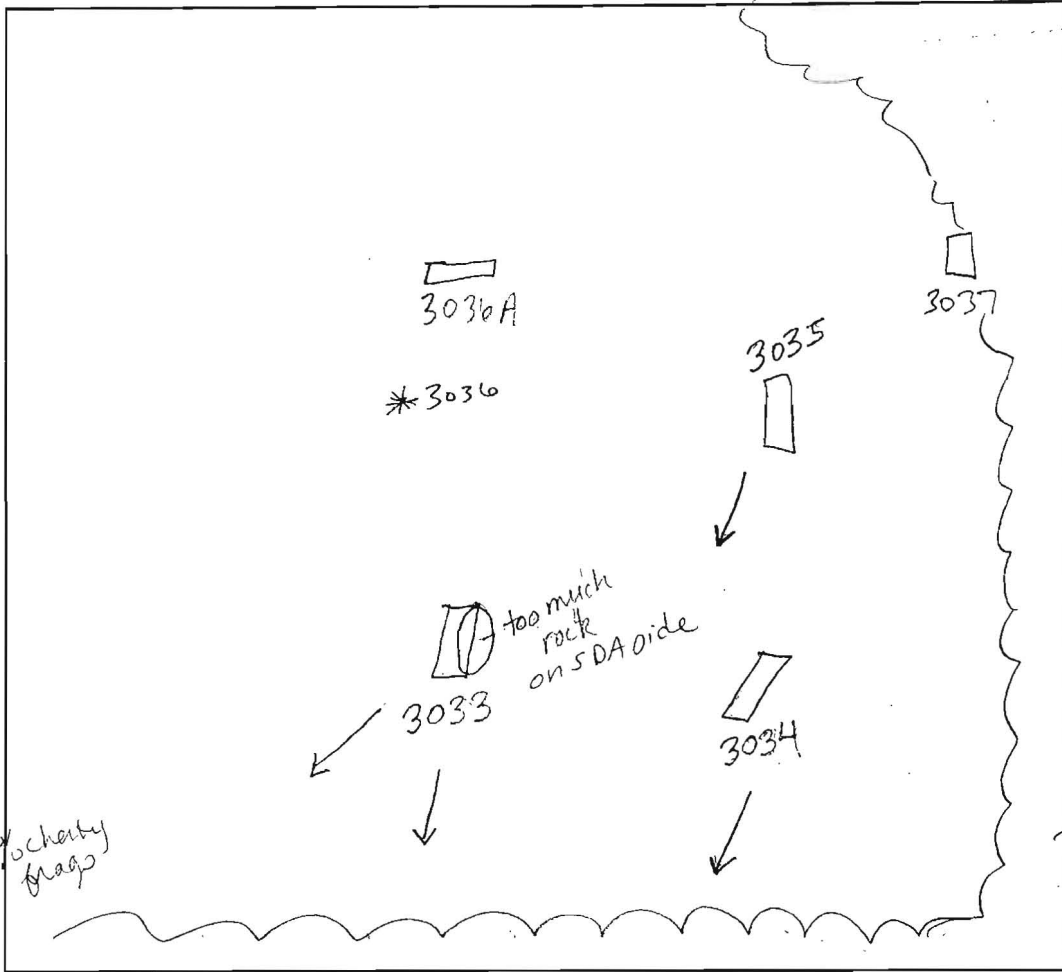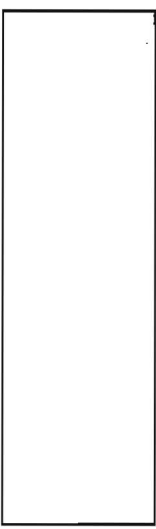

3033  
brown L  
35% cobbles / Stony

3036 A  
brown L  
orange brown  
nl → sil  
cw sbk  
yellow brown  
sil sg  
Abowhole:  
30% cobbles / Stony

3034  
brown L  
6"  
red/orange brown  
L-sil  
cw sbk  
2'9"  
yellow brown  
sil sg  
cw bk  
5% coarse cherty

3035  
brown L  
orange brown  
sil cw  
sbk  
2'8"  
yellow brown  
sil sg  
5% cobbles / Stony

DATE	TEST #	DEPTH	START	BREAK 1" DROP	STOP 2" DROP	TIME OF 2nd INCH	P/F/H
6-28-05	3035	4'7" / 11'	3:45 <sup>35</sup>	3:47 <sup>48</sup>	3:51 <sup>18</sup>	3 <sup>30</sup>	P
	3034	5' / 13'	8:36 <sup>23</sup>	8:39 <sup>37</sup>	8:42 <sup>18</sup>	2 <sup>19</sup>	P
?	3037						
	3033	6'4" / 11'		too much rock	on SDA side <sup>F</sup>		
	3036			rock			VF
	3036A	5'10"			HB		VF


REMARKS Holes dug per plan - 306JA field located 25' uphill from POPC

SANITARIAN SF / KN BACKHOE Level Land OTHERS Tim Feage

TEST HOLES USED IN SDA \_\_\_\_\_ AVG. PERC TIME \_\_\_\_\_ SQ. FT/BR \_\_\_\_\_

TRENCH WIDTH \_\_\_\_\_ INLET DEPTH \_\_\_\_\_ MAX. BOT DEPTH \_\_\_\_\_ EFFECTIVE S/W \_\_\_\_\_

LOT 8

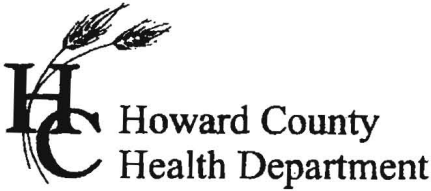

# APPLICATION

## FOR PERCOLATION TESTING AND SITE EVALUATION

TEST DATE(S) \_\_\_\_\_

TEST TIME \_\_\_\_\_

AP 5224FB-I

AGENCY REVIEW: \_\_\_\_\_

DATE 5/24/05

**DO NOT WRITE ABOVE THIS LINE**

I HEREBY APPLY FOR THE NECESSARY TESTING/EVALUATION PRIOR TO ISSUANCE OF SEWAGE DISPOSAL SYSTEM PERMIT(S) TO:

CHECK AS NEEDED:

- CONSTRUCT NEW SEPTIC SYSTEM(S)
- REPAIR/ADD TO AN EXISTING SEPTIC SYSTEM
- REPLACE AN EXISTING SEPTIC SYSTEM

CHECK AS NEEDED:

- NEW STRUCTURE(S)
- ADDITION TO AN EXISTING STRUCTURE
- REPLACE AN EXISTING STRUCTURE

CHECK ONE:

- CREATE NEW LOT(S)
- BUILD ON AN EXISTING LOT IN A SUBDIVISION
- BUILD ON AN EXISTING PARCEL OF RECORD

IS THE PROPERTY WITHIN 2500' OF ANY RESERVOIR?

- YES
- NO

THE TYPE OF STRUCTURE IS:

- RESIDENTIAL WITH PROPOSED BEDROOMS IN THE COMPLETED STRUCTURE (NOTE UNKNOWN IF APPROPRIATE)
- COMMERCIAL (PROVIDE DETAIL OF NUMBERS AND TYPES OF EMPLOYEES/CUSTOMERS ON ACCOMPANYING PLAN)
- INSTITUTIONAL/GOVERNMENT (PROVIDE DETAIL OF NUMBERS AND TYPES OF EMPLOYEES/USERS ON ACCOMPANYING PLAN)

PROPERTY OWNER(S)

**Frances Devlin**

DAYTIME PHONE

(410) 997-7400 (GOODIER BUILDERS)

CELL

FAX

MAILING ADDRESS

ECHO FARM ROUTE 3, 43 EAST LITCHFIELD ROAD, LITCHFIELD, CONNECTICUT 06750

STREET

CITY/TOWN

STATE

ZIP

APPLICANT

**Heritage Land Development**

DAYTIME PHONE

410-489-7900

CELL

410-984-0408

FAX

410-489-9768

MAILING ADDRESS

3060 Washington Road, Suite 220

Glenwood

MD

21738

STREET

CITY/TOWN

STATE

ZIP

APPLICANT'S ROLE

DEVELOPER

BUILDER

BUYER

RELATIVE/FRIEND

REALTOR

CONSULTANT

PROPERTY LOCATION

SUBDIVISION NAME

**Meriweather Farm**

LOT NO.

100

PROPERTY ADDRESS

14944 Roxbury Road

Glenelg

STREET

TOWN/POST OFFICE

TAX MAP PAGE(S)

21

GRID

16

PARCEL(S)

28

PROPOSED LOT SIZE

1 Acre


AS APPLICANT, I UNDERSTAND THE FOLLOWING: THE SYSTEM INSTALLED SUBSEQUENT TO THIS APPLICATION IS ACCEPTABLE ONLY UNTIL PUBLIC SEWAGE IS AVAILABLE. THIS APPLICATION IS COMPLETE WHEN ALL APPLICABLE FEES AND A SUITABLE SITE PLAN HAVE BEEN RECEIVED. I ACCEPT THE RESPONSIBILITY FOR COMPLIANCE WITH ALL M.O.S.H.A. AND "MISS UTILITY" REQUIREMENTS. APPROVAL IS BASED UPON SATISFACTORY REVIEW OF A PERC CERTIFICATION PLAN. TEST RESULTS WILL BE MAILED TO APPLICANT.

*Jeremy Rutter*

SIGNATURE OF APPLICANT

HOWARD COUNTY HEALTH DEPARTMENT, BUREAU OF ENVIRONMENTAL HEALTH, WELL AND SEPTIC PROGRAM  
 3525-H ELLICOTT MILLS DRIVE, ELLICOTT CITY, MARYLAND 21043-4544 (410) 313-1771 FAX (410) 313-2648  
 TDD (410) 313-2323 TOLL FREE 1-877-4MD-DHMH

A/P 522493

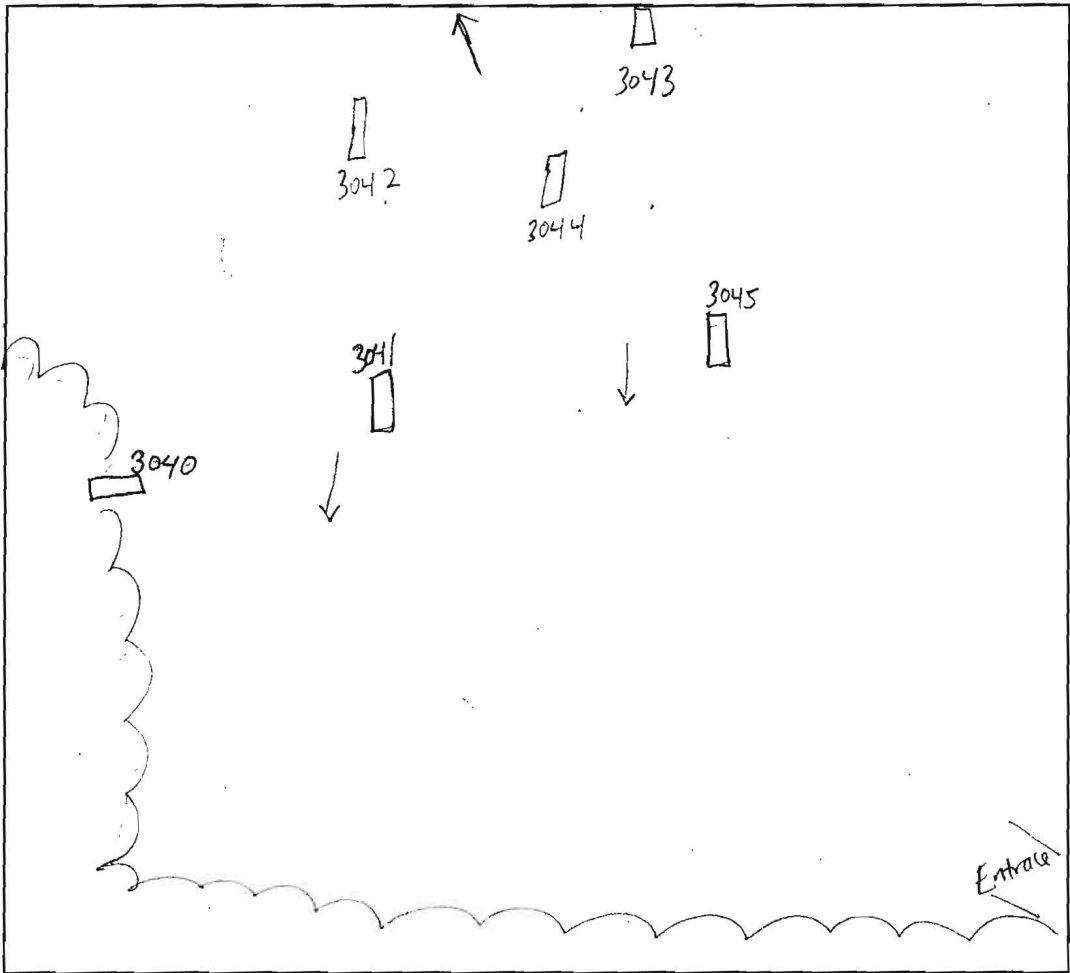

3044  
brown L  
orange brown sil cw bk  
5'  
orange/white sil bk cw sf  
trace rock  
12'4" 3042  
brown L  
1'  
orange brown sil cw sbk  
55"  
orange/white brown sil cw sbk  
trace rock  
12'2" 3043  
brown L  
11"  
orange brown sil sbk cw  
6"  
pink brown sil sg cw sbk  
12'

3041  
brown L  
9"  
orange/red brown hl-sil cw bk  
~5'9"  
9'  
orange brown sil sg cw sbk  
13'  
3045  
brown L  
orange brown sil cw bk  
54% cobbles/gravel  
5'  
orange/white brown sil gritty 25% rocks/gravel cobbles

DATE	TEST #	DEPTH	START	BREAK 1" DROP	STOP 2" DROP	TIME OF 2nd INCH	P/F/H
6-27-05	3041	5'4" / 13'	2:20 <sup>26</sup>	2:29 <sup>03</sup>	2:44 <sup>48</sup>	15 <sup>45</sup>	P
	3045	4'9" / 10'	2:46 <sup>48</sup>	2:48 <sup>55</sup>	2:51 <sup>16</sup>	2 <sup>39</sup>	P
	3044	4'9" / 12'4"	2:54 <sup>57</sup>	2:56 <sup>14</sup>	2:58 <sup>14</sup>	2	P
	3042	5'3" / 12'2"	3:00 <sup>04</sup>	3:03 <sup>54</sup>	3:10 <sup>45</sup>	6 <sup>51</sup>	P
	3043	5'11" / 12'	3:05"	3:10 <sup>18</sup>	3:24 <sup>53</sup>	14 <sup>35</sup>	P

REMARKS Holes dug per plan  
 SANITARIAN SF BACKHOE Level Land OTHERS Tim Feago  
 TEST HOLES USED IN SDA \_\_\_\_\_ AVG. PERC TIME 8.1 SQ. FT/BR \_\_\_\_\_  
 TRENCH WIDTH \_\_\_\_\_ INLET DEPTH \_\_\_\_\_ MAX. BOT DEPTH \_\_\_\_\_ EFFECTIVE S/W \_\_\_\_\_

Drawn by:

erty Article, Annotated Code  
As Supplemented) As Far As  
And The Setting Of Markers

8/20/10  
Date

8/24/10  
Date

**Reservation Of Public Utility And  
Forest Conservation Easements**

"Developer Reserves unto itself, its successors and assigns, all easements shown on this plan for water, sewer, storm drainage, other public utilities and forest conservation (designated as "Forest Conservation Area"), located in, on, over, and through Lots 1 thru 12, buildable preservation parcel 'A', non-buildable preservation parcels 'B' thru 'D' and non-buildable parcel 'E', any conveyances of the aforesaid lots/parcels shall be subject to the easements herein reserved, whether or not expressly stated in the deed(s) conveying said lots/parcels. Developer shall execute and deliver deeds for the easements herein reserved to Howard County, with a metes and bounds description of the forest conservation area. Upon completion of the public utilities and their acceptance by Howard County, and, in the case of the forest conservation easement(s), upon completion of the developer's obligations under the forest conservation installation and maintenance agreement executed by developer and the county, and the release of developer's surety posted with said agreement, the county shall accept the easements and record the deed(s) of easement in the land records of Howard County."

(Meters)  
E 396697.9934  
E 1301500  
N 176723.3934  
N 579800

Land Dedicated To  
Howard County, Maryland  
For The Purpose Of A Public  
Road (1.746 Ac.)

Match

**Double Bridges Court**

COPY  
Plat 21342  
10/29/10

