


AVP

TP# 6
 Br Org lm 0-12"
 Br SILT lm 12"-5'
 Br/TAN SAND (FINE) 5'-11'

TP# 7
 Br Org lm 0-16"
 Dr Br SILT/CLAY LM 16"-3'-6"
 Br SILT lm 3'-6"-7'
 TAN SAND (FINE) 7'-14'

TP# 8
 Br Org lm 0-16"
 Red/Br SILT LM 16"-5'
 TAN SAND (FINE) 5'-14'

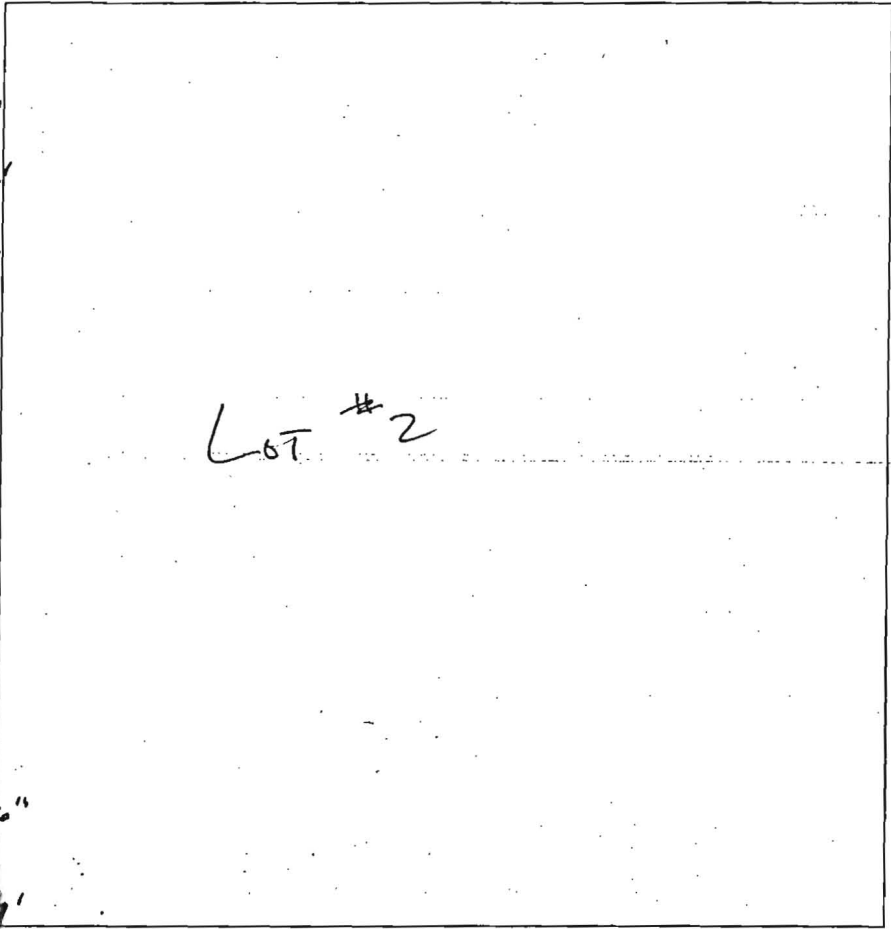

TP# 9
 Br Org lm 0-16"
 Red/Br SILT lm (BLOCKY) 16"-3'
 Br SILT lm 3'-5'
 TAN SAND (FINE) 5'-11'

TP# 10
 Br Org lm 0-16"
 Red/Br SILT lm 16"-4'
 TAN SAND (FINE) 4'-14'

DATE	TEST #	DEPTH	START	BREAK 1" DROP	STOP 2" DROP	TIME OF 2nd INCH	P/F/H
10/26/04	# 6	8' / 14'	10:38	10:43	10:49	5 min	P
	# 7	14'		VISUAL			P
	# 8	7' / 14'	10:51:30	10:55	11:00	5 min	P
	# 9	14'		VISUAL			P
	# 10	6' / 14'	11:12	11:15	11:19	4 min	P

REMARKS TP # 6 - 5'-14' INTERMITTENT SILT COAM @ 5'-7' - SET SILT DEEPER ON LOT

SANITARIAN R. Sheesley BACKHOE AEC OTHERS _____

TEST HOLES USED IN SDA _____ AVG. PERC TIME _____ SQ. FT/BR _____

TRENCH WIDTH _____ INLET DEPTH _____ MAX. BOT DEPTH _____ EFFECTIVE SW _____