


PROPOSED GROVE ADDITION  
 JOHN R. GROVE  
 10862 HARMEL DR.  
 COLUMBIA, MD. 21044  
~~HOME~~ HOME - 410-997-1652  
 OFC - 310-937-0260

SITE PLAN WITH PROPOSED ADDITION

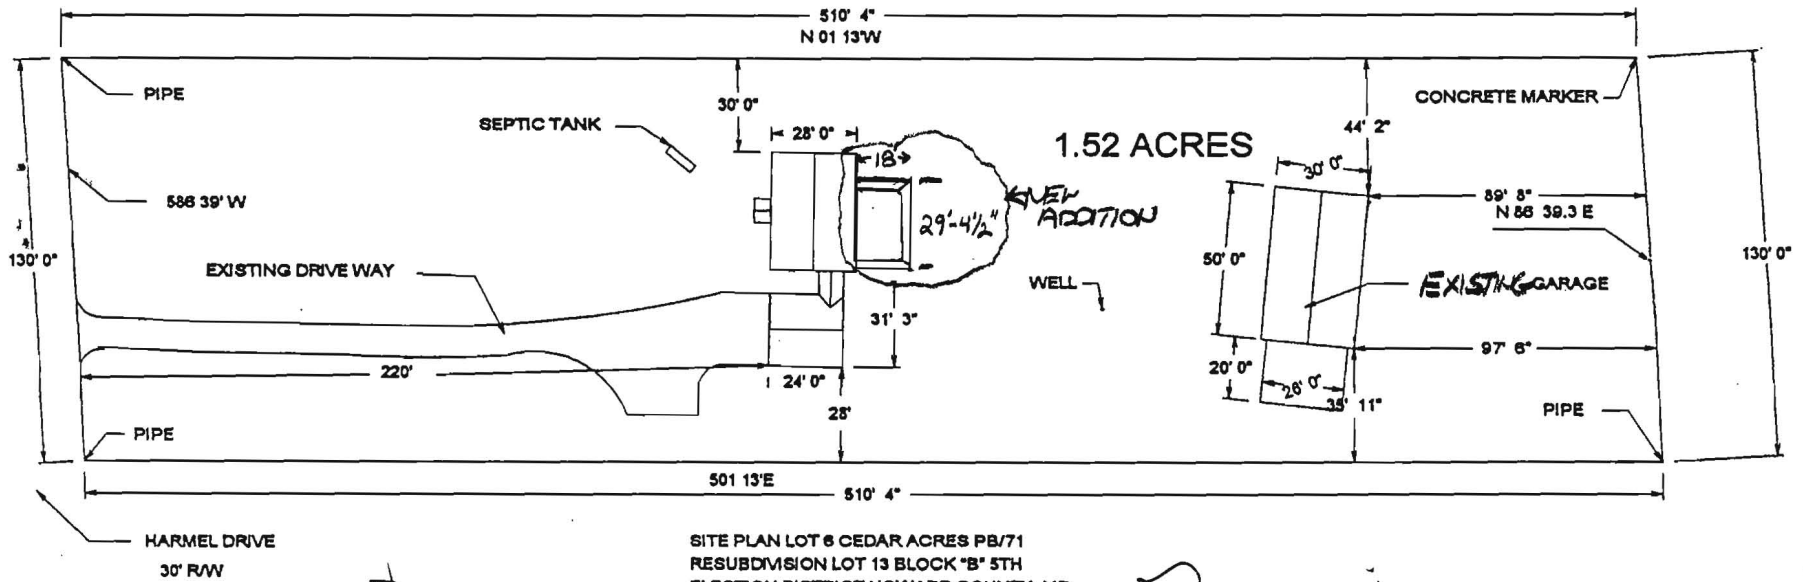

Tag #  
 H10-81-1373  
 Septic tank  
 junction  
 No issues

6/22/06  
 side  
 inspection  
 to well  
 in septic  
 tank  
 Perc  
 Not needed  
 if near  
 capacity  
 Public  
 sewer  
 from  
 (KR)