

PUB. SEWER STATUS VERIFIED BY _____

ISSUE DATE: 11/15/05

P 523648

APPROVAL DATE: 12/15/05

A REPAIR

PERMIT INDEXED

Tax ID# 05-368820

ON-SITE SEWAGE DISPOSAL SYSTEM HOWARD COUNTY HEALTH DEPARTMENT BUREAU OF ENVIRONMENTAL HEALTH

Fyock Septic Service, Inc. IS PERMITTED TO INSTALL ALTER

ADDRESS: PO Box 89, Glenelg, MD 21737 PHONE NUMBER: 410-531-2939

SUBDIVISION: Braeburn LOT NUMBER: 24

ADDRESS: 10822 Braeburn Road PROPERTY OWNER: James Williams

SEPTIC TANK CAPACITY (GALLONS): Existing Trenches 2' Wide
 PUMP CHAMBER CAPACITY (GALLONS): N/A Inlet 5.5' - 6'
 NUMBER OF BEDROOMS: 3 Bottom 11' - 11.5'
 SQUARE FEET PER BEDROOM: 210 5.5' of Stone Below Pipe
 LINEAR FEET OF TRENCH REQUIRED: 98' 2 Trenches around 49' Long


TRENCHES:	Trench to be _____ feet wide. Inlet _____ feet below original grade. Bottom maximum depth _____ feet below original grade. Effective area begins at _____ feet below original grade. _____ feet of stone below distribution pipe.
LOCATION:	<u>Raise Manhole Cleanout on Tank, Future Repairs Will Require Pump</u>
PURPOSE:	Existing septic system has failed. Call for inspection when ground is opened so sanitarian can recommend repair.

PLANS APPROVED: _____ DATE: _____

- NOTE: PERMIT VOID AFTER 2 YEARS
- NOTE: CONTRACTOR RESPONSIBLE FOR SCHEDULING A PRE-CONSTRUCTION INSPECTION FOR ALL INSTALLATIONS
- NOTE: WATERTIGHT SEPTIC TANKS REQUIRED
- NOTE: ALL PARTS OF SEPTIC SYSTEM SHALL BE 100 FEET FROM ANY WATER WELL
- NOTE: MANHOLE RISERS REQUIRED ON ALL SEPTIC TANKS AND PUMP CHAMBERS

**NEITHER THE HOWARD COUNTY COUNCIL OR THE HEALTH DEPARTMENT IS
 RESPONSIBLE FOR THE SUCCESSFUL OPERATION OF ANY SYSTEM
 PERMITTEE RESPONSIBLE FOR OBTAINING FINAL APPROVAL ON THIS PERMIT
 CALL 410-313-2640 FOR INSPECTION OF SEPTIC SYSTEM**

P 523648

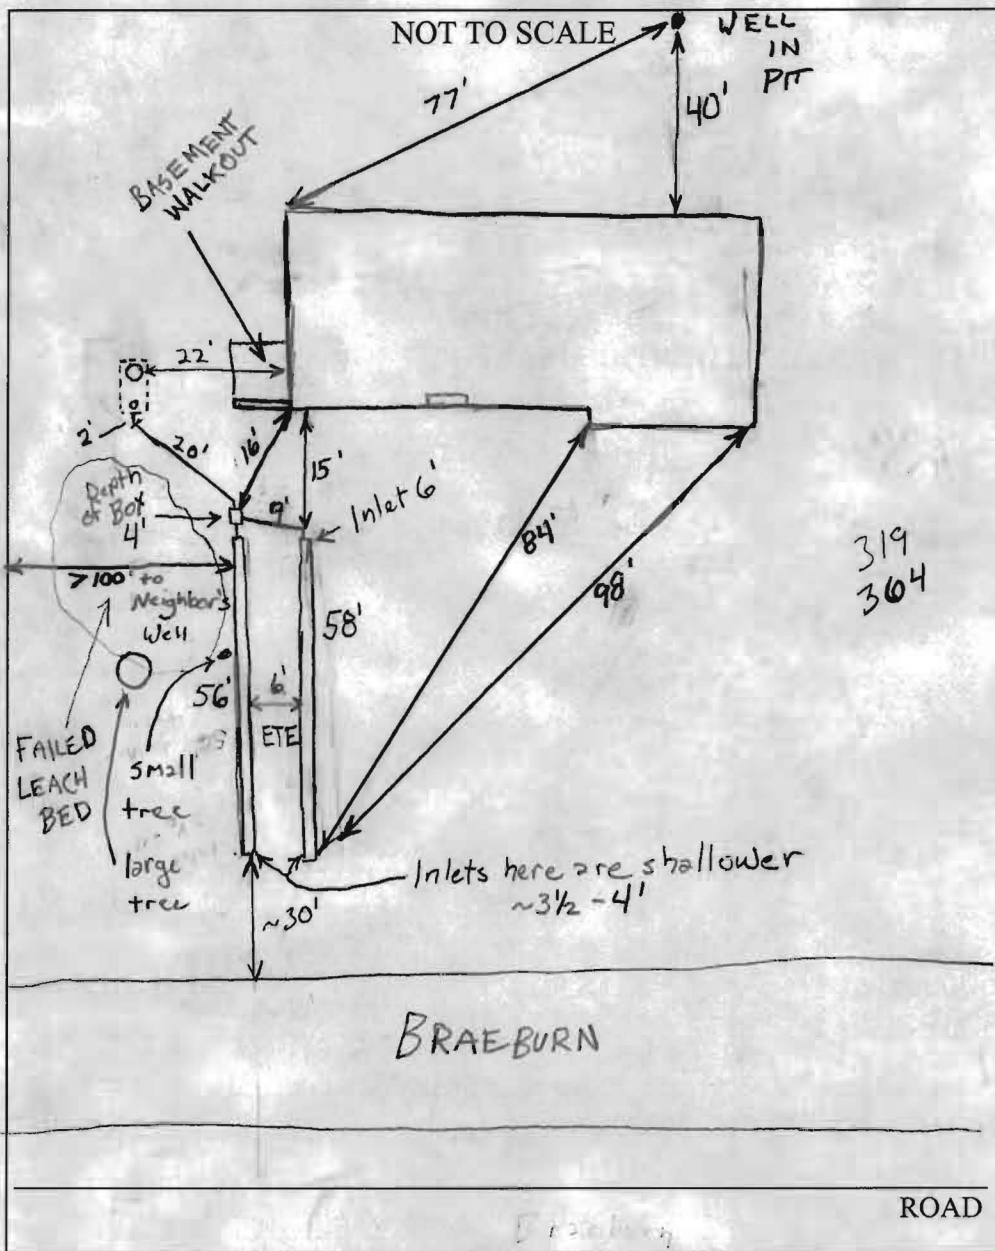

TRENCH/DRAINFIELD DATA		
WIDTH	INLET	BOTTOM
2	-4-6	1 1/2
NUMBER OF TRENCHES		2
TOTAL LENGTH		114'
ABSORPTION AREA		683 sf + bottom
DISTRIBUTION BOX LEVEL		Yes
DISTRIBUTION BOX BAFFLE		Block
DISTRIBUTION BOX PORT		No

SEPTIC TANK DATA	
SEPTIC TANK 1 LEVEL	N/A
Existing Capacity	1250? GAL
SEAM LOC	MID?
TANK LID DEPTH	~1'
BAFFLES	
BAFFLE FILTER	
MANHOLE LOC	Inlet
6" PORT LOC	Outlet
WATERTIGHT TEST	N/A
SEPTIC TANK 2 LEVEL	
CAPACITY	_____ GAL
SEAM LOC	_____
TANK LID DEPTH	_____
BAFFLES	_____
BAFFLE FILTER	_____
MANHOLE LOC	_____
6" PORT LOC	_____
WATERTIGHT TEST	_____

PRE-CONSTRUCTION 2 trenches installed along w/ new line from
 INSTALLATION Septic tank and Distribution box - trenches are running
directly through perched area, Trenches not quite on
contour but inlets are deep enough that this won't be a problem.
OK to cover. Told Robert Fyock to raise lid on manhole ~3"
or so to bring it above grade due to topographically low location
of tank in man-made swale or basement walkout. (GAC)

FINAL INSPECTOR Salvad A. Crighton DATE OF APPROVAL 12/15/05



HOWARD COUNTY HEALTH-DEPARTMENT

P5 23648

DATE
11 / 15 / 05

Received From

Fyocke Septic Service Inc

PHONE # *410-531-2939*

PO Box 89, Glenelg MD 21737

CASH
 CHECK

For *Repair Pump + Repair Perch*

10822 Braeburn Road

NO.

1629

Three hundred thirty and 00/100

Dollars

\$

330

PO

Received By

Mary R. Bugge