

LAYOUT _____ INSP 4 _____

INSP 2 _____ INSP 5 _____

INSP 3 _____ INSP 6 _____

ISSUE DATE: _____

APPROVAL DATE: _____

PERMIT

INDEXED

TAX ID # 05-349079

ON-SITE SEWAGE DISPOSAL SYSTEM HOWARD COUNTY HEALTH DEPARTMENT BUREAU OF ENVIRONMENTAL HEALTH

P _____

A 523561

IS PERMITTED TO INSTALL ALTER

ADDRESS: _____ PHONE NUMBER: _____

SUBDIVISION: _____ LOT NUMBER: _____

ADDRESS: 13615 Nichols Drive PROPERTY OWNER: Felix Njeh

SEPTIC TANK CAPACITY (GALLONS): _____ OUTLET BAFFLE FILTER REQUIRED

PUMP CHAMBER CAPACITY (GALLONS): _____ COMPARTMENTED TANK REQUIRED

NUMBER OF BEDROOMS: _____

SQUARE FEET PER BEDROOM: _____

LINEAR FEET OF TRENCH REQUIRED: _____

TRENCHES:	Trench to be _____ feet wide. Inlet _____ feet below original grade. Bottom maximum depth _____ feet below original grade. Effective area begins at _____ feet below original grade. _____ feet of stone below distribution pipe.
LOCATION:	
NOTES:	

PLANS APPROVED: _____ DATE: _____

NOTE: PERMIT VOID AFTER 2 YEARS

NOTE: CONTRACTOR RESPONSIBLE FOR SCHEDULING A PRE-CONSTRUCTION INSPECTION FOR ALL INSTALLATIONS

NOTE: WATERTIGHT SEPTIC TANKS REQUIRED

NOTE: ALL PARTS OF SEPTIC SYSTEM SHALL BE 100 FEET FROM ANY WATER WELL


NOTE: MANHOLE RISERS REQUIRED ON ALL SEPTIC TANKS AND PUMP CHAMBERS UNLESS SPECIFICALLY AUTHORIZED

**NEITHER THE HOWARD COUNTY COUNCIL NOR THE HEALTH DEPARTMENT IS
RESPONSIBLE FOR THE SUCCESSFUL OPERATION OF ANY SYSTEM
PERMITTEE RESPONSIBLE FOR OBTAINING FINAL APPROVAL ON THIS PERMIT
CALL 410-313-2640 FOR INSPECTION OF SEPTIC SYSTEM**

4523561

LH05-67-1020 13615 NICHOLS DR CLARKSVILLE HOW 6/13/05 G00ZM Case#2005-126
 REVISED 6/28/5 DA/CAG
 Fema Panel: 240044 0032B
 Flood Zone: C
 2 PARCELS OF LAND
 CONTAINING 3.087 ACRES + } S/E 1.069 AC
 1.196 ACRES MORE OR LESS }
 Book: 262
 Folio: 103
 Dist: 5
 Co: HOWARD
 MD
 Scale 1" = 60'

LOCATION APPROXIMATE
 NO PIPES FOUND

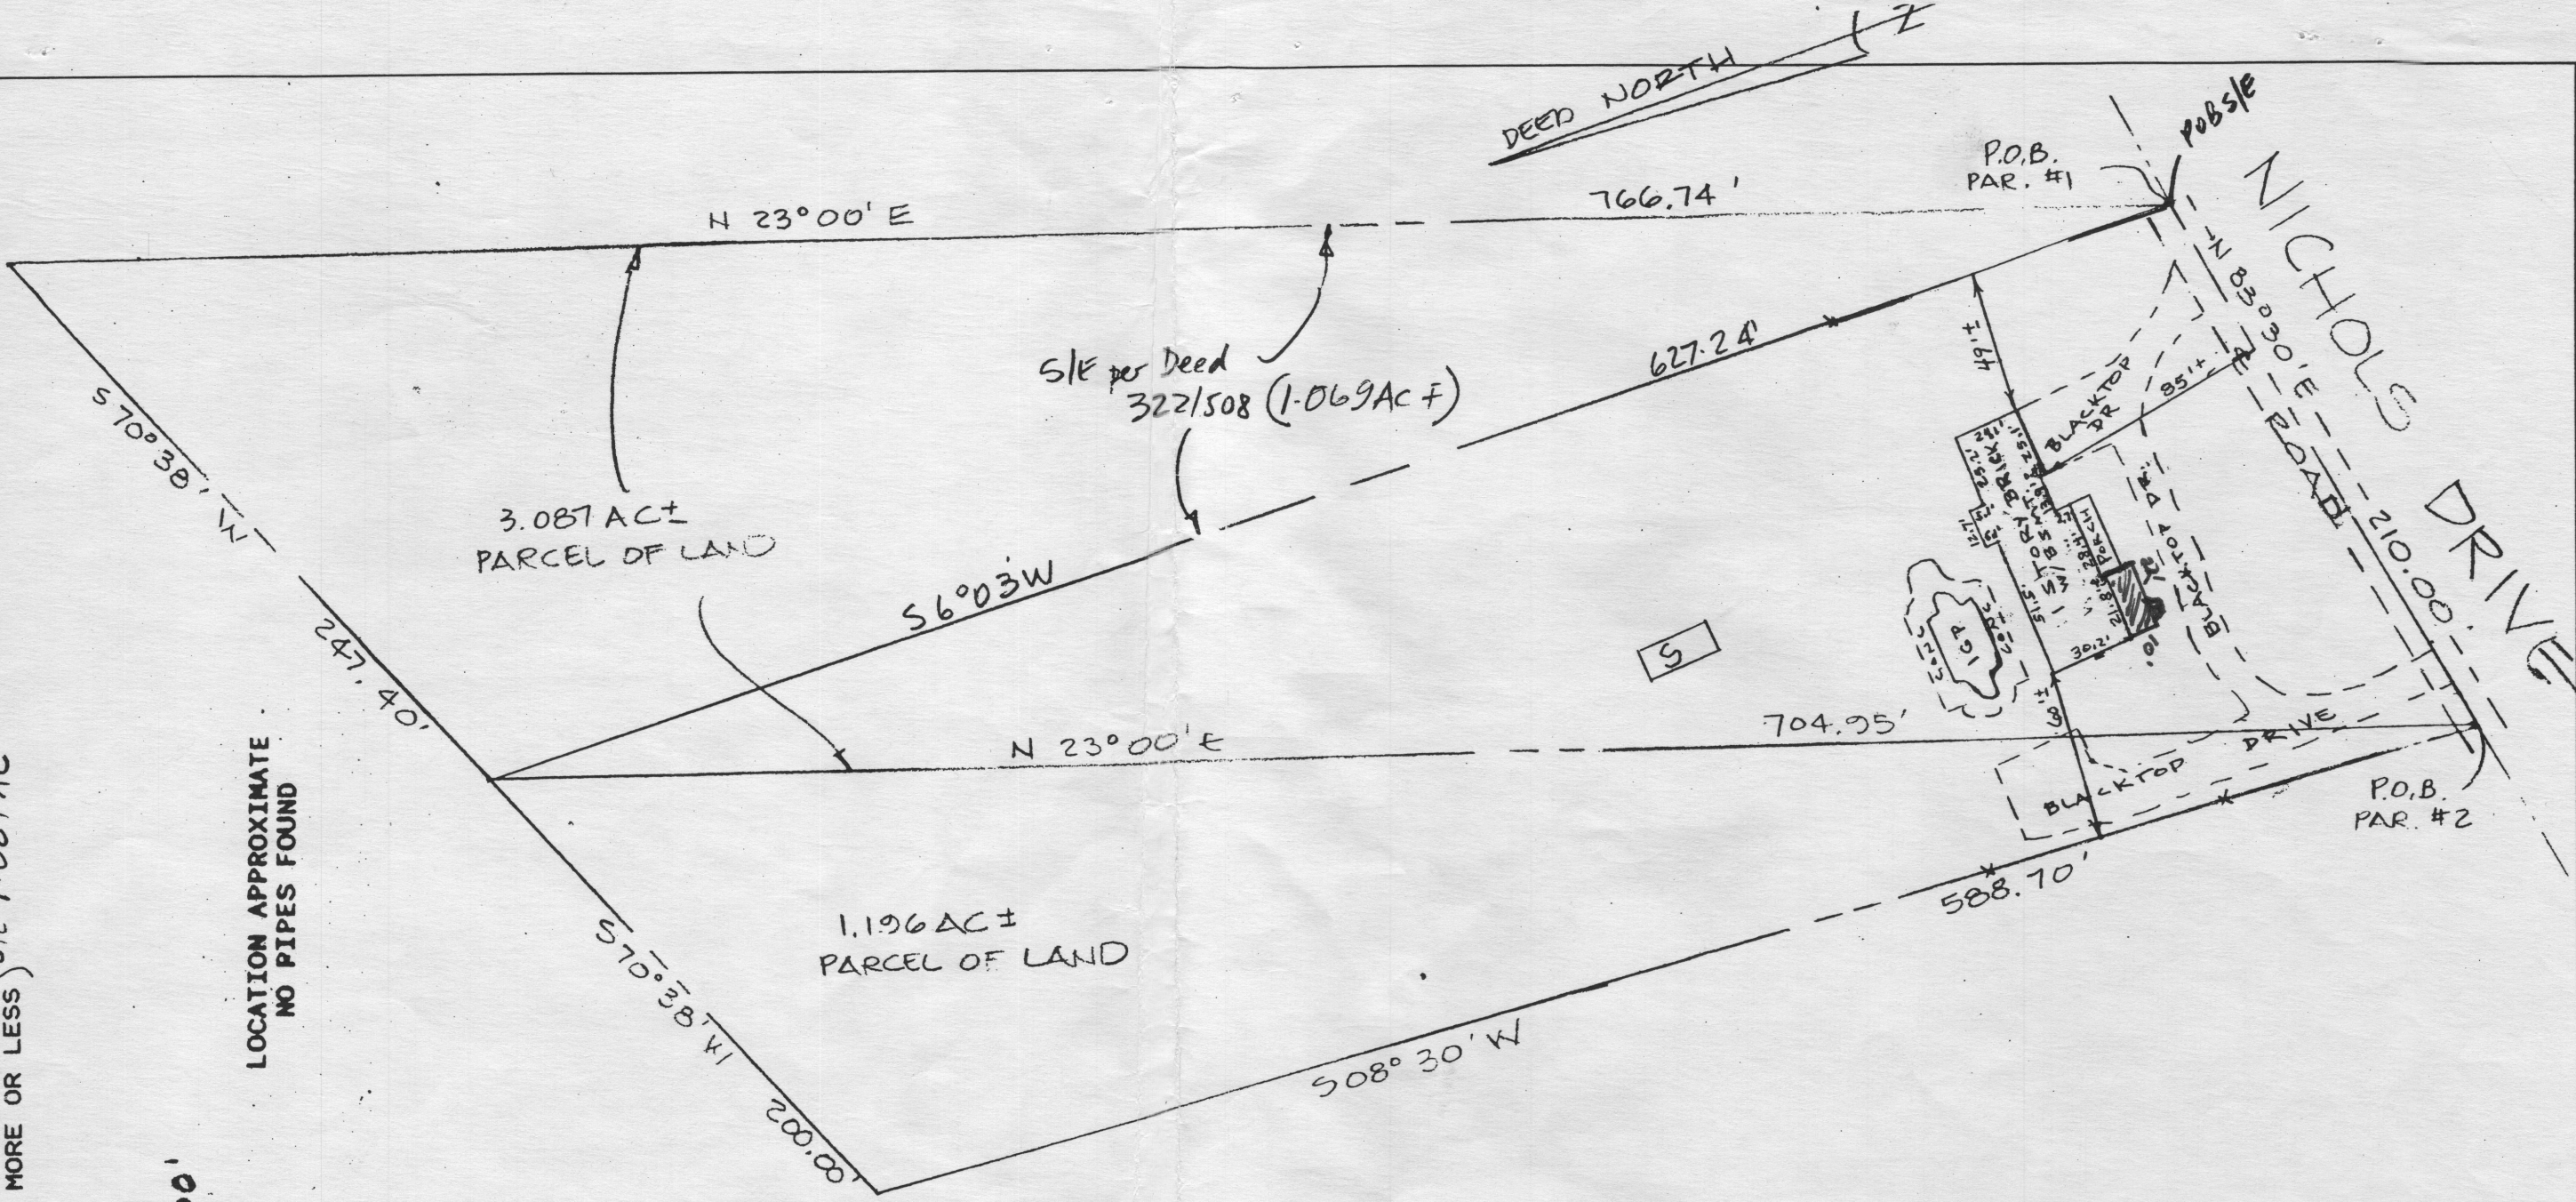

E mail: surveyassociates@erols.com

LOCATION
 MORTGAGE
 SURVEY

Large Lots: Boundaries on larger lots may not all inspected.
 Accuracy: Approximate average accuracy (SD of sideline distances) for small suburban lots is two feet, and for larger lots and metes and bounds parcels varies from two feet to twenty feet or more. In case of doubt, we recommend a boundary Survey.

LEGEND
 Shed (unsurveyed) [S]
 Gravel Drive == == ==
 Blacktop Drive -----
 Concrete =====

This is an improvements Location Survey only, and must not be used for Boundary purposes. No Title Report furnished. No statement is made as to ownership of property or right or interest therein. Fences are approximate only and may not be shown. *Not to be used for construction purposes or permits of any kind whatsoever.*

SURVEY ASSOCIATES
 200 GRAYS ROAD
 HARWOOD, MARYLAND 20776
 TEL 410 266 7211 FAX 410 266 0918
 FAX BALT 410 841 6150