


Lot 7

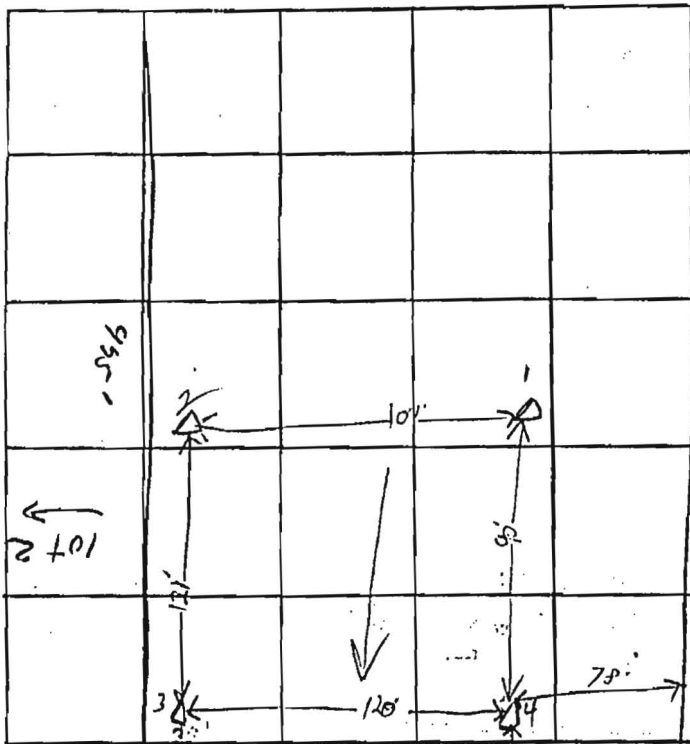

INDICATE NORTH. - NAME ADJOINING ROADWAY AS BASE LINE
 7.0 A⁺ Road B
 7.0 A⁺ Road C

DATE	TEST NO.	DEPTH	PRE-WET		TEST - 1" DROP		TIME
			START	STOP	START	STOP	
8-4-75	L 40	12'	1025	1035	1035	1050	15
	45	5'	1025	1030	1030	1035	5
	L 30	11'	1030	1035	1035	1040	5
	35	3 1/2'	1030	1035	1035	1043	8
	15	12'	1040	1050	1050	1110	20
	10	5'	1041	1048	1048	1100	12
	2	11 1/2'	SILT	LOAM	ALSO SA. & LS OTHERS		

REMARKS _____

TYPE OF SOIL all silt clay

TESTED BY Z. B. O. N. II ALSO PRESENT: _____

Lot 8

12 min. 0.2