

10/13/78

04-337867

Approved (626)
200-178

PERMIT

P 28997
A 21809

SEWAGE DISPOSAL SYSTEM

MARYLAND STATE DEPARTMENT OF HEALTH*

HOWARD COUNTY

803015600

ELLICOTT CITY

DISTRICT 4th

INDEXED

DATE 10/5/78

Robert Orndorff Ortingham IS PERMITTED TO INSTALL X ALTER

ADDRESS _____ PHONE _____

SUBDIVISION Rover Hill Estates ROAD 3155 Danmark Drive LOT 7, Sec. 1

PROPERTY OWNER Nichol Duckert Kenneth Kraak

BUILDING PERMIT SIGNED

ADDRESS 3 bedrooms - 1000 gal. tank
4 bedrooms - 1250 gal. tank

AND RETURNED

SPECIFICATIONS

10/13/05 B00156611 - GARAGE

9F3

SEPTIC TANK CAPACITY _____ GALLONS
DRAIN FIELD _____ DEPTH _____ FEET, BOTTOM AREA _____ SQ. FT.
DEEP TRENCH _____ DEPTH _____ FEET, BOTTOM AREA _____ SQ. FT.
SEEPAGE PITS _____ ABSORBENT SIDE-WALL AREA 236 SQ. FT. total area in dry well.
INLET PIPE 4 FT. BELOW ORIGINAL GRADE. MAXIMUM DEPTH 9 FT. BELOW ORIGINAL GRADE
EFFECTIVE DEPTH AT _____ FT. BELOW ORIGINAL GRADE.
LOCATE DISPOSAL AREA _____ FT. FROM _____ LOT LINE AND _____ FT. FROM _____ LOT LINE AS SEEN WHEN
FACING LOT FROM

Locate the dry well 145 ft. from road, and 100 ft. from left (475') lot line.

Absorbent area/bedroom - 175 sq. ft. Trench to be: 4 bedrooms - 2 trenches, one

95 ft. long and one 30 ft. long, 3 bedrooms - trench to be 75 ft. long. Inlet

to be 4 ft. and maximum depth 9 ft. Trench to run on contour towards lot 8, 485 ft. lot line.

PLANS APPROVED BY David J. O'Neill DATE 12/5/77

COVER NO WORK UNTIL INSPECTED AND APPROVED.

NEITHER THE HOWARD COUNTY COUNCIL NOR THE HEALTH DEPARTMENT IS RESPONSIBLE FOR THE SUCCESSFUL OPERATION OF ANY SYSTEM.

NOTE: IF TRENCH IS USED CALL FOR INSPECTION BEFORE PLACING GRAVEL IN TRENCH.

NOTE: NO DRY WELL SHALL EXCEED 16 FOOT IN DIAMETER.

NOTE: ALL PIPE FROM HOUSE TO DISPOSAL AREA MUST BE CAST IRON.

PERMIT VOID AFTER THREE YEARS.


NOTE: INSTALL STAND PIPE ON SEPTIC TANK AND DRY WELL. STAND PIPES MUST BE 8 INCHES IN DIAMETER. CAST IRON, CONCRETE OR TERRA COTTA ACCEPTED.

***INSTALLER IS RESPONSIBLE FOR OBTAINING FINAL APPROVAL ON THIS PERMIT.**

HD - 23

A21809

H 5 2 3 6 2 3 - A

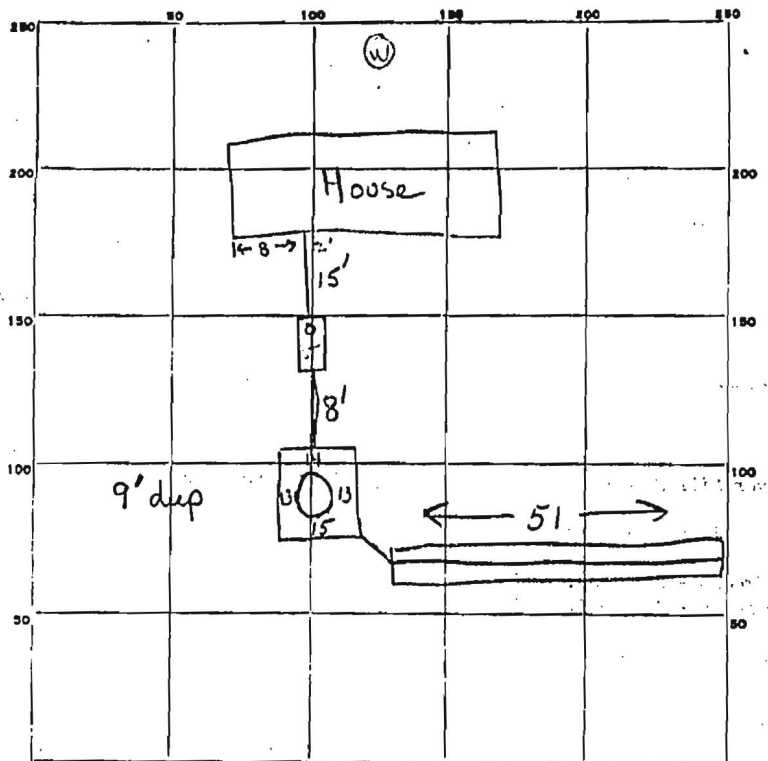

INDICATE NORTH. - NAME ADJOINING ROADWAY AS BASE LINE.
 work present 20 Oct 78 DANMARK

PERMIT CARD _____

SEPTIC TANK, LEVEL _____

DISTRIBUTION BOX, LEVEL Na _____

TILE FIELD, DEPTH 9 FT. TRENCH WIDTH 2 FT.

GRAVEL DEPTH 5 FT. TOTAL LENGTH 51 FT. 255

NUMBER OF TRENCHES 3 TOTAL BOTTOM AREA 255

SEEPAGE PITS, INSIDE DIAMETER 55 FT. DEPTH BELOW INLET 275 FT. 275

ABSORBENT AREA 530 SQ. FT. 530

REMARKS 13 Oct 78 - Call for final when septic tank is installed, work on drywell complete & when gravel is added to trench (GLK)

20 Oct 78 - Call for final when work on septic, drywell & trenches is complete (GLK)

30 Oct 78 - FINAL OK (GLK)

DATE SYSTEM APPROVED 20 Oct 78 INSPECTOR J. Keller

