

05-367921

12/16/64

PERMIT

Approved

10/16/64

P 08098

R.F.

A 08734

SEWAGE DISPOSAL SYSTEM

MARYLAND STATE DEPARTMENT OF HEALTH

HOWARD COUNTY

INDEXED

ELLICOTT CITY

DISTRICT 5

DATE 9/16/64

Elwood Scaggs IS PERMITTED TO INSTALL X ALTER

ADDRESS Laurel, Maryland PHONE PA 5-0324

A SEWAGE DISPOSAL SYSTEM LOCATED AT _____

SUBDIVISION _____ ROAD 6832 Mink Hollow LOT _____

PROPERTY OWNER ~~Wm. K. Solder~~ Wm. Kowgios Wm. Boesche

ADDRESS Mink Hollow Rd., Highland, Maryland

SPECIFICATIONS 4 bedrooms

DRAIN FIELD _____ DEPTH _____ FEET, BOTTOM AREA _____ SQ. FT.

SEEPAGE PITS _____ ABSORBENT SIDE-WALL AREA _____ SQ. FT.

SEPTIC TANK CAPACITY 1000 GALLONS

FOR GARBAGE GRINDER, INCREASE DISPOSAL AREA 22% & TANK CAPACITY 50%.

OTHER Dry well - 400 sq. ft. absorbent side wall area below inlet pipe. Locate dry well 130 ft. from front lot line and 290 ft. from left side line as lot is seen when you face it from the blue chip road that fronts the lot.

PLANS APPROVED BY R. D. Fletcher DATE 7/14/64

FILL SEPTIC TANK AND DISTRIBUTION BOX WITH WATER BEFORE CALLING FOR AN INSPECTION. COVER NO WORK UNTIL INSPECTED AND APPROVED.

NEITHER THE HOWARD COUNTY COMMISSIONERS NOR THE HEALTH DEPARTMENT IS RESPONSIBLE FOR THE SUCCESSFUL OPERATION OF ANY SYSTEM.

BLDG. PERMIT SIGNED AND RETURNED 12/16/64
Serial # 35788
Pink + deck

08734


A 5 2 3 6 2 3

BUILDING PERMIT SIGNED

AND RETURNED

10/19/65 B00156601 - Rue Baer

A 08734

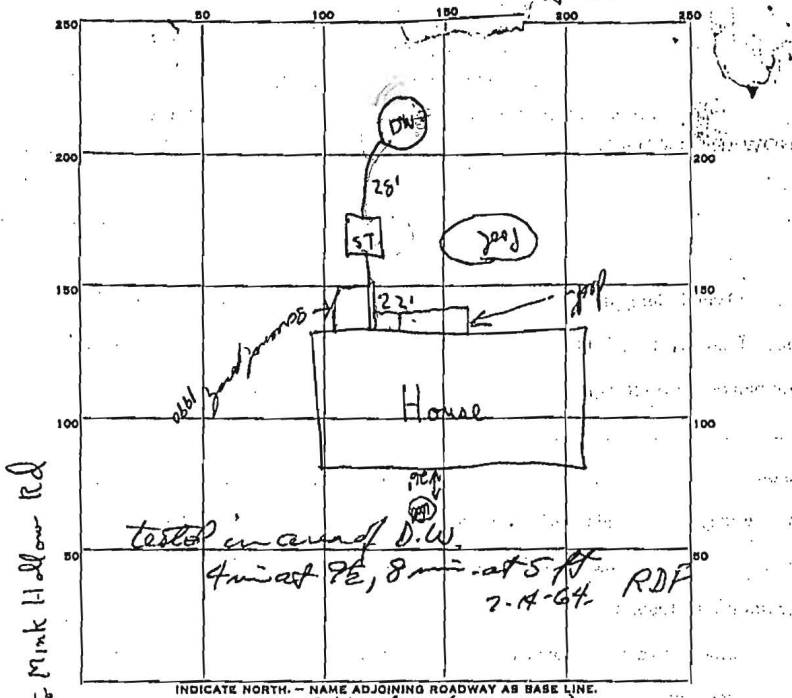

PERMIT CARD OK

SEPTIC TANK, LEVEL _____ CLEANOUTS _____

DISTRIBUTION BOX, LEVEL _____

TILE FIELD, DEPTH _____ FT. TRENCH WIDTH _____ FT.

GRAVEL DEPTH _____ IN. TOTAL LENGTH _____ FT.

NUMBER OF TRENCHES _____ TOTAL BOTTOM AREA _____

SEEPAGE PITS, INSIDE DIAMETER 12 FT. DEPTH BELOW INLET 9 FT.

ABSORBENT AREA 340 SQ. FT.

REMARKS Dirt Wall to Dirt Wall ϕ 14 ft. x 9 ft. dp = 395 sq. ft.

DATE SYSTEM APPROVED 10/15/64 INSPECTOR R. F. Litcher