

04-312023

*5/10/66  
Ready*

*approved  
5/14/66  
Devon*

# PERMIT

SEWAGE DISPOSAL SYSTEM

P 11765

A 11319

MARYLAND STATE DEPARTMENT OF HEALTH

HOWARD COUNTY

INDEXED

ELLICOTT CITY

DISTRICT 4

DATE 4/28/66

Clements A. Schepar IS PERMITTED TO INSTALL X ALTER

ADDRESS 9331 Liberty Rd., Randallstown, Md. PHONE 922-4110

A SEWAGE DISPOSAL SYSTEM LOCATED AT \_\_\_\_\_

SUBDIVISION \_\_\_\_\_ ROAD 4320 Rt 97 LOT \_\_\_\_\_  
Rt. 97 & Roxbury

PROPERTY OWNER Eugene Connor ~~Robt Taylor~~ Robert Burgess  
Mill Rd.

ADDRESS \_\_\_\_\_

SPECIFICATIONS - 3 bedrooms

DRAIN FIELD \_\_\_\_\_ DEPTH \_\_\_\_\_ FEET, BOTTOM AREA \_\_\_\_\_ SQ. FT.

SEEPAGE PITS \_\_\_\_\_ ABSORBENT SIDE-WALL AREA \_\_\_\_\_ SQ. FT.

SEPTIC TANK CAPACITY 750 GALLONS

FOR GARBAGE GRINDER, INCREASE DISPOSAL AREA 22% & TANK CAPACITY 50%.

OTHER Dry well 10 ft. in dia. by 10 ft. deep below the inlet located  
187 ft. from the rear property line and 278 ft. off the right side  
property line as seen when facing the lot from Roxbury Mill Road.  
Locate inlet pipe 3 ft. below original grade.

PLANS APPROVED BY J. Hennigan DATE 10/10/65


FILL SEPTIC TANK AND DISTRIBUTION BOX WITH WATER BEFORE CALLING FOR AN INSPECTION. COVER NO WORK UNTIL INSPECTED AND APPROVED.

NEITHER THE HOWARD COUNTY COMMISSIONERS NOR THE HEALTH DEPARTMENT IS RESPONSIBLE FOR THE SUCCESSFUL OPERATION OF ANY SYSTEM.

*A 11319*

*A 523617*

BUILDING PERMIT SIGNED  
AND RETURNED  
STUDIOS B00156737 - SCREENED PORCH

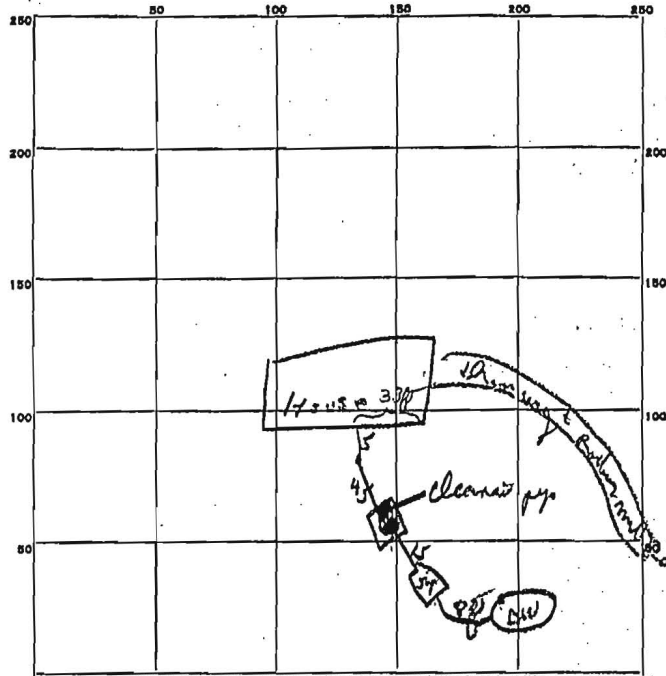

PERMIT CARD OK

SEPTIC TANK, LEVEL OK CLEANOUTS OK

DISTRIBUTION BOX, LEVEL \_\_\_\_\_

TILE FIELD, DEPTH \_\_\_\_\_ FT. TRENCH WIDTH \_\_\_\_\_ FT.

GRAVEL DEPTH \_\_\_\_\_ IN. TOTAL LENGTH \_\_\_\_\_ FT.

NUMBER OF TRENCHES \_\_\_\_\_ TOTAL BOTTOM AREA \_\_\_\_\_

SEEPAGE PITS, INSIDE DIAMETER 12 FT. DEPTH BELOW INLET 10 FT.

ABSORBENT AREA 376 SQ. FT.

REMARKS 5/1/66 add pipe installation

\_\_\_\_\_

\_\_\_\_\_

\_\_\_\_\_

DATE SYSTEM APPROVED 13 20 3/18/66 INSPECTOR John M. [Signature]

Sep. 28, 1999 8:36PM

MD SEWER CONTROL

No. 1118 P. 2/4

E.P.R. Plumbing, Inc.  
MDE #0204-00182

Severn Professional Complex, Suite 201-B  
3336 Veterans Hwy., Millersville, MD 21108  
410-987-5757 / FAX 410-987-7514

LOCATION: 4320 Rt 97, Glenwood, MD 21738

	YES	NO
1. ANY SEWER GAS NOTICEABLE ON THE PROPERTY?	[ ]	[X]
2. ANY EVIDENCE OF A PRIOR SEWER BACKUP?	[ ]	[X]
3. ANY EVIDENCE OF SLOW DRAINAGE?	[ ]	[X]
4. AFTER RUNNING THE WATER FOR 30 MINUTES AND FLUSHING THE TOILET, IS THERE ANY EVIDENCE OF A BACKUP?	[ ]	[X]
5. DOES THE LAWN OVER THE SEPTIC TANK APPEAR TO HAVE BEEN DUG UP OR DISTURBED RECENTLY?	[ ]	[X]
6. DOES THE AREA OVER THE SEPTIC TANK APPEAR WET OR SOGGY?	[ ]	[X]
7. IS THE SYSTEM PROPERLY POSITIONED, i.e. NOT PLACED NEAR AN IN-GROUND POOL OR GROUND WELL?	[X]	[ ]
8. DO YOU RECOMMEND FURTHER ANALYSIS?	[ ]	[X]
9. ON THIS DATE THE SYSTEM APPEARS TO BE FUNCTIONING PROPERLY.	[X]	[ ]

Based on today's observations, the information provided by the owner(s) or their agent, EPR submits the sub-surface sewage disposal system inspection. The inspection is based on the current condition of the onsite sewage disposal system. EPR has not been retained to warrant, guarantee, or certify the proper functioning of the system for any period of time. Because of numerous factors (age, soil type, installation and maintenance etc.) which effect the proper operation sub-surface disposal system as well as the inability of EPR to supervise or monitor the and maintenance of the system; this report shall not be construed as a warranty by EPR that the system will function properly for any prospective buyer. EPR disclaims any warranty, either expressed or implied, arising from the inspection of the septic system. This is to certify a visual inspection of the septic tank was conducted on this date.

COMMENTS:

INSPECTOR:

*Andy J. J...*

Date

9-27-99