

PR 9/20/05
not issued

Sept. 23, 2005

Dear Mrs. Corbin:

We wish to amend building permit

B0015~~09~~ 3097 for 16076B

A.E. Mullinix Rd., Woodlawn, MD 21797

we reduced the size of the apartment

by 33.9 sq. ft. to 749 sq. ft. from 782 sq. ft.

(see attached floor plan)

9/29/05


finish Basement w/ one
new bedroom - OK they have
a 1500 gal tank

(KJB)

Sincerely,
Jeanne Faye Moore
301-854-6786

cc: Health Dept
DPZ

(Utility room not included)

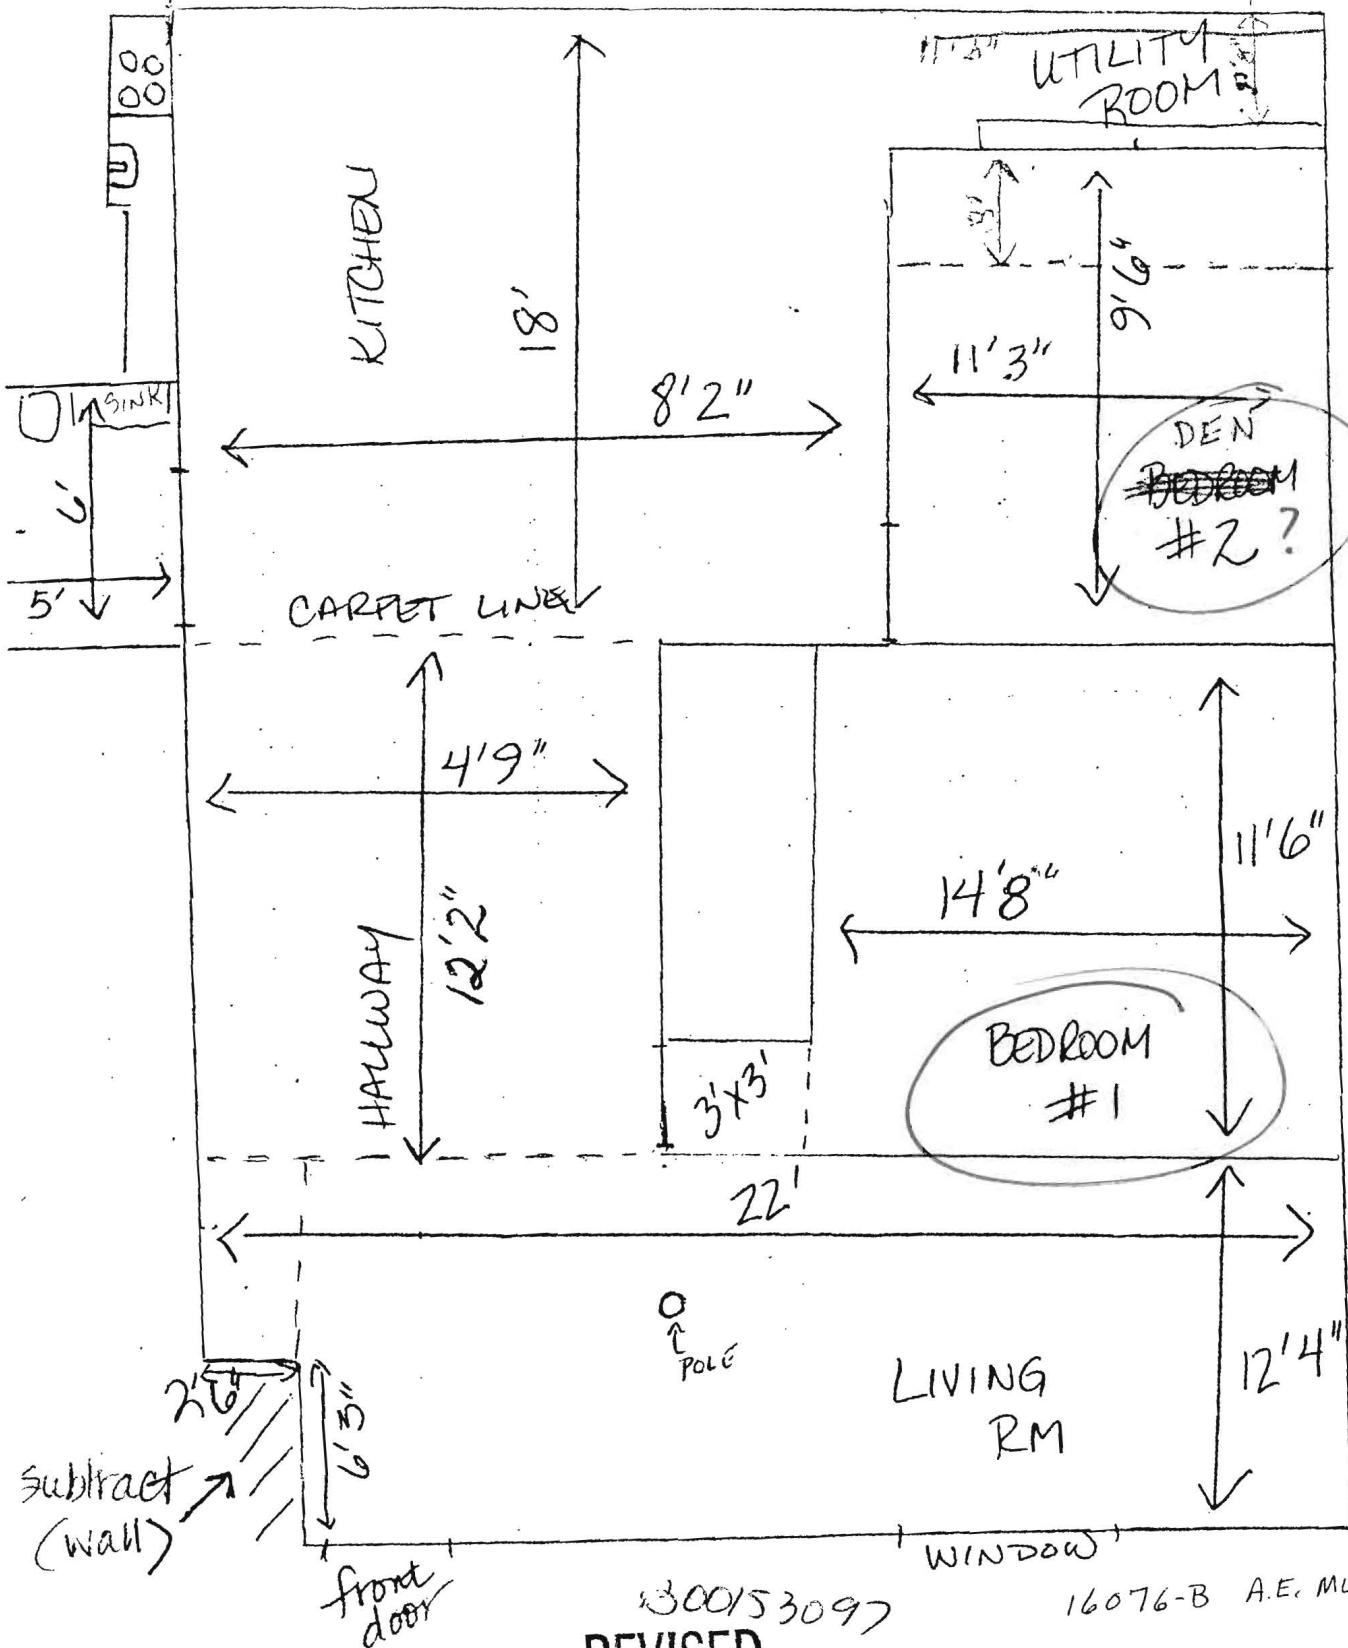

300153097

16076-B A.E. MULLINIX ROAD

REVISED

Date: 9.23.05

Comments: ~~from~~ Revised - reduced size layout