


130'±

APPROVED
WALK-THRU BUILDING PERMIT
 BP# 6001561094 A# N/A.
 APP. SAN PAY DATE: 10/24/05
 DESC. OF WORK: SUNROOM
 18x18 Sunroom + Brick Pat's
 Shed roof covering
 Stairway existing

(Seepection sheet)

TAX MAP No. 13
PARCEL 239
BLOCK 2

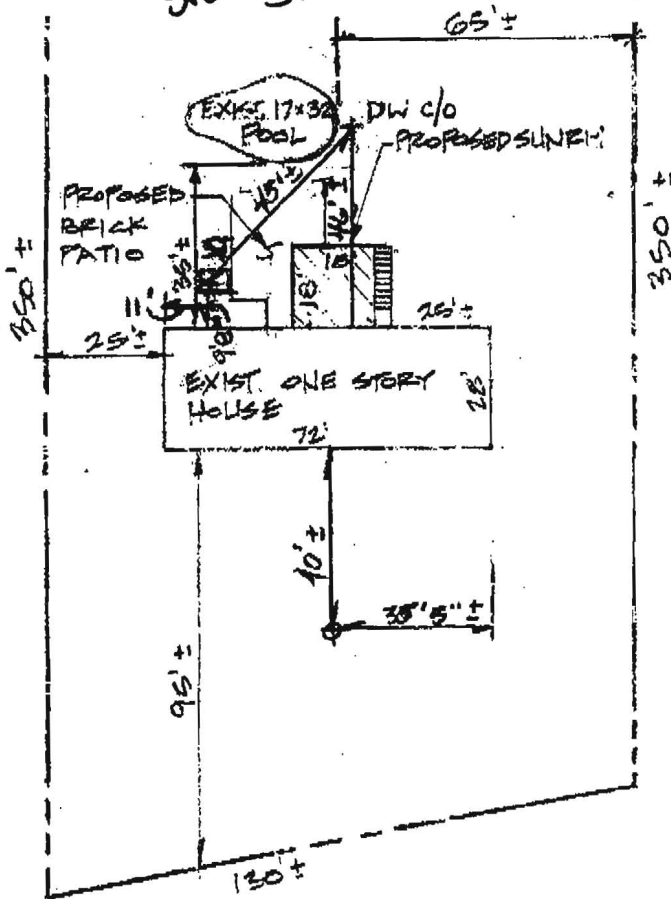

FLORENCE RD

OWNER: MOHNEY

PLOT PLAN

1"=40'