

STATE OF MARYLAND  
 WATER RESOURCES ADMINISTRATION  
 TAWES STATE OFFICE BLDG., ANNAPOLIS, MD. 21401  
**WELL COMPLETION REPORT**

THIS REPORT MUST BE SUBMITTED WITHIN 30 DAYS AFTER WELL COMPLETION  
 FILL IN THIS FORM COMPLETELY  
 COUNTY NUMBER \_\_\_\_\_  
 PERMIT NO. FROM "PERMIT TO DRILL WELL" MO-35-7749  
 28 29 30 31 32 33 34 35 36 37  
 DRILLERS IDENTIFICATION NO. 42

DATE RECEIVED (WRA USE ONLY) \_\_\_\_\_  
 DATE WELL COMPLETED Nov. 7 - 1975  
 DEPTH OF WELL 120  
 (TO NEAREST FOOT) 20  
 OWNER Deane Building  
 LAST NAME Deane FIRST NAME Deane  
 STREET OR RFD. 3712 Pe. Ct POST OFFICE Baltimore Md.

**WELL LOG**  
 STATE THE KIND OF FORMATIONS PENETRATED, THEIR COLOR, DEPTH, THICKNESS AND IF WATER BEARING

DESCRIPTION (USE ADDITIONAL SHEETS IF NECESSARY)	FEET FROM	TO	CHECK IF WATER BEARING
Sandy Soil	0	2	
Brown Shale	2	11	
Red stone	11	30	
Mica	30	40	
Sandstone	40	50	
Mica	50	120	

**GROUTING RECORD**  
 WELL HAS BEEN GROUTED (CIRCLE APPROPRIATE BOX)  Y  N  
 TYPE OF GROUTING MATERIAL (CIRCLE BOX)  C  M  
 CEMENT  BENTONITE CLAY  C  
 NO. OF BAGS 5 NO. OF POUNDS 500  
 GALLONS OF WATER 30  
 DEPTH OF GROUT SEAL (TO NEAREST FOOT)  
 FROM 0 FT. TO 20 FT.  
 (ENTER 0 IF FROM SURFACE)


**CASING RECORD**  
 MAIN CASING TYPE  S  T  
 NOMINAL DIAMETER TOP (MAIN) CASING (NEAREST INCH) 6  
 TOTAL DEPTH OF MAIN CASING (NEAREST FOOT) 24  
 OTHER CASING (IF USED)  
 DIAMETER (INCH) \_\_\_\_\_ DEPTH (FEET) FROM \_\_\_\_\_ TO \_\_\_\_\_

**SCREEN RECORD**  
 SCREEN TYPE OR OPEN HOLE  S  T  B  H  O  
 STEEL OR BRASS OPEN HOLE  
 PLASTIC OTHER  
 C 2  
 1 2 3 (SEQ. NO.) 6  
 DEPTH (NEAREST WHOLE FOOT)  
 1 HO 20 120  
 2 \_\_\_\_\_  
 3 \_\_\_\_\_  
 38 39 41 40 47 51  
 SLOTSIZE 1. \_\_\_\_\_ 2. \_\_\_\_\_ 3. \_\_\_\_\_

**PUMPING TEST**  
 HOURS PUMPED (TO NEAREST HOUR) 2  
 PUMPING RATE (GALLONS PER MINUTE TO NEAREST GALLON) 10  
 METHOD USED TO MEASURE PUMPING RATE Bucket  
 WATER LEVEL (DISTANCE FROM LAND SURFACE)  
 BEFORE PUMPING 40 (NEAREST FOOT)  
 WHEN PUMPING 120 (NEAREST FOOT)  
 TYPE OF PUMPED USED (CIRCLE APPROPRIATE BOX) (FOR PUMPING TEST)  
 A AIR  P PISTON  T TURBINE  
 C CENTRIFUGAL  R ROTARY  O OTHER (DESCRIBE BELOW)  
 J JET  S SUBMERSIBLE

**PUMP INSTALLED**  
 TYPE OF PUMP (WRITE APPROPRIATE LETTER IN BOX - SEE ABOVE: A, C, J, P, R, S, T, O) \_\_\_\_\_  
 DRILLER WILL INSTALL PUMP (CIRCLE APPROPRIATE BOX)  Y  N  
 CAPACITY:  
 GALLONS PER MINUTE (TO NEAREST GALLON) \_\_\_\_\_  
 PUMP HORSE POWER \_\_\_\_\_  
 PUMP COLUMN LENGTH (NEAREST FOOT) \_\_\_\_\_

**CASING HEIGHT** (CIRCLE APPROPRIATE BOX AND ENTER CASING HEIGHT)  
 + ABOVE  - BELOW  
 LAND SURFACE 2 (NEAREST FOOT)  
 49 50 51

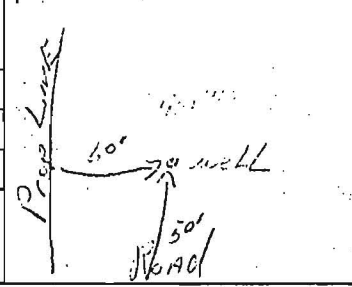

**CIRCLE APPROPRIATE BOXES**  
 A WELL WAS ABANDONED AND SEALED WHEN THIS WELL WAS COMPLETED  
 E ELECTRIC LOG OBTAINED  
 P TEST WELL CONVERTED TO PRODUCTION WELL  
 I HEREBY CERTIFY THAT I HAVE COMPLIED WITH ALL CONDITIONS STATED ON THE ABOVE-CAPTIONED "PERMIT TO DRILL WELL", AND THAT INFORMATION CONTAINED IN THIS REPORT IS TRUE, ACCURATE, AND COMPLETE TO THE BEST OF MY KNOWLEDGE, INFORMATION AND BELIEF.  
 DRILLERS NAME \_\_\_\_\_  
 (PLEASE PRINT) L. K. Carter  
 SIGNATURE S. Mastaglio

DIAMETER OF SCREEN \_\_\_\_\_ (NEAREST INCH)  
 FROM \_\_\_\_\_ TO \_\_\_\_\_  
 GRAVEL PACK \_\_\_\_\_  
 IF WELL DRILLED WAS A FLOWING WELL CIRCLE BOX  F  W  
 WRA USE ONLY (NOT TO BE FILLED IN BY DRILLER)  
 T  W   
 70 \_\_\_\_\_ 72 \_\_\_\_\_  
 TELESCOPE CASING LOG INDICATOR OTHER DATA AVAILABLE