

APPLICATION

SEWAGE DISPOSAL TESTING

STATE OF MARYLAND - DEPARTMENT OF HEALTH AND MENTAL HYGIENE

HOWARD COUNTY HEALTH DEPARTMENT
ENVIRONMENTAL HEALTH SERVICES
P. O. BOX 476, ELLICOTT CITY, MARYLAND 21043
TELEPHONE: 465-5000, EXT. 356

DISTRICT 3rd
DATE 9-11-74

TO: THE COUNTY HEALTH OFFICER
ELLICOTT CITY, MARYLAND

I, HEREBY, APPLY FOR THE NECESSARY TEST IN ORDER TO CONSTRUCT (OR RECONSTRUCT) A SEWAGE DISPOSAL SYSTEM.

PROPERTY OWNER Briar Hill Corporation
ADDRESS 3901 Gelding Lane Olney, Md 20833 PHONE 301-774-0647

PROPERTY LOCATION:

SUBDIVISION ~~Blackberry Hill~~ Briar Hill LOT NO. 2

ROAD AND DESCRIPTION Blackberry Hill Lane

SIZE OF LOT 70,000 sq ft TYPE BLDG. 4/5BR
NUMBER OF BEDROOMS

IF NOT SINGLE RESIDENCE DESCRIBE N/A

THE SYSTEM INSTALLED UNDER THIS APPLICATION IS ACCEPTABLE ONLY UNTIL PUBLIC FACILITIES BECOME AVAILABLE

SIGNATURE OF APPLICANT Mike Lu Suttler VP

APPROVED BY _____ FOR _____ DATE _____
(KIND OF SYSTEM)

REJECTED BY _____ FOR _____ DATE _____
(KIND OF SYSTEM)


HOLD PENDING FURTHER TESTS _____ DATE _____

REASONS FOR REJECTION OR HOLDING _____

THIS IS NOT A PERMIT

#2

20756

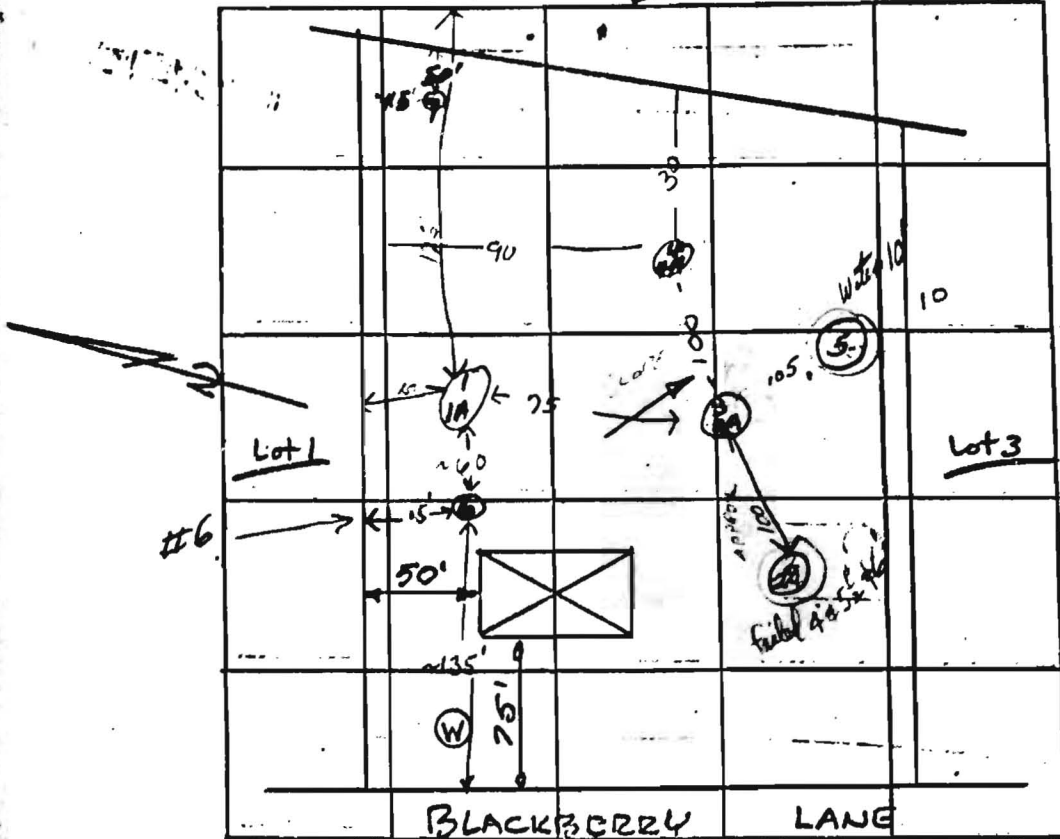

4-17-75
hole #6 - 4' - 8 min
12' - 2 min
#7 - 12' - top 1/2
mixed sand & sh

lot 2

DATE	TEST NO.	DEPTH	PRE-WET		TEST - 1" DROP		TIME
			START	STOP	START	STOP	
10/18/74	1	12 1/2'	MISSING		SAME	SAME	
	1A	5'	(1st test 10/18/74)				
	2	12'	1100	1103	1103	1110	2
	3	12'	1035	1040	1040	1050	10
	3A	4'	1035	1045	1045	1105	20
	4	12 1/2'	1045	1055	1055	1105	10
	1A	6'	1045	1050	1050	1110	20
	2A	4'	1100	NO	PERK	1115	+
	5	10'	WATER AT 10'		GOOD GRIND 3'-9'		White
10/18/74	2B	5 1/2'	1110	NO	PERK	1115	-

Case 1 + 1A
Bored well

1st test

6-8-74 2C

REMARKS

6' 11135 NO PERK
Coffy all holes - need another good hole

TYPE OF SOIL

"a gummy loam"

TESTED BY

ALSO PRESENT: