

LAYOUT _____ INSP 4 _____

INSP 2 _____ INSP 5 _____

INSP 3 _____ INSP 6 _____

ISSUE DATE: _____

APPROVAL DATE: _____

P 40607 _____

A 529038 _____

PERMIT

INDEXED

TAX ID # 05-358671

ON-SITE SEWAGE DISPOSAL SYSTEM HOWARD COUNTY HEALTH DEPARTMENT BUREAU OF ENVIRONMENTAL HEALTH

IS PERMITTED TO INSTALL ALTER

ADDRESS: _____ PHONE NUMBER: _____

SUBDIVISION: Glenelg Manor LOT NUMBER: 7-D

ADDRESS: 12735 Folly Quarter Road PROPERTY OWNER: Sal Bentivenga

SEPTIC TANK CAPACITY (GALLONS): _____ OUTLET BAFFLE FILTER REQUIRED

PUMP CHAMBER CAPACITY (GALLONS): _____ COMPARTMENTED TANK REQUIRED

NUMBER OF BEDROOMS: _____

SQUARE FEET PER BEDROOM: _____

LINEAR FEET OF TRENCH REQUIRED: _____

TRENCHES:	Trench to be _____ feet wide. Inlet _____ feet below original grade. Bottom maximum depth _____ feet below original grade. Effective area begins at _____ feet below original grade. _____ feet of stone below distribution pipe.
LOCATION:	_____
NOTES:	_____

PLANS APPROVED: _____ DATE: _____

NOTE: PERMIT VOID AFTER 2 YEARS

NOTE: CONTRACTOR RESPONSIBLE FOR SCHEDULING A PRE-CONSTRUCTION INSPECTION FOR ALL INSTALLATIONS

NOTE: WATERTIGHT SEPTIC TANKS REQUIRED

NOTE: ALL PARTS OF SEPTIC SYSTEM SHALL BE 100 FEET FROM ANY WATER WELL

NOTE: MANHOLE RISERS REQUIRED ON ALL SEPTIC TANKS AND PUMP CHAMBERS UNLESS SPECIFICALLY AUTHORIZED

NEITHER THE HOWARD COUNTY COUNCIL NOR THE HEALTH DEPARTMENT IS RESPONSIBLE FOR THE SUCCESSFUL OPERATION OF ANY SYSTEM PERMITTEE RESPONSIBLE FOR OBTAINING FINAL APPROVAL ON THIS PERMIT CALL 410-313-2640 FOR INSPECTION OF SEPTIC SYSTEM

A529038

12/7/87
Late SM

+ WPT

12-7-87 Plumber must call for ST clo
installation JEN

PERMIT

SEWAGE DISPOSAL SYSTEM

MARYLAND STATE DEPARTMENT OF HEALTH

HOWARD COUNTY
BUREAU OF ENVIRONMENTAL HEALTH
461-9933

INDEXED
05-358671

P 40607
A 29038
DISTRICT 5th
DATE 12/7/87
DATE SYSTEM APPROVED 12/8/87
INSPECTOR R. Hodges

T.M. Barnard Plumbing & Heating

IS PERMITTED TO INSTALL ALTER

ADDRESS _____ PHONE 461-6599

SUBDIVISION Glenely Manor II ROAD 12735 Folly Quarter LOT 7D & 8A

PROPERTY OWNER Walter Rogers

ADDRESS _____

IF GARBAGE GRINDER IS USED INCREASE SEPTIC TANK CAPACITY BY 50% AND ABSORPTION AREA BY 22%.

GARBAGE GRINDER? YES _____ NO

12-7-87 checked in field JEN

3 bedroom

3600
200 ft trench

SEPTIC TANK CAPACITY 1250 GALLONS NUMBER OF BEDROOMS 3

TRENCHES - 200 sq. ft. per bedroom. Trench to be 3 feet wide. Inlet 4 feet below original grade. Bottom maximum depth 6 feet below original grade. Effective area begins at 4 feet below original grade. 2 feet of stone below distribution pipe.

LOCATION - Place the distribution box 135 feet from the front (270.17') lot line and 15 feet from the right (206.20') lot line as seen when facing the lot from Right-Of-way. Run trenches on contour toward front of lot.

NOTE - No trench to exceed 100 feet in length. Provide 6" - 8" diameter cleanout and cap to grade or above on septic tank. OK 12-4-87 JEN

PLANS APPROVED BY S. Abel DATE 5/22/87

COVER NO WORK UNTIL INSPECTED AND APPROVED.

NEITHER THE HOWARD COUNTY COUNCIL NOR THE HEALTH DEPARTMENT IS RESPONSIBLE FOR THE SUCCESSFUL OPERATION OF ANY SYSTEM.

NOTE: CLEANOUT REQUIRED EVERY 70 FEET OF SEWER LINE AND/OR AT 90° SWEEPS IN LINES FROM HOUSE TO DRAIN FIELDS.

NOTE: ALL PARTS OF SEPTIC SYSTEMS (I.E., TANK, DISTRIBUTION BOX, TRENCHES) TO BE 100 FEET FROM WELL. (UNLESS OTHERWISE SPECIFICALLY AUTHORIZED)

NOTE: IF DEEP TRENCH(IES) ARE USED CALL FOR INSPECTION BEFORE AND AFTER PLACING GRAVEL IN TRENCH(IES).

NOTE: NO DRY WELL SHALL EXCEED 15 FOOT IN DIAMETER. NO ABSORPTION TRENCH TO EXCEED 100 FEET IN LENGTH.

NOTE: ALL PIPE FROM HOUSE TO SEPTIC TANK MUST BE CAST IRON OR SCHEDULE 40 PVC OR ABS.

PERMIT VOID AFTER TWO YEARS.

NOTE: INSTALL STAND PIPE ON SEPTIC TANK AND DRY WELL. STAND PIPES MUST BE 6 INCHES IN DIAMETER. CAST IRON, CONCRETE OR TERRA COTTA OR PVC OR ABS ACCEPTED. IF TOP OF SEPTIC TANK IS DEEPER THAN 3 FEET, MANHOLE TO GRADE REQUIRED.

NOTE: DISTRIBUTION BOXES MUST HAVE BAFFLES.


***INSTALLER IS RESPONSIBLE FOR OBTAINING FINAL APPROVAL ON THIS PERMIT**

*CALL 461-9933 FOR INSPECTION OF SEPTIC SYSTEMS.

EH - 2-1186

A 29038

3:30 pm

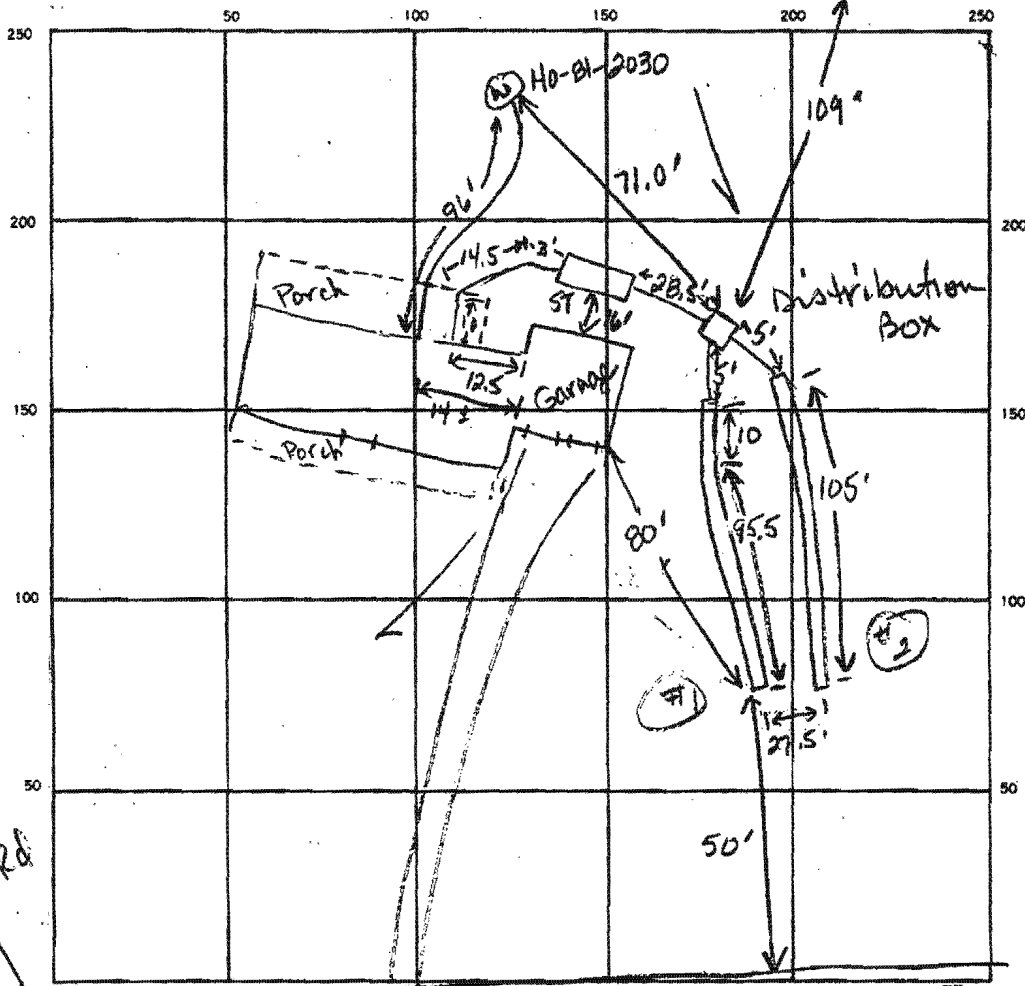

Neighbors well

To Folly Quarter Rd

Access Road

INDICATE NORTH - NAME ADJOINING ROADWAY AS BASE LINE.

32
2.8
123
69
78

21
2.4
8
92
50

SEPTIC TANK. LEVEL 1500 gal CLEANOUTS No clo yet

DISTRIBUTION BOX. LEVEL OK, needs baffle OK

DRAIN FIELD/TILE FIELD. DEPTH 7 7 FT. TRENCH WIDTH 3 FT. INLET DEPTH 3.5 3.5 FT.

EFFECTIVE GRAVEL DEPTH 3.5 3.5 FT. TOTAL LENGTH 105 105 FT.

NUMBER OF TRENCHES 2 ONE SIDEWALL BOTTOM AREA 315 315 SQ. FT.

DRYWELL INSIDE DIAMETER _____ FT. EFFECTIVE DEPTH BELOW INLET _____ FT.

ABSORBENT AREA 630 SQ. FT.

REMARKS 12-787 Need clo on ST, baffle in d. box, trench #1 change 45° curves to 22° bends, add 10 ft onto both trench. OK to cover center of both trenches and lines between house to septic tank, tank to dist. box. Well is ONLY 71 FEET slightly uphill from distribution box. JEN 12-787
OK to cover all work except for clo on septic tank. JEN
cleanout installed on tank but only 4" a 6"

DATE SYSTEM APPROVED 12/28/87 INSPECTOR Raymond Dodge