

PAGE 1

RELIMINARY

APPLICATION

A 28047

SEWAGE DISPOSAL TESTING

P _____

STATE OF MARYLAND - DEPARTMENT OF HEALTH AND MENTAL HYGIENE

DISTRICT 2nd

DATE 5/15/78

HOWARD COUNTY HEALTH DEPARTMENT
ENVIRONMENTAL HEALTH SERVICES
P.O. BOX 476, ELLICOTT CITY, MARYLAND 21043
TELEPHONE: 465-5000, EXT. 356

5/31/78
9:30 A.M.

6/14/78
1:30 P.M.

TO: THE COUNTY HEALTH OFFICER
ELLICOTT CITY, MARYLAND

I, HEREBY, APPLY FOR THE NECESSARY TEST IN ORDER TO CONSTRUCT (OR RECONSTRUCT) A SEWAGE DISPOSAL SYSTEM.

GARTH DAVIS

PROPERTY OWNER Private property

Any questions call John
Schneider: 944-5357

ADDRESS _____ PHONE _____

PROPERTY LOCATION:

SUBDIVISION _____ LOT NO. _____

ROAD AND DESCRIPTION New Cut Road, Ellicott City, Md. Private Rd near

Power Line

SIZE OF LOT ? TYPE BLDG. 3 or 4 bedrooms
NUMBER OF BEDROOMS

IF NOT SINGLE RESIDENCE DESCRIBE _____

THE SYSTEM INSTALLED UNDER THIS APPLICATION IS ACCEPTABLE ONLY UNTIL PUBLIC FACILITIES BECOME AVAILABLE.

BLDG. PERMIT SIGNED
AND RETURNED 6/15/78
By [Signature]

SIGNATURE OF APPLICANT /s/ John Schneider

APPROVED BY _____ FOR _____ DATE _____
(KIND OF SYSTEM)

REJECTED BY _____ FOR _____ DATE _____
(KIND OF SYSTEM)

HOLD PENDING FURTHER TESTS _____ DATE _____

REASONS FOR REJECTION OR HOLDING 5/31/78 DIS MORE RH

-6/14/78 - PERC OK HOLD FOR PLAT. RH

THIS IS NOT A PERMIT

see plot!

INDICATE NORTH - NAME ADJOINING ROADWAY AS BASE LINE

DATE	TEST NO.	DEPTH	PRE-WET		TEST - 1" DROP		TIME
			START	STOP	START	STOP	
5/31/78	1D	12 1/2	1018	1020	Dirt fell in hole		
5/31/78	1S	7	1018	1019	1019	1020	1
	2S	4	1025	1026	1026	1027	1
	2D	14	1026	1043	1043	1050	17
	3D	13	1036	1041	1041	1048	7
	3S	4 1/2	1036	1041	1041	1048	7
	4D	13	1054	1736	little perc		
Other 9/7/78	5S	5 1/2	1:38	1:42	1:42	1:50	8 min
	5D	15 1/2	1:40	1:58	1:58	slow test stop	
	6S	4	1:48	2:05	no perc	second test	
	6D	17 1/2	1:50	no perc.			

Other 9/7/78
8:00 AM
Lester

REMARKS 5/31/78 Hole 1D looks Clayish. But OK to Perc
 TYPE OF SOIL again dirt fell in hole
 TESTED BY R. HODGES
 like 5. sand & clay at bottom

ALSO PRESENT: SCHNITZER
BRITTINGER AM CO

PAGE 2

A 28047

APPLICATION

SEWAGE DISPOSAL TESTING

P _____

STATE OF MARYLAND - DEPARTMENT OF HEALTH AND MENTAL HYGIENE

HOWARD COUNTY HEALTH DEPARTMENT
ENVIRONMENTAL HEALTH SERVICES
P. O. BOX 476, ELLICOTT CITY, MARYLAND 21043
TELEPHONE: 465-5000, EXT. 356

DISTRICT _____

DATE _____

TO: THE COUNTY HEALTH OFFICER
ELLICOTT CITY, MARYLAND

I, HEREBY, APPLY FOR THE NECESSARY TEST IN ORDER TO CONSTRUCT (OR RECONSTRUCT) A SEWAGE DISPOSAL SYSTEM.

PROPERTY OWNER DAVIS PROP

ADDRESS _____ PHONE _____

PROPERTY LOCATION:

SUBDIVISION _____ LOT NO. _____

ROAD AND DESCRIPTION NEW CUT RD PRIVATE
RD NEAR POWER LINE

SIZE OF LOT _____ TYPE BLDG. _____
NUMBER OF BEDROOMS _____

IF NOT SINGLE RESIDENCE DESCRIBE _____

THE SYSTEM INSTALLED UNDER THIS APPLICATION IS ACCEPTABLE ONLY UNTIL PUBLIC FACILITIES BECOME AVAILABLE.

SIGNATURE OF APPLICANT _____

APPROVED BY _____ FOR _____ DATE _____
(KIND OF SYSTEM)


REJECTED BY _____ FOR _____ DATE _____
(KIND OF SYSTEM)

HOLD PENDING FURTHER TESTS _____ DATE _____

REASONS FOR REJECTION OR HOLDING _____

THIS IS NOT A PERMIT

BACK LINE

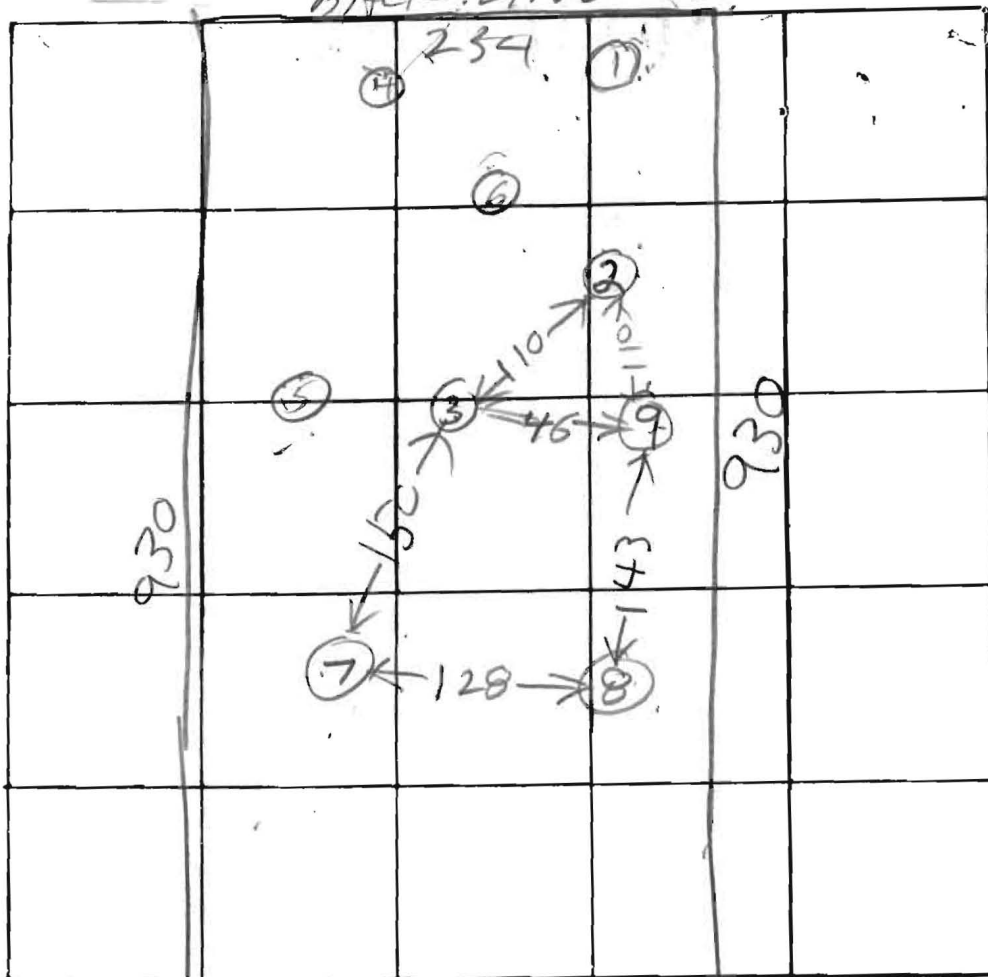


INDICATE NORTH - NAME ADJOINING ROADWAY AS BASE LINE

DATE	TEST NO.	DEPTH	PRE-WET		TEST - 1" DROP		TIME
			START	STOP	START	STOP	
6/14/78	7D	13	142	150	150	208	18
	7S	4	143	144	144	145	1
	8D	13	157	201	201	208	7
	8S	4	159	214	214	228	14
6/14/78	9V	11	TOP 4 FT CLAY		BOT 7 FT SANDY DR		

REMARKS _____

TYPE OF SOIL _____

TESTED BY RH 6/14/78 ENGINEER SCHNEIDER
 ALSO PRESENT: _____

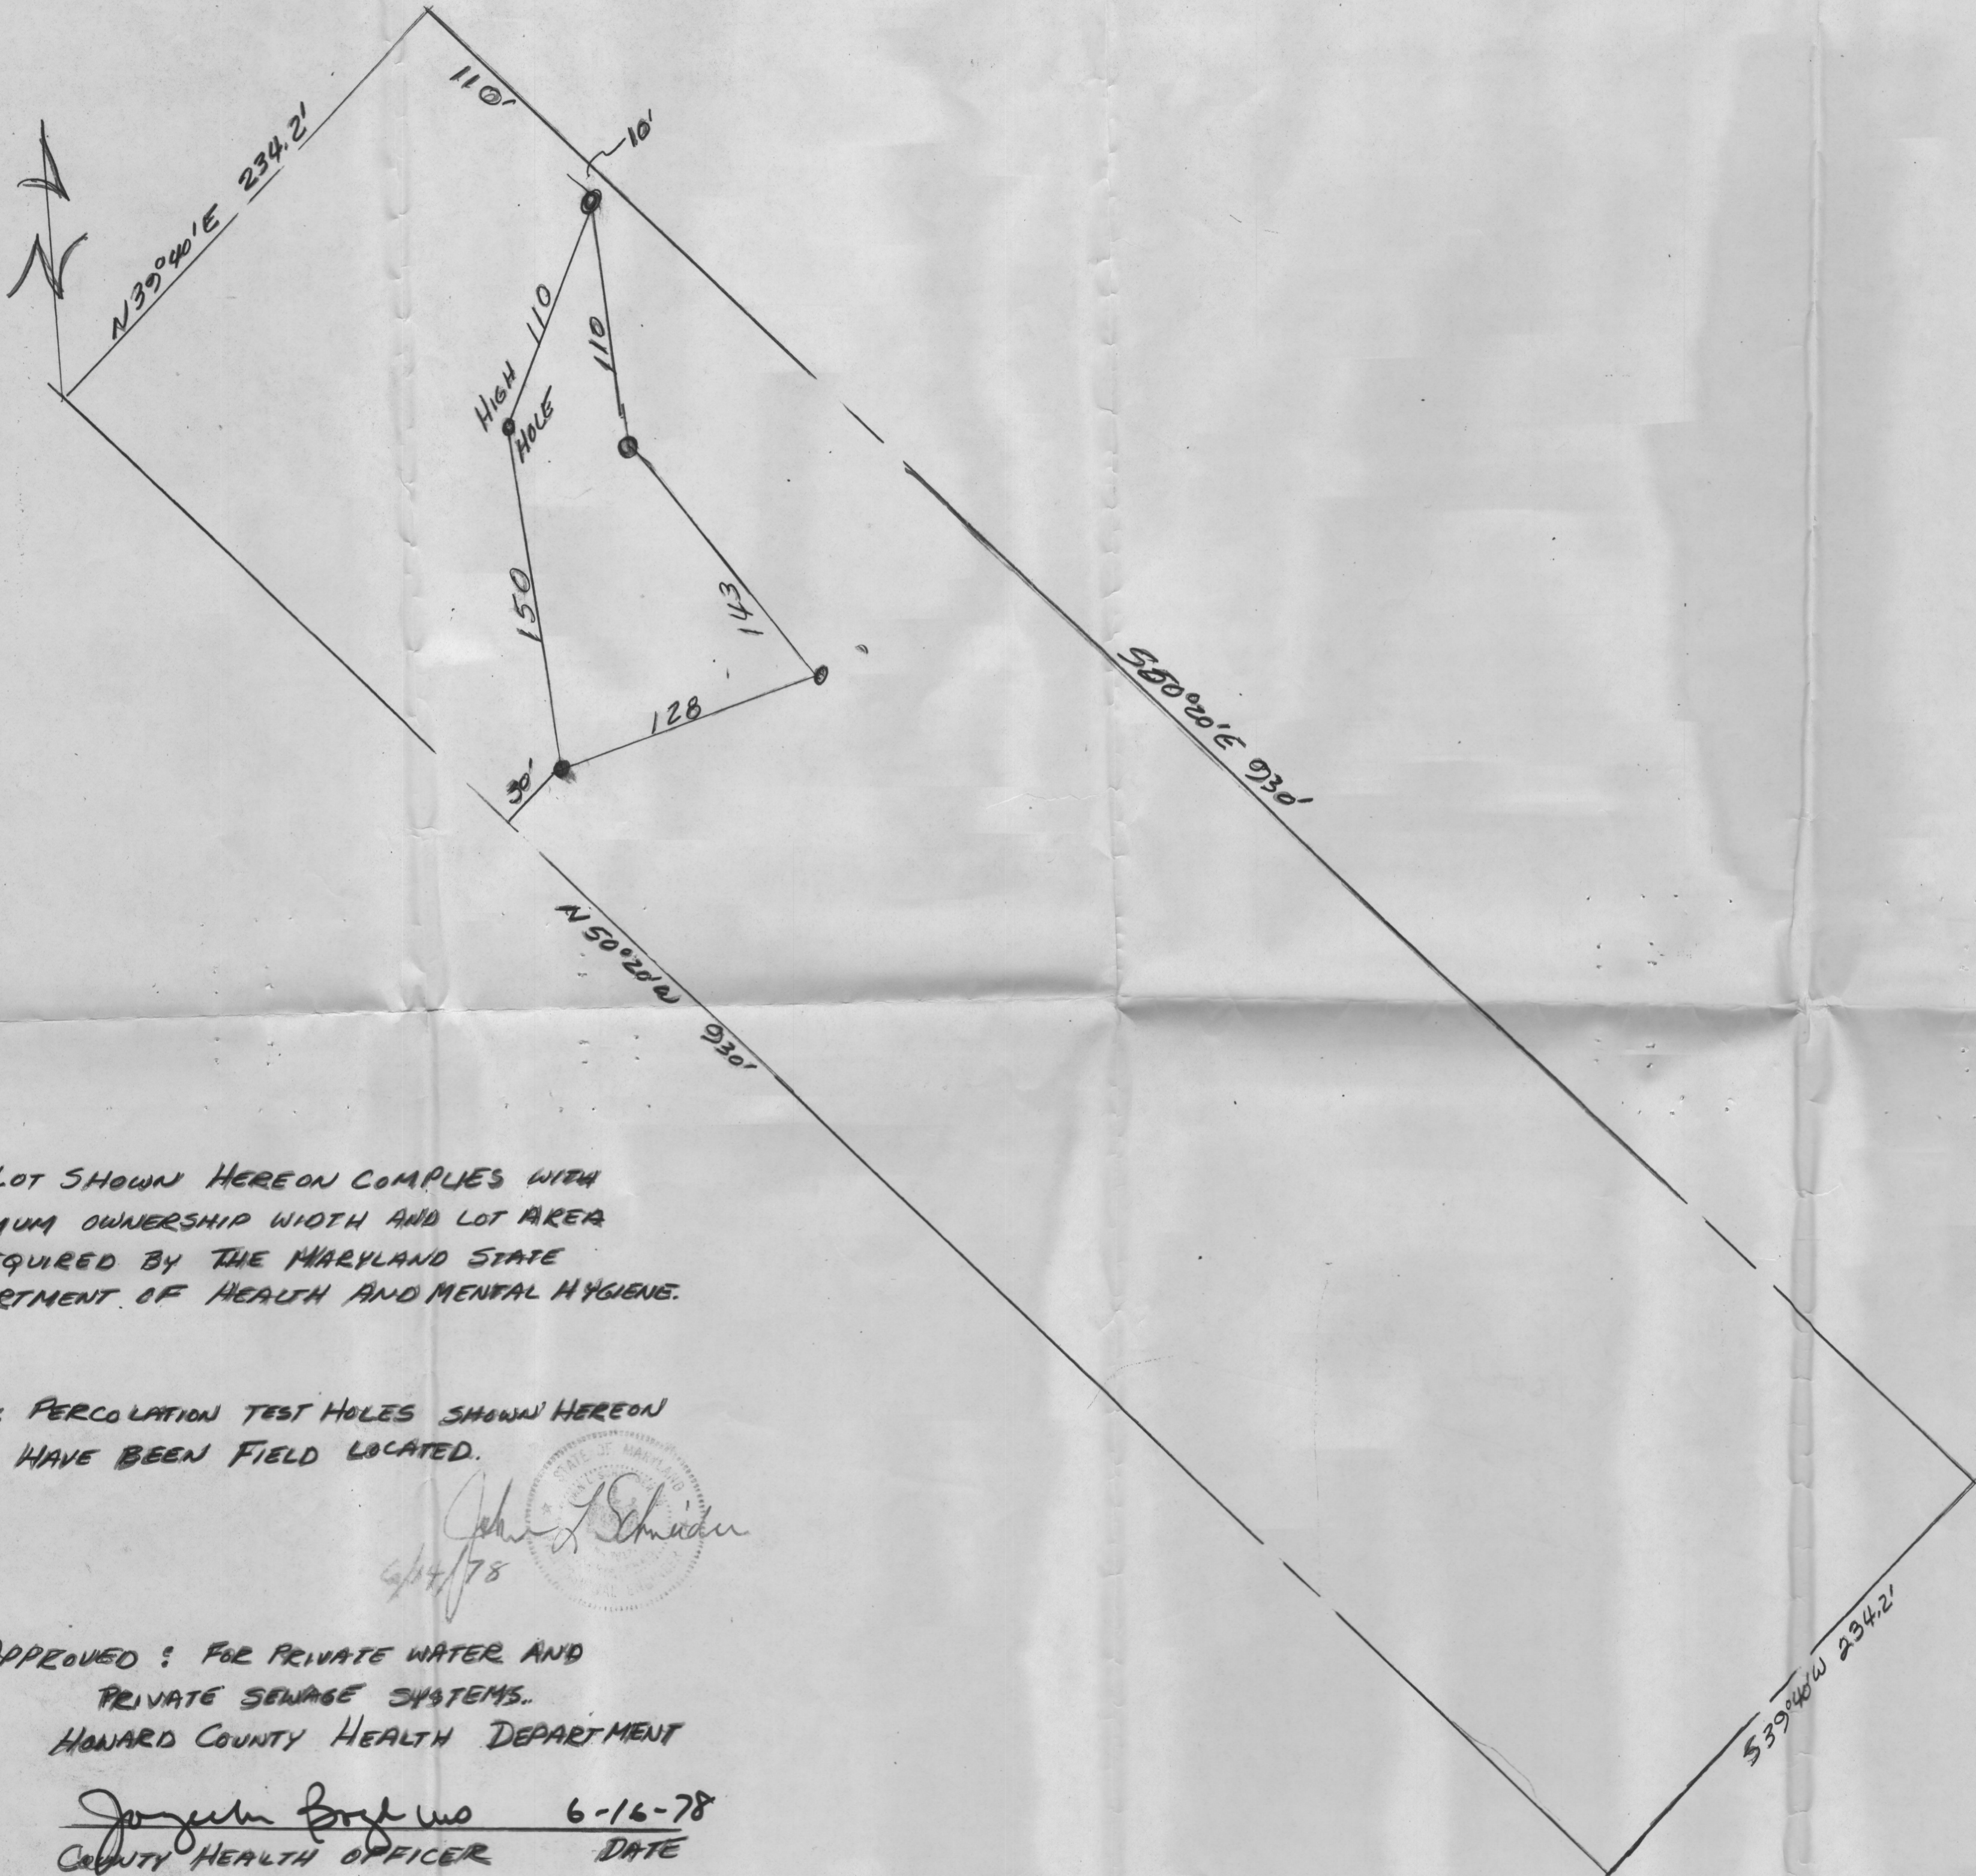

THE LOT SHOWN HEREON COMPLIES WITH
 MINIMUM OWNERSHIP WIDTH AND LOT AREA
 AS REQUIRED BY THE MARYLAND STATE
 DEPARTMENT OF HEALTH AND MENTAL HYGIENE.

NOTE: PERCOLATION TEST HOLES SHOWN HEREON
 HAVE BEEN FIELD LOCATED.



John L. Schneider
 6/14/78



APPROVED: FOR PRIVATE WATER AND
 PRIVATE SEWAGE SYSTEMS.
 HOWARD COUNTY HEALTH DEPARTMENT

Joseph M. Boyle 6-16-78
 COUNTY HEALTH OFFICER DATE

DAVIS PROPERTY
 PERC LOCATION CERTIFICATION
 4653B NEW CUT RD.
 BY J.L. SCHWEIDER, P.E. 944-5357
 6825 WINDSOR HILL RD., BALT. MD
 11550 6-14-78

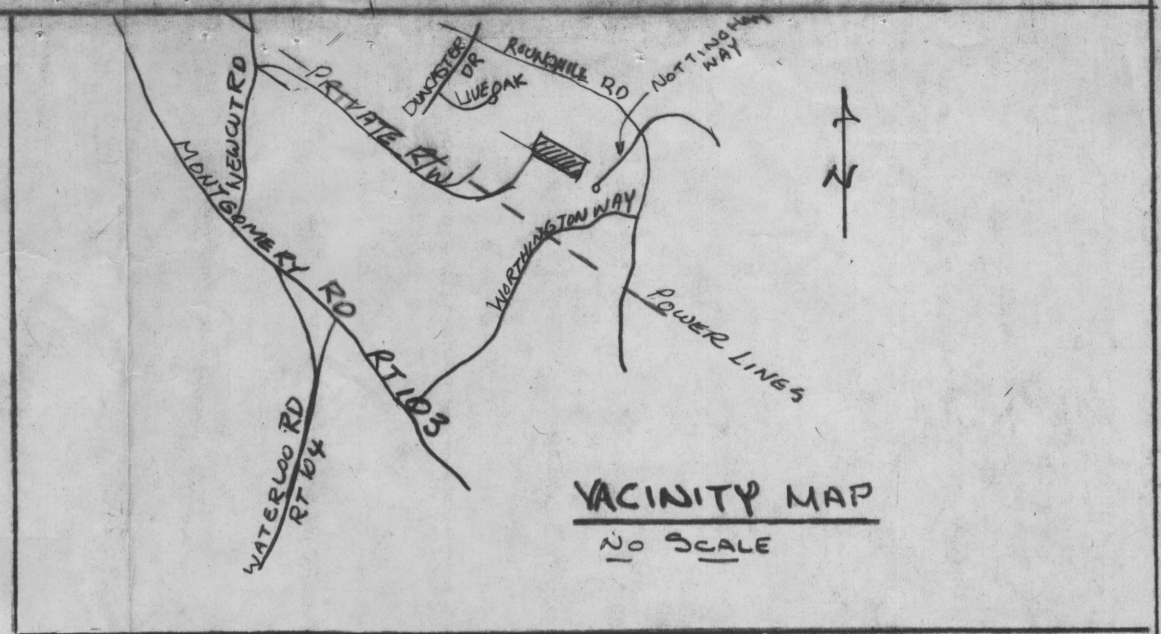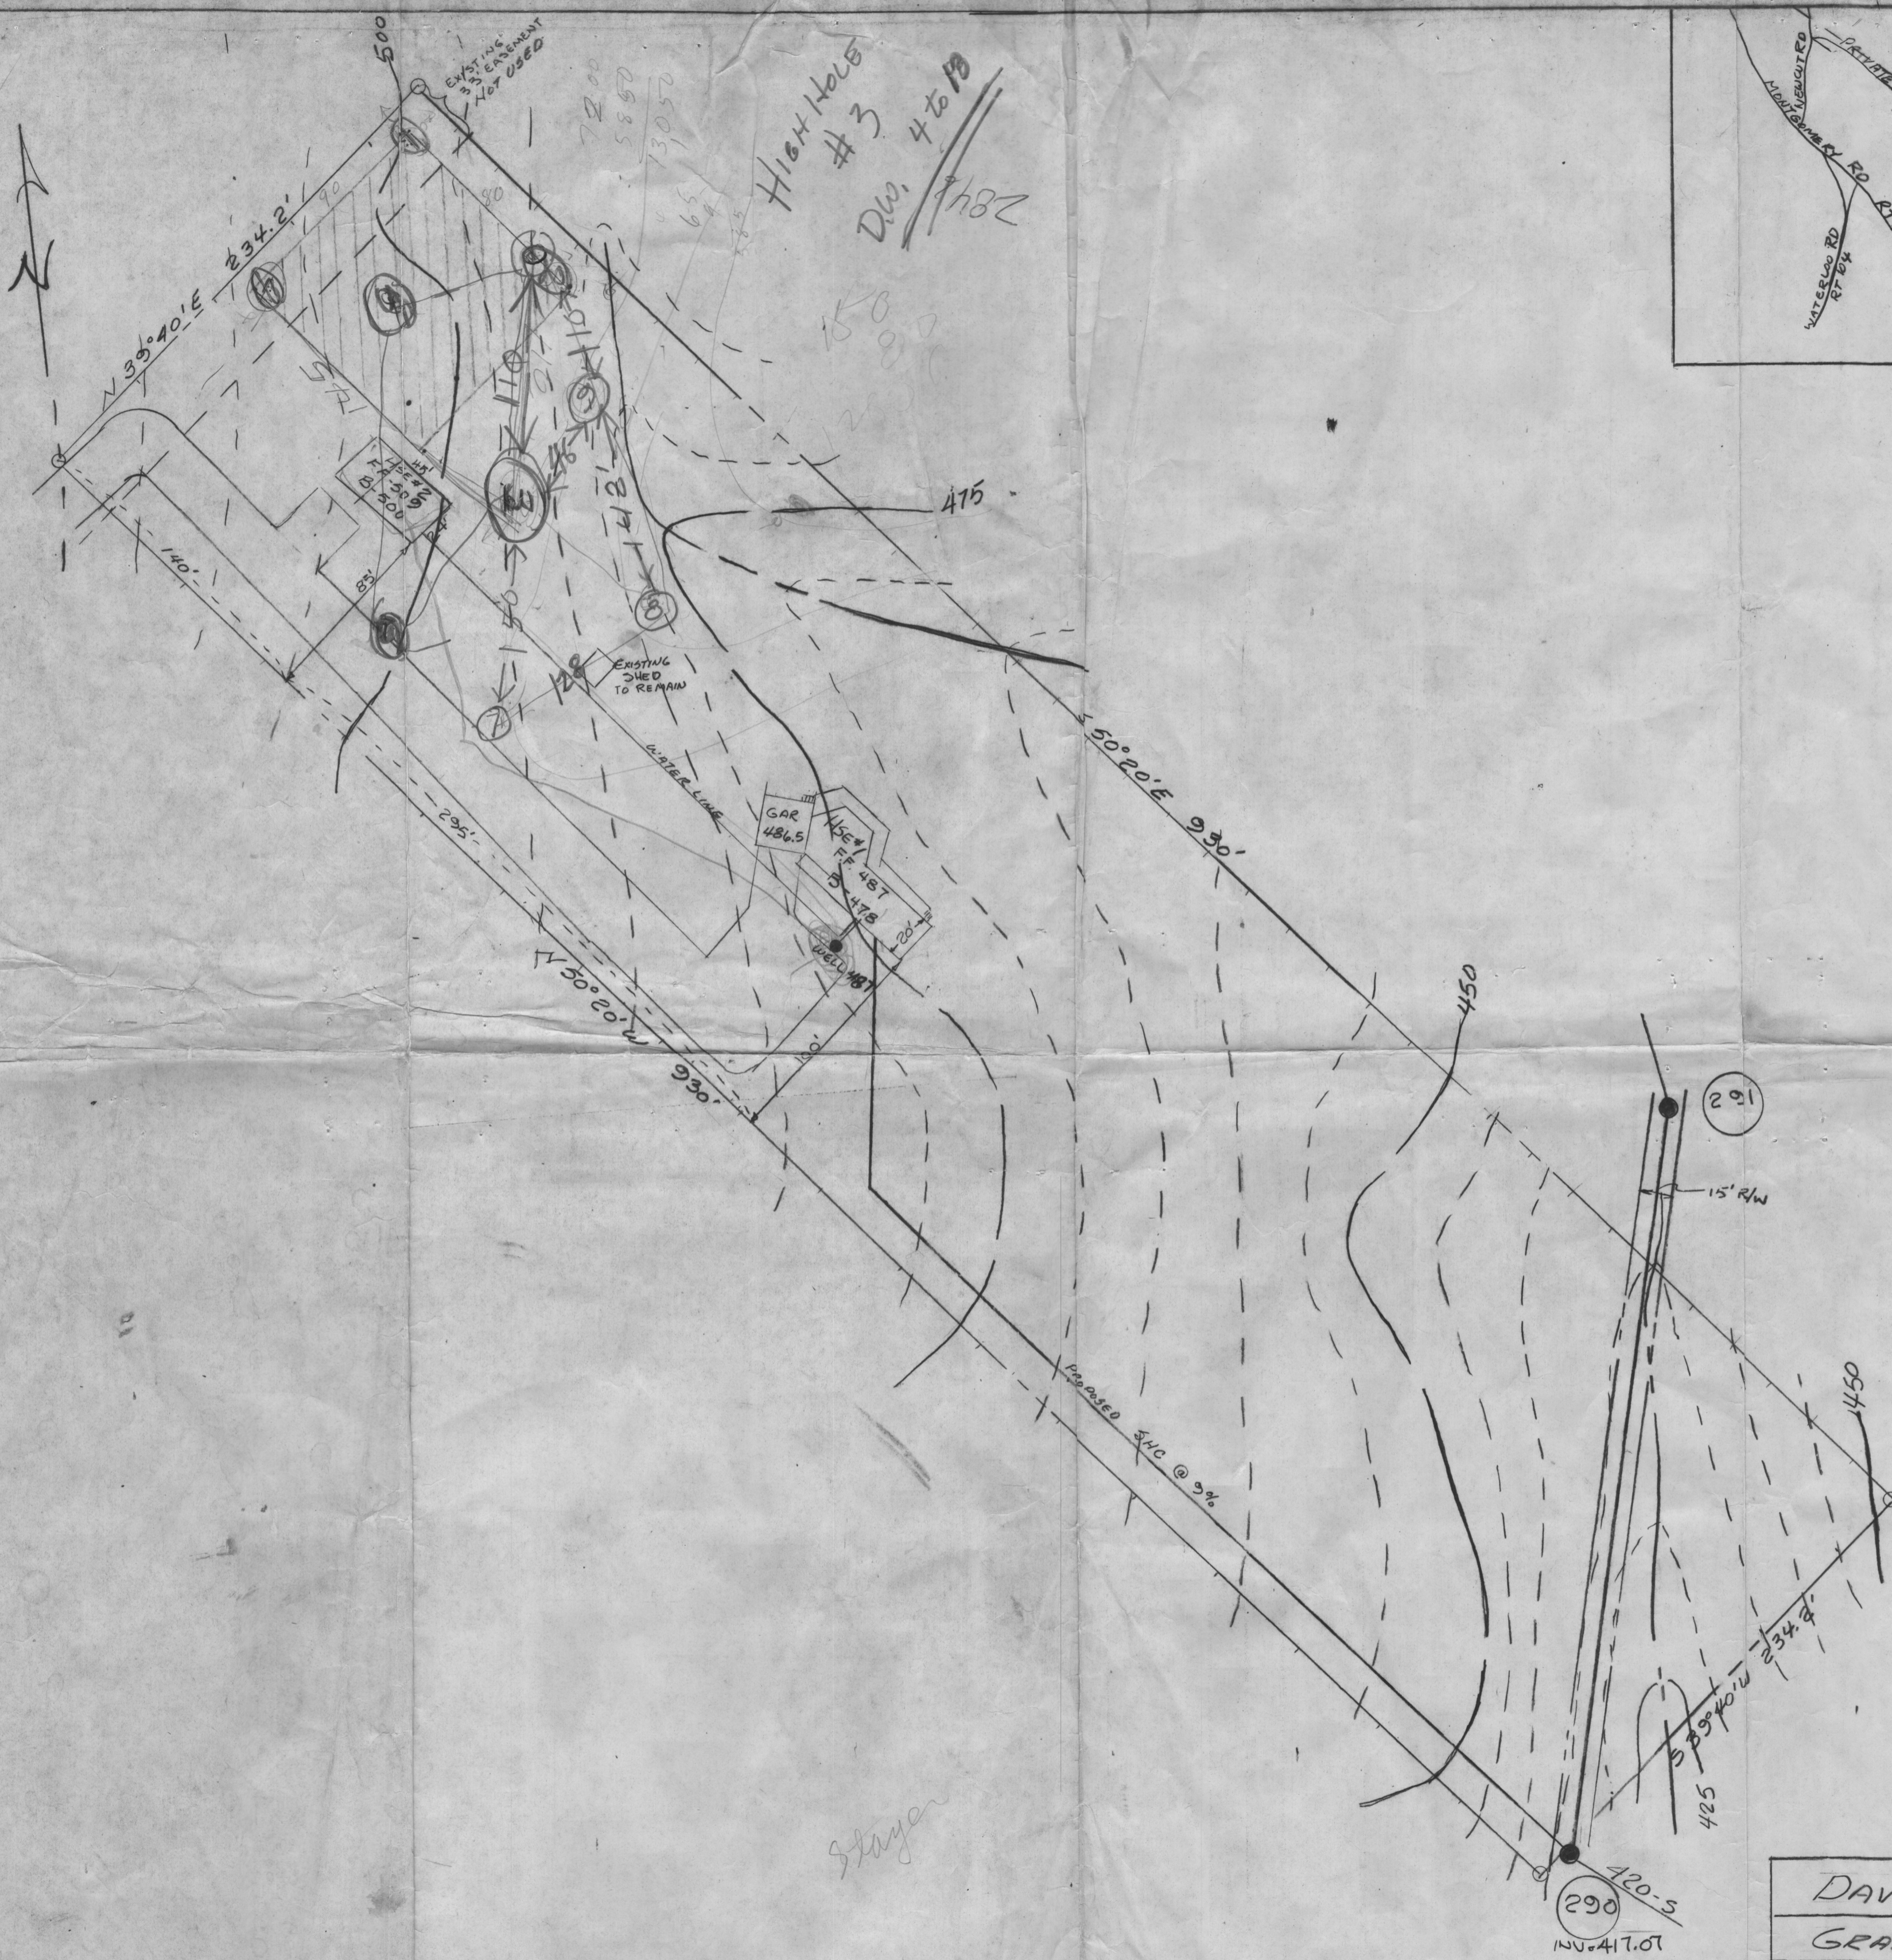

High Walk #3
D.W. 4 to 18
1782

DAVIS PROPERTY	
GRADING STUDY	
OWNER: G.V. DAVIS 5839 HUNT HILL DR. ELKRIEGE MO 21227	
PREPARED BY: J.L. SCHNEIDER, P.E. 944-5357 6825 WINDSOR MILL RD. BALT. MD 21204	
SCALE: 1" = 50'	DATE: 2-4-78

Skoger