



Building Permit Application

Howard County Maryland
Department of Inspections, Licenses and Permits
3430 Court House Drive
Permits: 410-313-2455
www.howardcountymd.gov

Date Received: _____

Permit No.: _____

Building Address: 14043 Howard Rd
City: Dayton State: Md. Zip Code: 21036
Suite/Apt. # _____ SDP/WP/BA #: _____
Census Tract: _____ Subdivision: N/A
Section: _____ Area: _____ Lot: 2
Tax Map: 27 Parcel: 94 Grid: 6
Zoning: _____ Map Coordinates: _____ Lot Size: 2.89

Existing Use: residential
Proposed Use: same
Estimated Construction Cost: \$ 45,000
Description of Work: remove existing porch
replace w/ new 10' x 40' porch -
dump-out one wall 4' deeper
Occupant or Tenant: _____
Was tenant space previously occupied? Yes No
Contact Name: _____
Address: _____
City: _____ State: _____ Zip Code: _____
Phone: _____ Fax: _____
Email: _____

Property Owner's Name: Laurence/Nancy
Address: same Hunter
City: _____ State: _____ Zip Code: _____
Phone: 301 854 0279 Fax: _____
Email: Nandehunter@verizon.net

Applicant's Name & Mailing Address, (If other than stated herein)
Applicant's Name: Sharon Keeny
Address: 14026 Howard Rd
City: Dayton State: Md Zip Code: 21036
Phone: 443 677 886 Fax: _____
Email: Sharon.Keeny@LNF.com

Contractor Company: William Becker
Contact Person: Bill Becker
Address: 15300 Carrs Mill Rd.
City: Woodbine State: Md Zip Code: 21797
License No.: 33072
Phone: 443 829 6036 Fax: 410-442-5930
Email: _____

Engineer/Architect Company: _____
Responsible Design Prof.: _____
Address: _____
City: _____ State: _____ Zip Code: _____
Phone: _____ Fax: _____
Email: _____

Commercial Building Characteristics	Residential Building Characteristics
Height:	<input checked="" type="checkbox"/> SF Dwelling <input type="checkbox"/> SF Townhouse
No. of stories:	Depth Width
Gross area, sq. ft./floor:	1 st floor:
Area of construction (sq. ft.):	2 nd floor:
Use group:	Basement:
Construction type:	<input type="checkbox"/> Finished Basement
<input type="checkbox"/> Reinforced Concrete	<input type="checkbox"/> Unfinished Basement
<input type="checkbox"/> Structural Steel	<input type="checkbox"/> Crawl Space
<input type="checkbox"/> Masonry	<input type="checkbox"/> Slab on Grade
<input type="checkbox"/> Wood Frame	No. of Bedrooms:
<input type="checkbox"/> State Certified Modular	Multi-family Dwelling
<input type="checkbox"/> Roadside Tree Project Permit	No. of efficiency units:
<input type="checkbox"/> Yes <input checked="" type="checkbox"/> No	No. of 1 BR units:
Roadside Tree Project Permit #	No. of 2 BR units:
	No. of 3 BR units:
	Other Structure:
	Dimensions:
	Footings:
	Roof:
	<input type="checkbox"/> State Certified Modular
	<input type="checkbox"/> Manufactured Home

Utilities
Water Supply
<input type="checkbox"/> Public
<input checked="" type="checkbox"/> Private
Sewage Disposal
<input type="checkbox"/> Public
<input checked="" type="checkbox"/> Private
Electric: <input checked="" type="checkbox"/> Yes <input type="checkbox"/> No
Gas: <input type="checkbox"/> Yes <input checked="" type="checkbox"/> No
Heating System
<input checked="" type="checkbox"/> Electric <input type="checkbox"/> Oil
<input type="checkbox"/> Natural Gas <input type="checkbox"/> Propane Gas
<input type="checkbox"/> Other:
Sprinkler System:
<input type="checkbox"/> Yes <input checked="" type="checkbox"/> No
Grading Permit Number:
Building Shell Permit Number:

THE UNDERSIGNED HEREBY CERTIFIES AND AGREES AS FOLLOWS: (1) THAT HE/SHE IS AUTHORIZED TO MAKE THIS APPLICATION; (2) THAT THE INFORMATION IS CORRECT; (3) THAT HE/SHE WILL COMPLY WITH ALL REGULATIONS OF HOWARD COUNTY WHICH ARE APPLICABLE THERETO; (4) THAT HE/SHE WILL PERFORM NO WORK ON THE ABOVE REFERENCED PROPERTY NOT SPECIFICALLY DESCRIBED IN THIS APPLICATION; (5) THAT HE/SHE GRANTS COUNTY OFFICIALS THE RIGHT TO ENTER ONTO THIS PROPERTY FOR THE PURPOSE OF INSPECTING THE WORK PERMITTED AND POSTING NOTICES.

Sharon L. Keeny
Applicant's Signature
sharon.keeny@LNF.com
Email Address

Sharon L. Keeny
Print Name
10-28-14
Date

Title/Company

Checks Payable to: DIRECTOR OF FINANCE OF HOWARD COUNTY

PLEASE WRITE NEATLY & LEGIBLY

-FOR OFFICE USE ONLY-

AGENCY	DATE	SIGNATURE OF APPROVAL
State Highways		
Building Officials		
PSZA (Zoning)		
PSZA (Engineering)		
Health	<u>10/20/14</u>	<u>H. Oswald</u>

Is Sediment Control approval required for issuance? Yes No
 CONTINGENCY CONSTRUCTION START

DPZ SETBACK INFORMATION
Front:
Rear:
Side:
Side St.:
All minimum setbacks met? <input type="checkbox"/> Yes <input type="checkbox"/> No
Is Entrance Permit Required? <input type="checkbox"/> Yes <input type="checkbox"/> No
Historic District? <input type="checkbox"/> Yes <input type="checkbox"/> No
Lot Coverage for New Town Zone:
SDP/Red-line approval date:

Filing Fee	\$ <u>25.00</u>
Permit Fee	\$
Tech Fee	\$
Excise Tax	\$
PSFS	\$
Guaranty Fund	\$
Add'l per Fee	\$
Total Fees	\$
Sub-Total Paid	\$
Balance Due	\$
Check	#

Distribution of Copies: White: Building Officials

Green: PSZA,Zoning

Yellow: PSZA,Engineering

Pink: Health


Gold: SHA

PROPERTY KNOWN AS: LOTS 1 & 2
 HARMAN SUBDIVISION
 LOTS 1, 2 & NO. 3
 5TH ELECTION DISTRICT
 HOWARD COUNTY, MD
 PLAT T388

THIS PLAT CAN NOT BE USED TO ESTABLISH
 PROPERTY LINES OR CORNERS.

HOWARD ROAD
 80' R/W

APPROVED
WALK-THRU BUILDING PERMIT
 BP# _____ A# _____
 APP. SA# W. Oswald DATE: 10/30/14
 DESC. OF WORK: remove existing porch
replace w/ new 10' x 40' porch - bump
out study/sitting room wall 4'
Remove interior door to same
room & widen it to 4'.

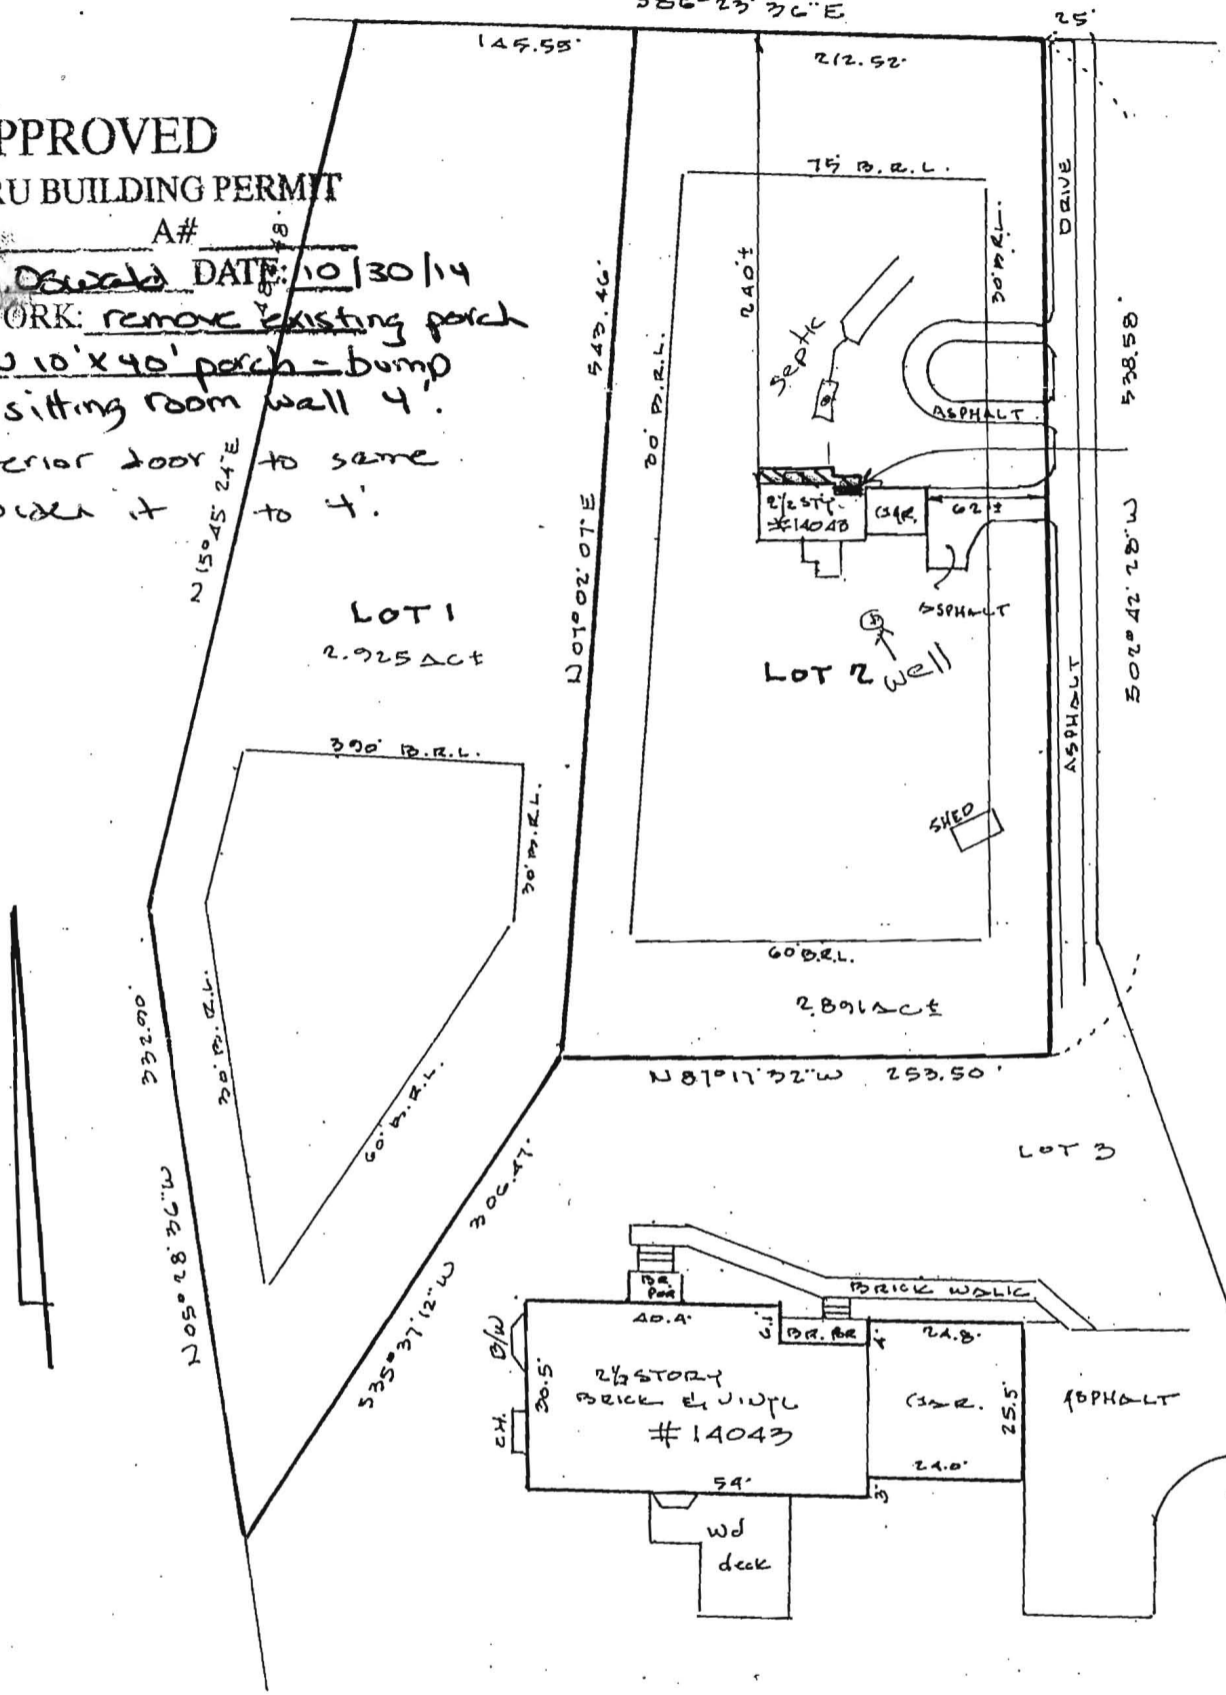

LOCATION DRAWING

CERTIFICATION	SEAL	SCALE 1"=100'	DATE 1-15-00
----------------------	-------------	----------------------	---------------------

This is to certify that I have surveyed
 the property known as: 14043
HOWARD ROAD

The information shown has been established
 by current acceptable survey procedures and
 from available record information. This drawing
 is to be used for Title Transfer Financing, or
 Refinancing Only and IS NOT to be used for
 the Establishment of Property Lines, Location
 or Fences, Garages, Buildings, or other
 Existing or Future Improvements.




Walter Park

LDE Inc.
 9250 Rumsey Road Suite 106
 Columbia, Maryland 21045
 (410) 715-1070 (Balt.)
 (301) 596-3424 (Wash)
 (410) 715-9540 (Fax)

SE

JOB NO.

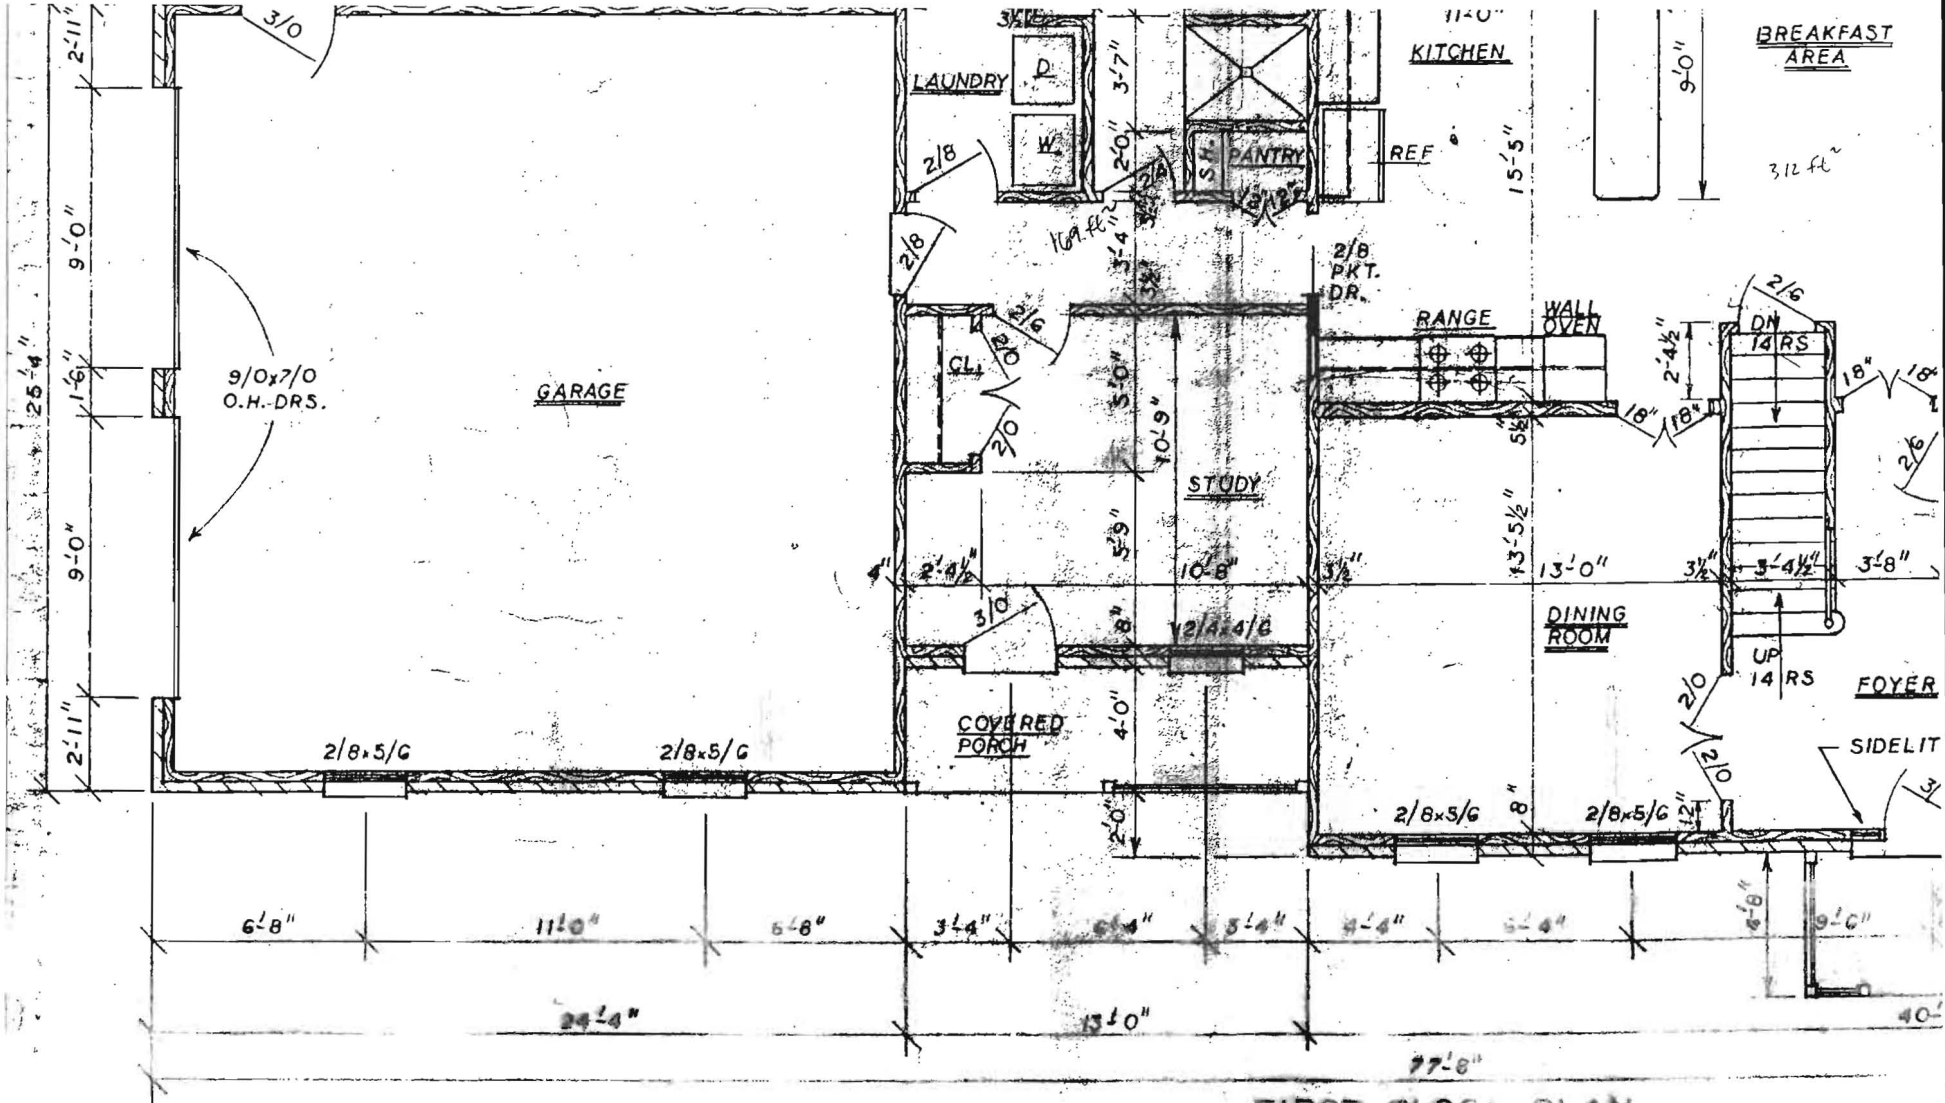

FIRST FLOOR PLAN
 SCALE: 1/4" = 1'-0"

