

*Checked 1/28/69
George
Howard*

PERMIT

P 14164

SEWAGE DISPOSAL SYSTEM

A 08281

MARYLAND STATE DEPARTMENT OF HEALTH

HOWARD COUNTY

ELLCOTT CITY

INDEXED

DISTRICT 3

DATE 12/3/68

Robert Dubin Co. IS PERMITTED TO INSTALL X ALTER

ADDRESS Rt. 1, Brookeville, Maryland PHONE 774 9615

A SEWAGE DISPOSAL SYSTEM LOCATED AT _____

SUBDIVISION Burnt Woods ROAD Burnt Woods Road LOT 25, Blk. D,
14018 *Paduro*
Sec. 2

PROPERTY OWNER Burnt Woods Development Co., Inc.

ADDRESS _____

SPECIFICATIONS - 3 bedrooms

DRAIN FIELD _____ DEPTH _____ FEET, BOTTOM AREA _____ SQ. FT.

SEEPAGE PITS _____ ABSORBENT SIDE-WALL AREA _____ SQ. FT.

SEPTIC TANK CAPACITY 750 GALLONS

Installed no deeper than 3 ft. below original grade

FOR GARBAGE GRINDER, INCREASE DISPOSAL AREA 22% & TANK CAPACITY 80%.

OTHER Leaching bed - 112 sq. ft. bottom area per bedroom installed 7 ft. below original grade including gravel. Place leaching bed between 70 and 100 ft. from rear lot line and between 30 and 80 ft. from left side line as seen when facing lot from Burnt Woods Road.

PERMIT VOID AFTER THREE YEARS.

PLANS APPROVED BY D. W. Monaghan DATE 9/28/64


FILL SEPTIC TANK AND DISTRIBUTION BOX WITH WATER BEFORE CALLING FOR AN INSPECTION. COVER NO WORK UNTIL INSPECTED AND APPROVED.

NEITHER THE HOWARD COUNTY COMMISSIONERS NOR THE HEALTH DEPARTMENT IS RESPONSIBLE FOR THE SUCCESSFUL OPERATION OF ANY SYSTEM.

NOTIFY THE HEALTH DEPARTMENT 48 HOURS BEFORE EXCAVATIONS ARE TO BE BACK FILLED.

108281

14
 3
 4
 3
 10
 23
 13
 11
 12
 13
 14
 3
 48

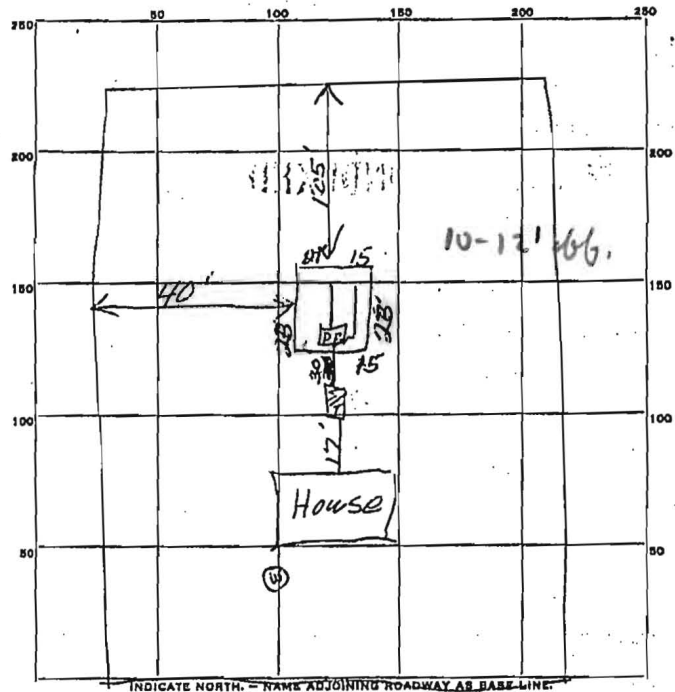

PERMIT CARD _____
 SEPTIC TANK, LEVEL _____ CLEANOUTS _____
 DISTRIBUTION BOX, LEVEL _____
 TILE FIELD, DEPTH 7 FT. TRENCH WIDTH _____ FT.
 GRAVEL DEPTH 24 IN. TOTAL LENGTH _____ FT.
 NUMBER OF TRENCHES _____ TOTAL BOTTOM AREA _____
 SEEPAGE PITS, INSIDE DIAMETER _____ FT. DEPTH BELOW INLET _____ FT.
 ABSORBENT AREA _____ SQ. FT.

REMARKS 1/28/69 Perisid JTW

8/12/71 Final - system completely covered grass growing
over area. Owner's daughter stated system operating
ok.

DATE SYSTEM APPROVED covered but
not inspected INSPECTOR C. Straker