

APPLICATION

SEWAGE DISPOSAL TESTING

A 08281

P _____

MARYLAND STATE DEPARTMENT OF HEALTH

HOWARD COUNTY

ELLICOTT CITY

Septic Tank - 3 bedrooms - 750 gal installed no dipper
1000 gal (has 3 ft below avg in
1500 gal. grade.

DISTRICT 3

DATE 4/10/64

Leaching Bed - 112 sq ft bottom area pulsed room installed ~~no dipper~~
type 17 ft below original grade including gravel

Please Leaching Bed between 70 inch 100 ft from rear lot line
and between 30 inch 80 ft from left side line as seen when facing lot from

TO: THE COUNTY HEALTH OFFICER Burnt Woods, MD.
ELLICOTT CITY, MARYLAND

I, HEREBY, APPLY FOR THE NECESSARY TESTS IN ORDER TO CONSTRUCT (OR RECONSTRUCT) A SEWAGE DISPOSAL SYSTEM.

PROPERTY OWNER Burnt Woods Development Co., Inc.

ADDRESS 212 Crownwood Rd., E. C., Md. PHONE HO 5-1345

PROPERTY LOCATION:

SUBDIVISION Burnt Woods LOT NO. 25, Blk. D - House

ROAD AND DESCRIPTION Burnt Woods Road

OCCUPANT _____ PHONE _____

PERSON TO CONSTRUCT SYSTEM _____

ADDRESS _____ PHONE _____

SIZE OF LOT 40,493 sq. ft. TYPE BLDG. test per bedroom
NUMBER OF BEDROOMS

IF NOT SINGLE RESIDENCE DESCRIBE _____

SIGNATURE OF APPLICANT Mr. C. Wallacefield Jr.

APPROVED BY W. M. Morgan FOR Leaching Bed DATE 4/10/64


REJECTED BY _____ FOR _____ DATE _____

HOLD PENDING FURTHER TESTS _____ DATE _____

REASONS FOR REJECTION OR HOLDING _____

THIS IS NOT A PERMIT

- 10

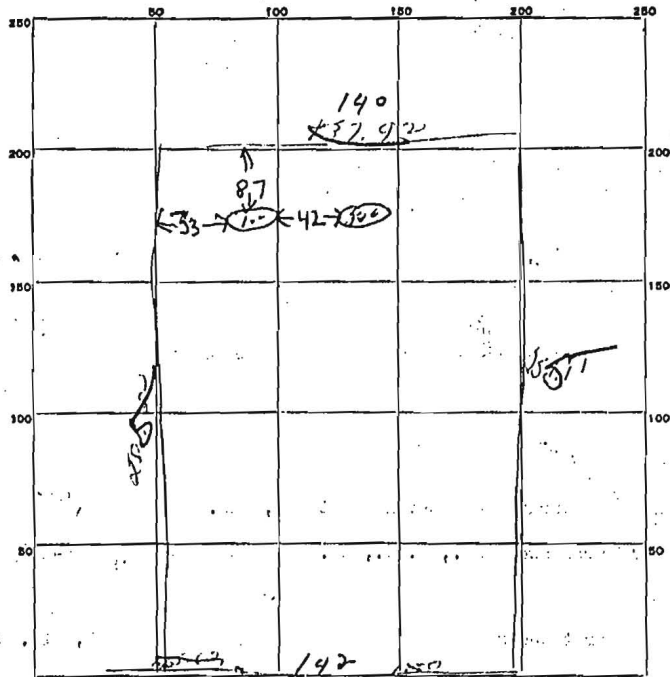

INDICATE NORTH - NAME ADJOINING ROADWAY AS BASE LINE.

Beverlywood Rd

DATE	TEST NO.	DEPTH	PRE-WET		TEST - 1" DROP		TIME
			START	STOP	START	STOP	
7/9/64	1	5 ft	232	235	235	245	10 min
	2	10 ft	233	237	237	248	11 min
	3	10 ft	243	247	247	255	8 min
	4	5 ft	243	247	247	255	8 min

SOIL AUGER FINDING _____

TESTED BY *Wm-RD F*

REMARKS _____

ALSO PRESENT *L. Booth*

LOT NO. *25/W.P. 242*