


Handwritten scribbles

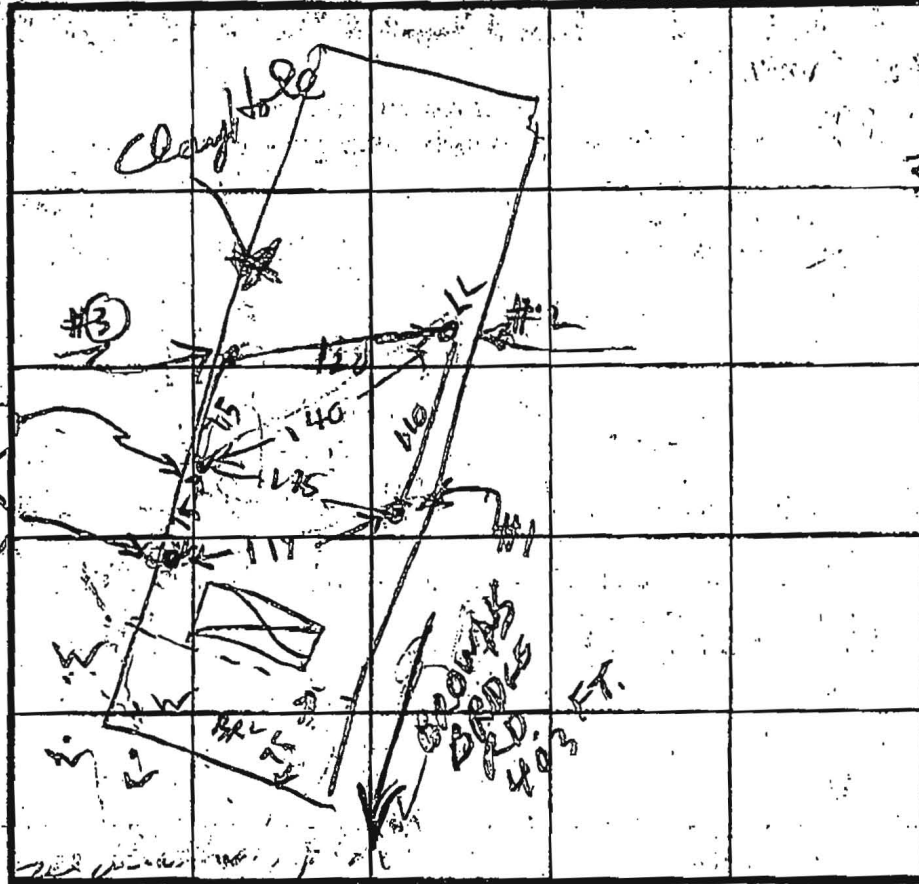

④
BROWN CLAY

3/2
BROWN GRAY SAND LOAM

⑤
BROWN CLAY
RED BROWN CLAY SAND

6
GRAY BROWN SAND & FEW ROCKS

①
SOIL PROFILE
BROWN CLAY
GRAY BROWN SAND LOAM

②
BROWN CLAY
GRAY BROWN SAND LOAM

③
BROWN CLAY
BROWN CLAY LOAM
GRAY BROWN SAND LOAM

DATE	TEST NO.	DEPTH	PRE-WET		TEST - 1" DROP		TIME
			START	STOP	START	STOP	
10/4/82	1V	7 1/2	LOOKS	OK	SEE SOIL PROFILE		
	2V	12	LOOKS	OK	SEE SOIL PROFILE		
	3V	9 1/2	LOOKS	DOUBTFUL & FAILED			
	4V	13	LOOKS	OK			
	3S	6	218	317	59mm	interior	FAIL
	4S	5	223	224	224	225	1
	1S	5 1/2	226	230	230	233	3
	2S	4 1/2	229	230	230	232	2
	5S	5 1/2	300	310	310	327	17
	5V	14	LOOKS	OK			

REMARKS
 5V IS ON LINE NONE ON SIDE LINE 4A & 4B
 3V IS ON LINE HOLE ON SIDE LINE LOT 4A & 4B
 4V " " " " " " " " " "

TESTED BY R HODGES ALSO PRESENT D REWER O KETTERMAN

EH-12-1079