

PRELIMINARY

APPLICATION

18472

YEAR

SEWAGE DISPOSAL TESTING

STATE OF MARYLAND - DEPARTMENT OF HEALTH AND MENTAL HYGIENE

HOWARD COUNTY HEALTH DEPARTMENT
ENVIRONMENTAL HEALTH SERVICES
P. O. BOX 476, ELLICOTT CITY, MARYLAND 21043
TELEPHONE: 465-5000, EXT. 356

DISTRICT 4th

DATE 5/9/73

TO: THE COUNTY HEALTH OFFICER
ELLICOTT CITY, MARYLAND

I, HEREBY, APPLY FOR THE NECESSARY TEST IN ORDER TO CONSTRUCT (OR RECONSTRUCT) A SEWAGE DISPOSAL SYSTEM.

PROPERTY OWNER Mordecai Hoseh

ADDRESS Woodbine, Md.

Any questions call Louise Adams,
PHONE 531-5458

PROPERTY LOCATION:

SUBDIVISION _____ LOT NO. 24

ROAD AND DESCRIPTION Florence Road - 1 1/2 blocks from Ed. Warfield Road on right -
off Ed. Warfield Road from Daisy.

SIZE OF LOT 5.061 acres TYPE BLDG. 3 or 4 bedrooms
NUMBER OF BEDROOMS

IF NOT SINGLE RESIDENCE DESCRIBE _____

THE SYSTEM INSTALLED UNDER THIS APPLICATION IS ACCEPTABLE ONLY UNTIL PUBLIC FACILITIES BECOME AVAILABLE.

SIGNATURE OF APPLICANT /s/ Louise H. Adams

APPROVED BY _____ FOR _____ DATE _____
(KIND OF SYSTEM)

REJECTED BY _____ FOR _____ DATE _____
(KIND OF SYSTEM)

HOLD PENDING FURTHER TESTS _____ DATE _____


REASONS FOR REJECTION OR HOLDING _____

THIS IS NOT A PERMIT

STW81
EXHIBIT A

APPLICATION

PRELIMINARY

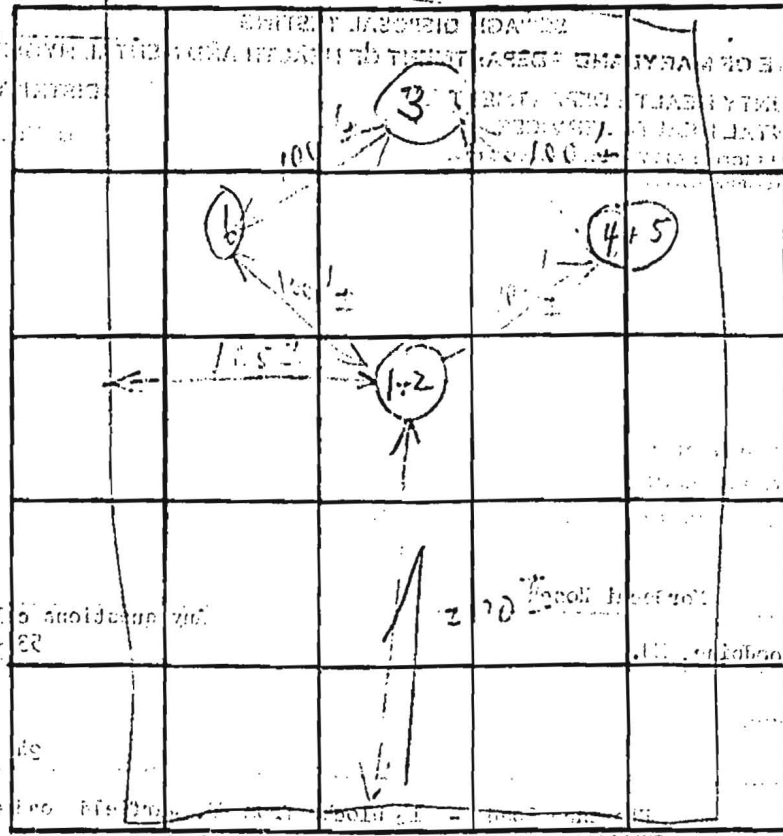

INDICATE NORTH. - NAME ADJOINING ROADWAY AS BASE LINE.

DATE	TEST NO.	DEPTH	PRE-WET		TEST - 1" DROP		TIME
			START	STOP	START	STOP	
5/12/77	1	4'	11:19	11:23	11:22	11:30	8 min
	2	12'	11:19	11:21	11:21	11:23	2 min
	3	11 1/2'	Vacant				
	4	4'	11:24	11:26	11:26	11:30	4 min
	5	12'	11:28	11:31	11:31	11:41	10 min
	6	17'	Vacant			9:24	6 min

Use 1+2
Under 4'
135 eggs
parked
room

REMARKS: _____
TYPE OF SOIL: _____