

APPROVED
4/25/86
RH
P. 36858
A Repair

PERMIT

SEWAGE DISPOSAL SYSTEM

MARYLAND STATE DEPARTMENT OF HEALTH*

HOWARD COUNTY
BUREAU OF ENVIRONMENTAL HEALTH
~~988-9270~~
461-9933

ELLICOTT CITY
DISTRICT _____
DATE 4/25/86

INDEXED

Jack Fyock IS PERMITTED TO INSTALL ALTER _____

ADDRESS _____ PHONE 988-9270

SUBDIVISION Shephard Glen ROAD 13194 Skyway Drive LOT A

PROPERTY OWNER P. Geips

ADDRESS _____

IF GARBAGE GRINDER IS USED INCREASE SEPTIC TANK CAPACITY BY 50% AND ABSORPTION AREA BY 22%.

GARBAGE GRINDER? YES _____ NO

SEPTIC TANK CAPACITY _____ GALLONS NUMBER OF BEDROOMS 4

REPAIR - CALL FOR INSPECTION WHEN GROUND IS OPENED UP SO SANITARIAN CAN RECOMMEND REPAIR.

4/25/86 TRENCH OFF OLD DRY WELL
125 SQ FT PER BED ROOM = 500 SQ FT
TOTAL 12 FT DEEP 8 FT STONE
2 FT WIDE 63 FT LONG RH

PLANS APPROVED BY C. Williams DATE 4/25/86

COVER NO WORK UNTIL INSPECTED AND APPROVED.

NEITHER THE HOWARD COUNTY COUNCIL NOR THE HEALTH DEPARTMENT IS RESPONSIBLE FOR THE SUCCESSFUL OPERATION OF ANY SYSTEM.

NOTE: IF TRENCH IS USED CALL FOR INSPECTION BEFORE AND AFTER PLACING GRAVEL IN TRENCH.

NOTE: NO DRY WELL SHALL EXCEED 15 FOOT IN DIAMETER. NO ABSORPTION TRENCH TO EXCEED 100 FEET IN LENGTH.

NOTE: ALL PIPE FROM HOUSE TO SEPTIC TANK MUST BE CAST IRON OR SCHEDULE 40 PVC OR ABS.

PERMIT VOID AFTER THREE YEARS.


NOTE: INSTALL STAND PIPE ON SEPTIC TANK AND DRY WELL. STAND PIPES MUST BE 6 INCHES IN DIAMETER CAST IRON, CONCRETE OR TERRA COTTA, OR PVC OR ABS ACCEPTED. IF TOP OF SEPTIC TANK IS DEEPER THAN 3 FEET MANHOLE TO GRADE REQUIRED

***INSTALLER IS RESPONSIBLE FOR OBTAINING FINAL APPROVAL ON THIS PERMIT**

CALL 800-2300 FOR INSPECTION OF SEPTIC SYSTEMS.

EH - 2-1082

AS 24931-1
A Repair

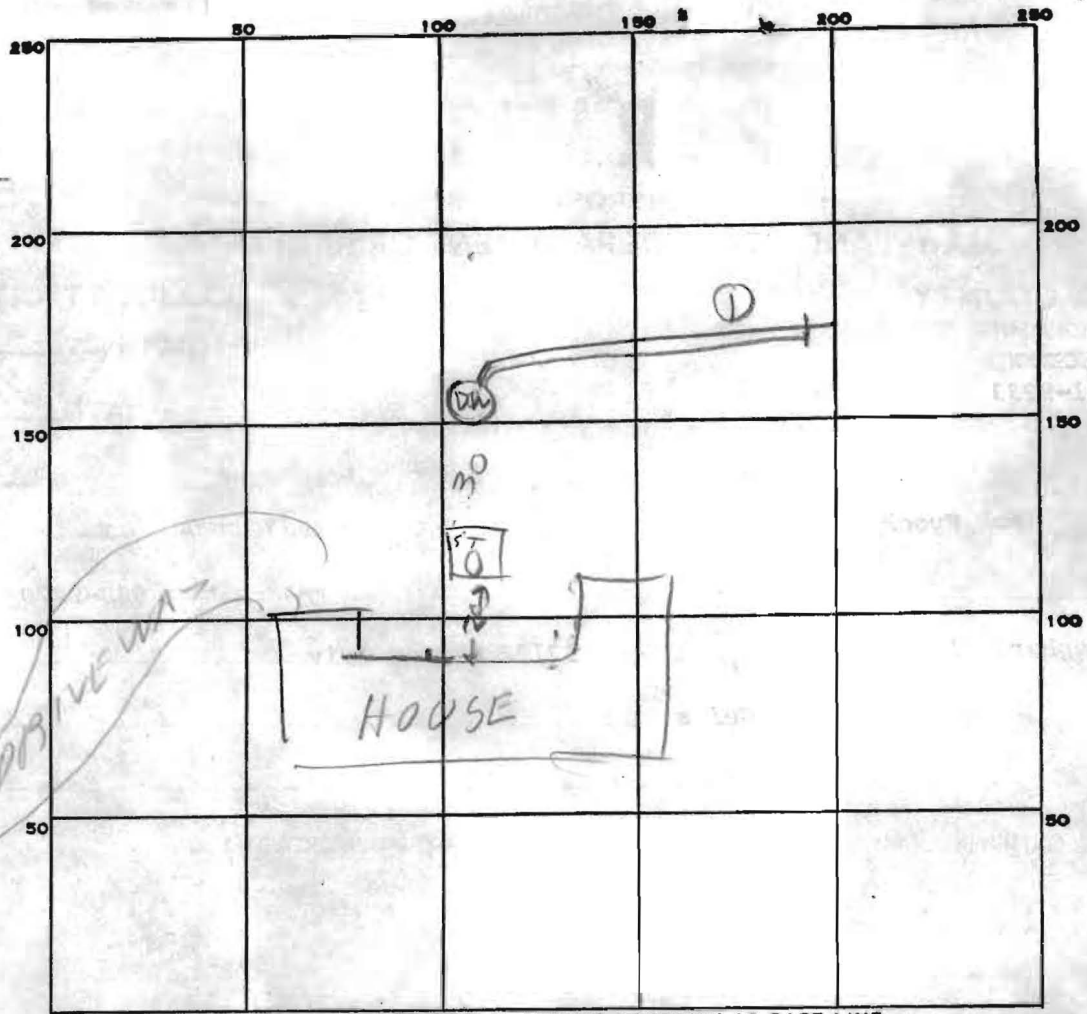

INDICATE NORTH. - NAME ADJOINING ROADWAY AS BASE LINE.

PERMIT CARD _____

SEPTIC TANK, LEVEL _____ CLEANOUTS _____

DISTRIBUTION BOX, LEVEL _____

TILE FIELD, DEPTH 12 FT. TRENCH WIDTH 2 FT.

GRAVEL DEPTH 9 FT IN. TOTAL LENGTH 78 FT.

NUMBER OF TRENCHES 1 TOTAL BOTTOM AREA 624

BELOW TOP
4 FT OF CLAY

SEEPAGE PITS, INSIDE DIAMETER _____ FT. DEPTH BELOW INLET _____ FT.

ABSORBENT AREA _____ SQ. FT.

REMARKS
 4/25/86¹⁰⁰ OLD DW IN USE MANY YEARS & IS 12 FT DEEP
 4/25/86¹⁰³⁰ WAITED UNTIL STONE ADDED
 TO DITCH. SOIL OK BELOW 4 FT
 4 BR - 500 SQ FT REQUIRED
 WELL ON OPPOSITE OF HOUSE FROM
 TRENCH

DATE SYSTEM APPROVED 4/25/86 INSPECTOR Raymond Dodge

OWNER: Jim Phelps

DATE REQUESTED: _____

ADDRESS: 13194 Skyway Drive
Ellicott City, MD 21042


DRILLER: George Easterday

WELL TAG # _____

COUNTY # 13

PROPOSAL: _____

LOCATION DIAGRAM

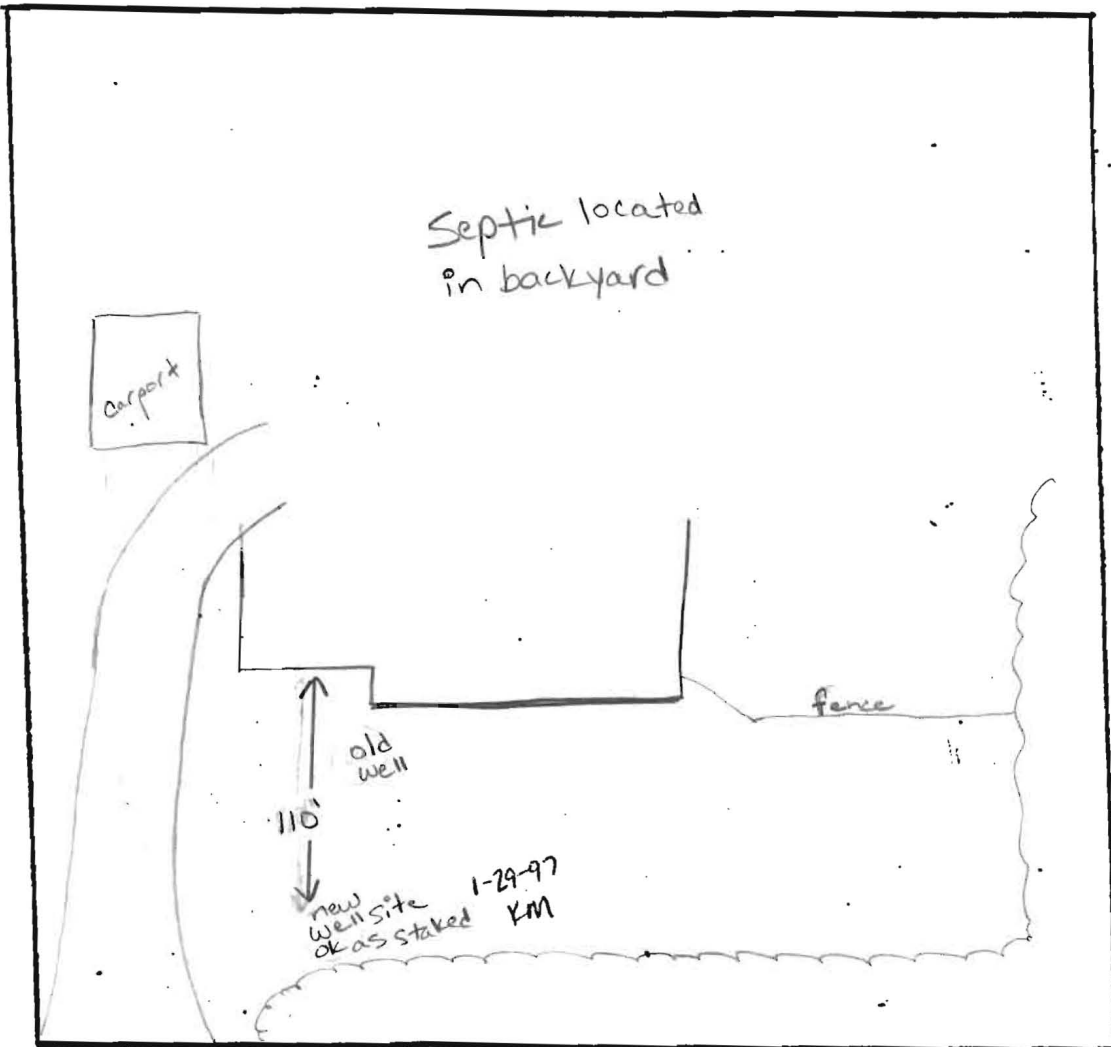

COMMENTS: 1-21-97 no one home for WST. KM (drawing made from road)

1-29-97 well site ok as staked by driller KM

DATE: 1-29-97

INSPECTOR: Kim Mristo