

PUB. SEWER STATUS VERIFIED BY _____

ISSUE DATE: 03/16/06

P 524357

APPROVAL DATE: 4/21/06

A 524357

PERMIT
INDEXED

FAX ID # 04-314905

ON-SITE SEWAGE DISPOSAL SYSTEM
HOWARD COUNTY HEALTH DEPARTMENT
BUREAU OF ENVIRONMENTAL HEALTH

Hatfields Equipment IS PERMITTED TO INSTALL ALTER

ADDRESS: PO Box 519, Annapolis Junction PHONE NUMBER: 301-490-9289

SUBDIVISION: Gwenlee Estates LOT NUMBER: 9-B

ADDRESS: 3297 Sharp Road PROPERTY OWNER: Steven Duvall

SEPTIC TANK CAPACITY (GALLONS): Ex 1000

PUMP CHAMBER CAPACITY (GALLONS): X

NUMBER OF BEDROOMS: 3

SQUARE FEET PER BEDROOM: 180

LINEAR FEET OF TRENCH REQUIRED: 80'

TRENCHES:	Trench to be <u>2</u> feet wide. Inlet <u>5</u> feet below original grade. Bottom maximum depth <u>10.5</u> feet below original grade. Effective area begins at <u>4</u> feet below original grade. <u>5.5</u> feet of stone below distribution pipe.
LOCATION:	<u>Abandon D.w.</u> <u>Trench on Best Contour</u>
PURPOSE:	Existing septic system has failed. Call for inspection when ground is opened so sanitarian can recommend repair.


PLANS APPROVED: [Signature] DATE: 3/21/06

- NOTE: PERMIT VOID AFTER 2 YEARS
- NOTE: CONTRACTOR RESPONSIBLE FOR SCHEDULING A PRE-CONSTRUCTION INSPECTION FOR ALL INSTALLATIONS
- NOTE: WATERTIGHT SEPTIC TANKS REQUIRED
- NOTE: ALL PARTS OF SEPTIC SYSTEM SHALL BE 100 FEET FROM ANY WATER WELL
- NOTE: MANHOLE RISERS REQUIRED ON ALL SEPTIC TANKS AND PUMP CHAMBERS

NEITHER THE HOWARD COUNTY COUNCIL OR THE HEALTH DEPARTMENT IS RESPONSIBLE FOR THE SUCCESSFUL OPERATION OF ANY SYSTEM PERMITTED RESPONSIBLE FOR OBTAINING FINAL APPROVAL ON THIS PERMIT CALL 410-313-2640 FOR INSPECTION OF SEPTIC SYSTEM

4524357

NOT TO SCALE

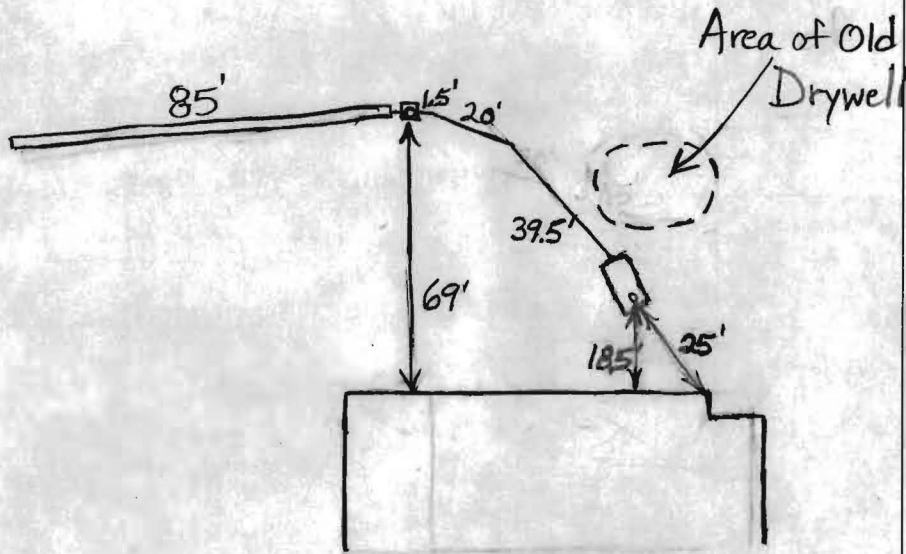

TRENCH/DRAINFIELD DATA		
WIDTH	INLET,	BOTTOM
2	4.5	10'
NUMBER OF TRENCHES, 1		
TOTAL LENGTH 85'		
ABSORPTION AREA 468		
DISTRIBUTION BOX LEVEL Yes		
DISTRIBUTION BOX BAFFLE Yes		
DISTRIBUTION BOX PORT Yes		

SEPTIC TANK DATA	
SEPTIC TANK 1 LEVEL	Yes
CAPACITY	_____ GAL
SEAM LOC	Midseam
TANK LID DEPTH	2.5'
BAFFLES	Yes
BAFFLE FILTER	None
MANHOLE LOC	None
6" PORT LOC	Front
WATERTIGHT TEST	No
SEPTIC TANK 2 LEVEL	N/A
CAPACITY	_____ GAL
SEAM LOC	_____
TANK LID DEPTH	_____
BAFFLES	_____
BAFFLE FILTER	_____
MANHOLE LOC	_____
6" PORT LOC	_____
WATERTIGHT TEST	_____

Sharp

ROAD

PRE-CONSTRUCTION _____

INSTALLATION 4/21/06 Drywell pumped out and filled in per Hatfields. Trench installed, O.K. to backfill. (BB)

FINAL INSPECTOR B. Baker

DATE OF APPROVAL 4/21/06