

9/16/75
Final approved
H.S.

PERMIT

SEWAGE DISPOSAL SYSTEM

MARYLAND STATE DEPARTMENT OF HEALTH

HOWARD COUNTY

INDEXED

P. 22091

A. 18341

ELLCOTT CITY

DISTRICT 3

DATE 9/5/74

Jim Drittingham

IS PERMITTED TO INSTALL ALTER

ADDRESS Burntwoods, Road, Glenwood, Maryland

PHONE 489-7240

A SEWAGE DISPOSAL SYSTEM LOCATED AT

SUBDIVISION Gwenlea Estates

ROAD

3297 Sharp Rd. & Grand Dr.
Burntwoods Rd.

LOT 9, Blk. B,
Sec. 1

PROPERTY OWNER ~~Jack Finnegan~~ Steven Duvall

ADDRESS

SPECIFICATIONS - 3 bedrooms

DRAIN FIELD _____ DEPTH _____ FEET, BOTTOM AREA _____ SQ. FT.

SEEPAGE PITS _____ ABSORBENT SIDE-WALL AREA _____ SQ. FT.

SEPTIC TANK CAPACITY 1,000 GALLONS

FOR GARBAGE GRINDER, INCREASE DISPOSAL AREA 22% & TANK CAPACITY 80%.

OTHER Dry well - 625 sq. ft. absorbent sidewall area to begin below the first 4 1/2 ft.

of non-porous soil. Max. depth is 11 1/2 ft. Locate dry well 80 ft. from right side line

and 100 ft. from front lot line as seen from Sharp Road.

NOTE: ALL PIPE FROM HOUSE TO DISPOSAL AREA MUST BE CAST IRON.

PERMIT VOID AFTER THREE YEARS.

NOTE: INSTALL STAND PIPES ON SEPTIC TANK AND DRY WELL. STAND PIPES MUST BE 6" IN DIA.,
CAST IRON, CONCRETE OR TERRA COTTA ACCEPTED.

PLANS APPROVED BY Robert V. Torre

DATE 2/11/74


FILL SEPTIC TANK AND DISTRIBUTION BOX WITH WATER BEFORE CALLING FOR AN INSPECTION. COVER NO WORK UNTIL INSPECTED AND APPROVED.

NEITHER THE HOWARD COUNTY COMMISSIONERS NOR THE HEALTH DEPARTMENT IS RESPONSIBLE FOR THE SUCCESSFUL OPERATION OF ANY SYSTEM.

BLDG. PERMIT SIGNED
AND RETURNED 9/26/74
Serial # 21447-
addition on slab

BLDG. PERMIT SIGNED
AND RETURNED 9/26/74
Serial # 65353
Pool

A 18341

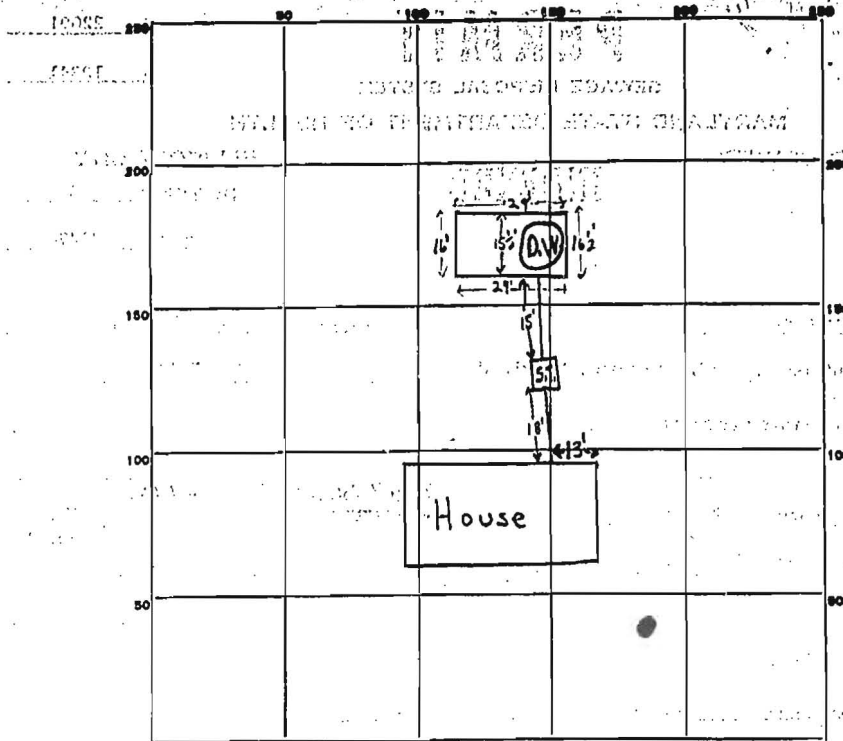

Well?

INDICATE NORTH. - NAME ADJOINING ROADWAY AS BASE LINE.

Sharp Road

PERMIT CARD Signed final overall work

SEPTIC TANK, LEVEL 1000 gal. S.T. O.K. D.W. O.K.

CLEANOUTS O.K. O.K.

DISTRIBUTION BOX, LEVEL _____

TILE FIELD, DEPTH _____ FT. TRENCH WIDTH _____ FT.

GRAVEL DEPTH _____ IN. TOTAL LENGTH _____ FT.

NUMBER OF TRENCHES _____ TOTAL BOTTOM AREA _____

SEEPAGE PITS, INSIDE DIAMETER 90 FT. DEPTH BELOW INLET 7 FT.

OUTSIDE PERIMETER _____

ABSORBENT AREA 630 SQ. FT.

REMARKS _____

DATE SYSTEM APPROVED 9/16/75 INSPECTOR Frank Skinner