

LAYOUT 12/4/06 INSP 4 _____
 INSP 2 12/5/06 INSP 5 _____
 INSP 3 _____ INSP 6 _____

ISSUE DATE: 12/01/06
 APPROVAL DATE: 12/6/06

PERMIT
INDEXED
 TAX ID # 04-363000

P 525659
 A 57611-C

ON-SITE SEWAGE DISPOSAL SYSTEM
HOWARD COUNTY HEALTH DEPARTMENT
BUREAU OF ENVIRONMENTAL HEALTH

MAYNES BACKHOE & SEPTIC, INC IS PERMITTED TO INSTALL ALTER

ADDRESS: 11723 LEGOREBRIDGE ROAD PHONE NUMBER: 301.898.0955

SUBDIVISION: SPRING HOLLOW LOT NUMBER: 26

ADDRESS: 17255 HARDY ROAD PROPERTY OWNER: PETTIT HOMES OF MD, LLC

SEPTIC TANK CAPACITY (GALLONS): 1500 OUTLET BAFFLE FILTER REQUIRED

PUMP CHAMBER CAPACITY (GALLONS): n/a COMPARTMENTED TANK REQUIRED

NUMBER OF BEDROOMS: 5

SQUARE FEET PER BEDROOM: 180

LINEAR FEET OF TRENCH REQUIRED: 189

TRENCHES:	Trench to be 2 feet wide. Inlet 2 feet below original grade. Bottom maximum depth 6 feet below original grade. Effective area begins at 3 feet below original grade. 4 feet of stone below distribution pipe.
LOCATION:	Place the distribution box as shown on the approved building permit plan
NOTES:	

PLANS APPROVED: Kevin Bell REVIEWED BY: _____ DATE: 3/07/06


- NOTE: PERMIT VOID AFTER 2 YEARS
- NOTE: CONTRACTOR RESPONSIBLE FOR SCHEDULING A PRE-CONSTRUCTION INSPECTION FOR ALL INSTALLATIONS
- NOTE: WATERTIGHT SEPTIC TANKS REQUIRED
- NOTE: ALL PARTS OF SEPTIC SYSTEM SHALL BE 100 FEET FROM ANY WATER WELL
- NOTE: MANHOLE RISERS REQUIRED ON ALL SEPTIC TANKS AND PUMP CHAMBERS UNLESS SPECIFICALLY AUTHORIZED

NEITHER THE HOWARD COUNTY COUNCIL NOR THE HEALTH DEPARTMENT IS RESPONSIBLE FOR THE SUCCESSFUL OPERATION OF ANY SYSTEM PERMITTEE RESPONSIBLE FOR OBTAINING FINAL APPROVAL ON THIS PERMIT CALL 410-313-2640 FOR INSPECTION OF SEPTIC SYSTEM BUILDING PERMIT SIGNED AND RETURNED

12/7/06 B06607220 1000 GAL UG LP TANK

0525659

NOT TO SCALE

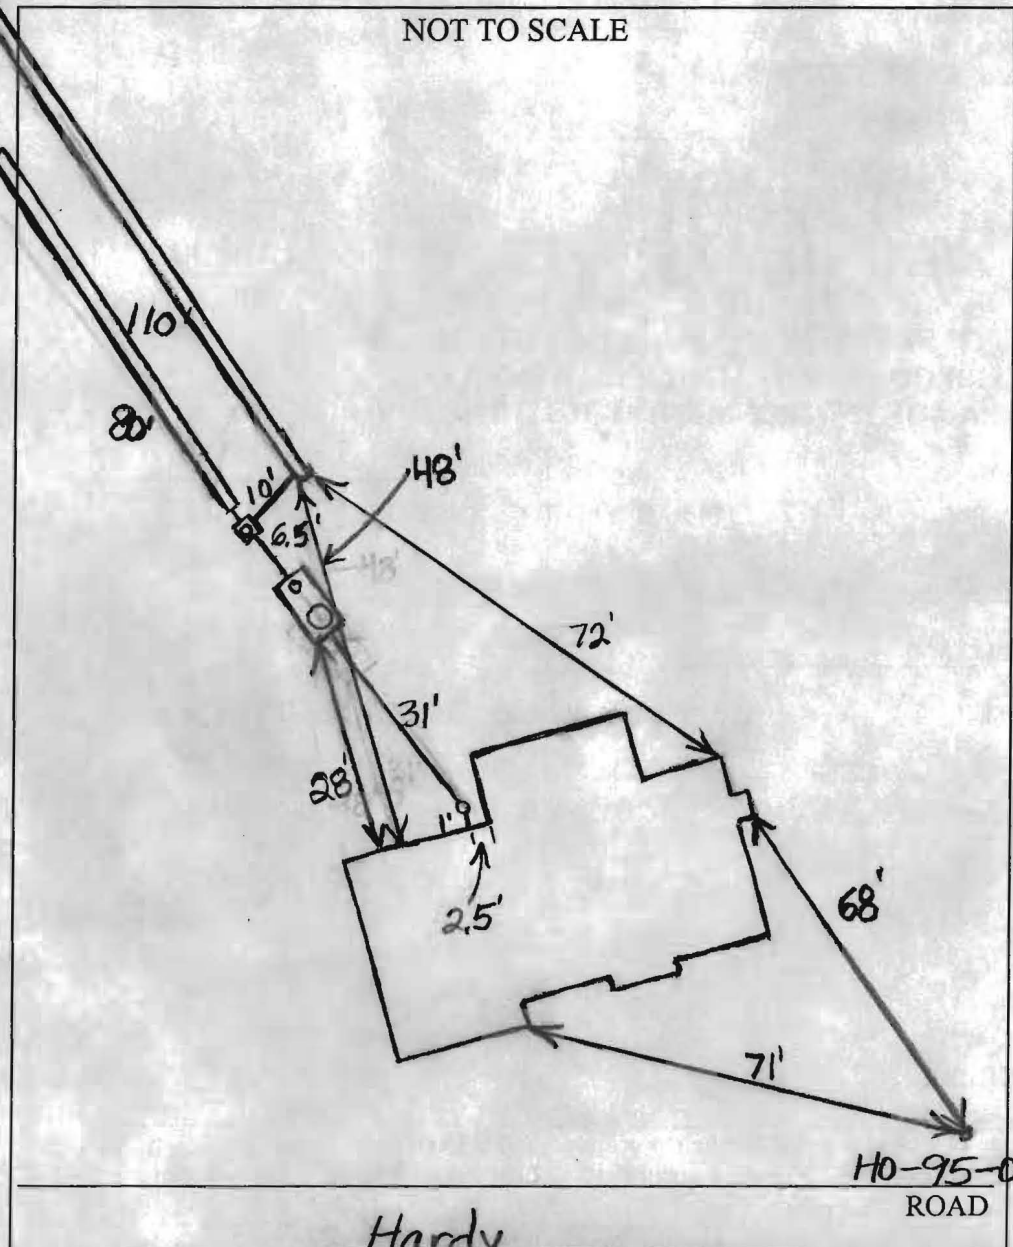

TRENCH/DRAINFIELD DATA		
WIDTH	INLET	BOTTOM
2'	2	6'
NUMBER OF TRENCHES		2
TOTAL LENGTH		190'
ABSORPTION AREA		760
DISTRIBUTION BOX LEVEL		To Install
DISTRIBUTION BOX BAFFLE		Yes
DISTRIBUTION BOX PORT		Yes

SEPTIC TANK DATA	
SEPTIC TANK 1 LEVEL	Yes
CAPACITY	1500 GAL
SEAM LOC	Top
TANK LID DEPTH	0.5-1.5'
BAFFLES	Yes
BAFFLE FILTER	No
MANHOLE LOC	Front
6" PORT LOC	Rear
WATERTIGHT TEST	No
SEPTIC TANK 2 LEVEL	N/A
CAPACITY	_____ GAL
SEAM LOC	_____
TANK LID DEPTH	_____
BAFFLES	_____
BAFFLE FILTER	_____
MANHOLE LOC	_____
6" PORT LOC	_____
WATERTIGHT TEST	_____

2 Comp. Babylon

HO-95-0156 ROAD

Hardy

PRE-CONSTRUCTION 12/4/06 Contour is off slightly from what is shown on the B.P. plan. I install trenches as per INSTALLATION location drawn on B.P. plan. (BB)

12/5/06 Need levelers in distribution box and manhole cleanout. O.K. to backfill (BB) 12/6/06 Manhole cleanout installed. (BB)


FINAL INSPECTOR B. Baker

DATE OF APPROVAL 12/6/06

BUILDING PERMIT SIGNED

GENERAL NOTES:

- 1) THIS LOCATION DRAWING IS PREPARED FOR THE BENEFIT OF THE CLIENT SIGNING THE HOUSE LOCATION SURVEY APPROVAL FORM INsofar AS IT IS REQUIRED BY A LENDER OR TITLE INSURANCE COMPANY OR ITS AGENTS IN CONNECTION WITH THE CONTEMPLATED TRANSFER, FINANCING OR REFINANCING OF THE PROPERTY SHOWN HEREON. UNLESS INDICATED AS BEING A BOUNDARY SURVEY, THIS LOCATION DRAWING IS NOT INTENDED FOR USE IN THE ESTABLISHMENT OF PROPERTY LINES AND IS NOT TO BE RELIED UPON FOR THE ESTABLISHMENT OR LOCATIONS OF FENCES, GARAGES, BUILDINGS OR OTHER EXISTING OR FUTURE IMPROVEMENTS. AS A RESULT, THIS LOCATION DRAWING DOES NOT PROVIDE FOR ACCURATE IDENTIFICATION OF PROPERTY LINES, BUT SUCH IDENTIFICATION MAY NOT BE REQUIRED FOR THE TRANSFER OF TITLE OR SECURING FINANCING FOR RE-FINANCING.
- 2) SUBJECT PROPERTY IS SHOWN IN ZONE C ON THE NATIONAL FLOOD INSURANCE PROGRAM FLOOD INSURANCE RATE MAP OF HOWARD COUNTY, MARYLAND, COMMUNITY PANEL No. 2400440007B EFFECTIVE DEC. 4, 1986.
- 3) THE OFFSETS FROM BUILDING LINE TO PROPERTY LINE AS SHOWN ON THE PLAT HEREON ARE TO AN ACCURACY OF PLUS OR MINUS 1' (*)
- 4) NO TITLE REPORT FURNISHED. SUBJECT TO ALL EASEMENTS, RIGHTS OF WAY AND CONDITIONS OF RECORD.
- 5) THE EXISTING WELL(S) SHOWN ON THIS PLAN (IDENTIFIED WITH THE ATTACHED WELL TAG NUMBER HO- 95 - 1056) HAS BEEN FIELD LOCATED BY FISHER, COLLINS AND CARTER, INC. PROFESSIONAL LAND SURVEYORS AND IS ACCURATELY SHOWN.

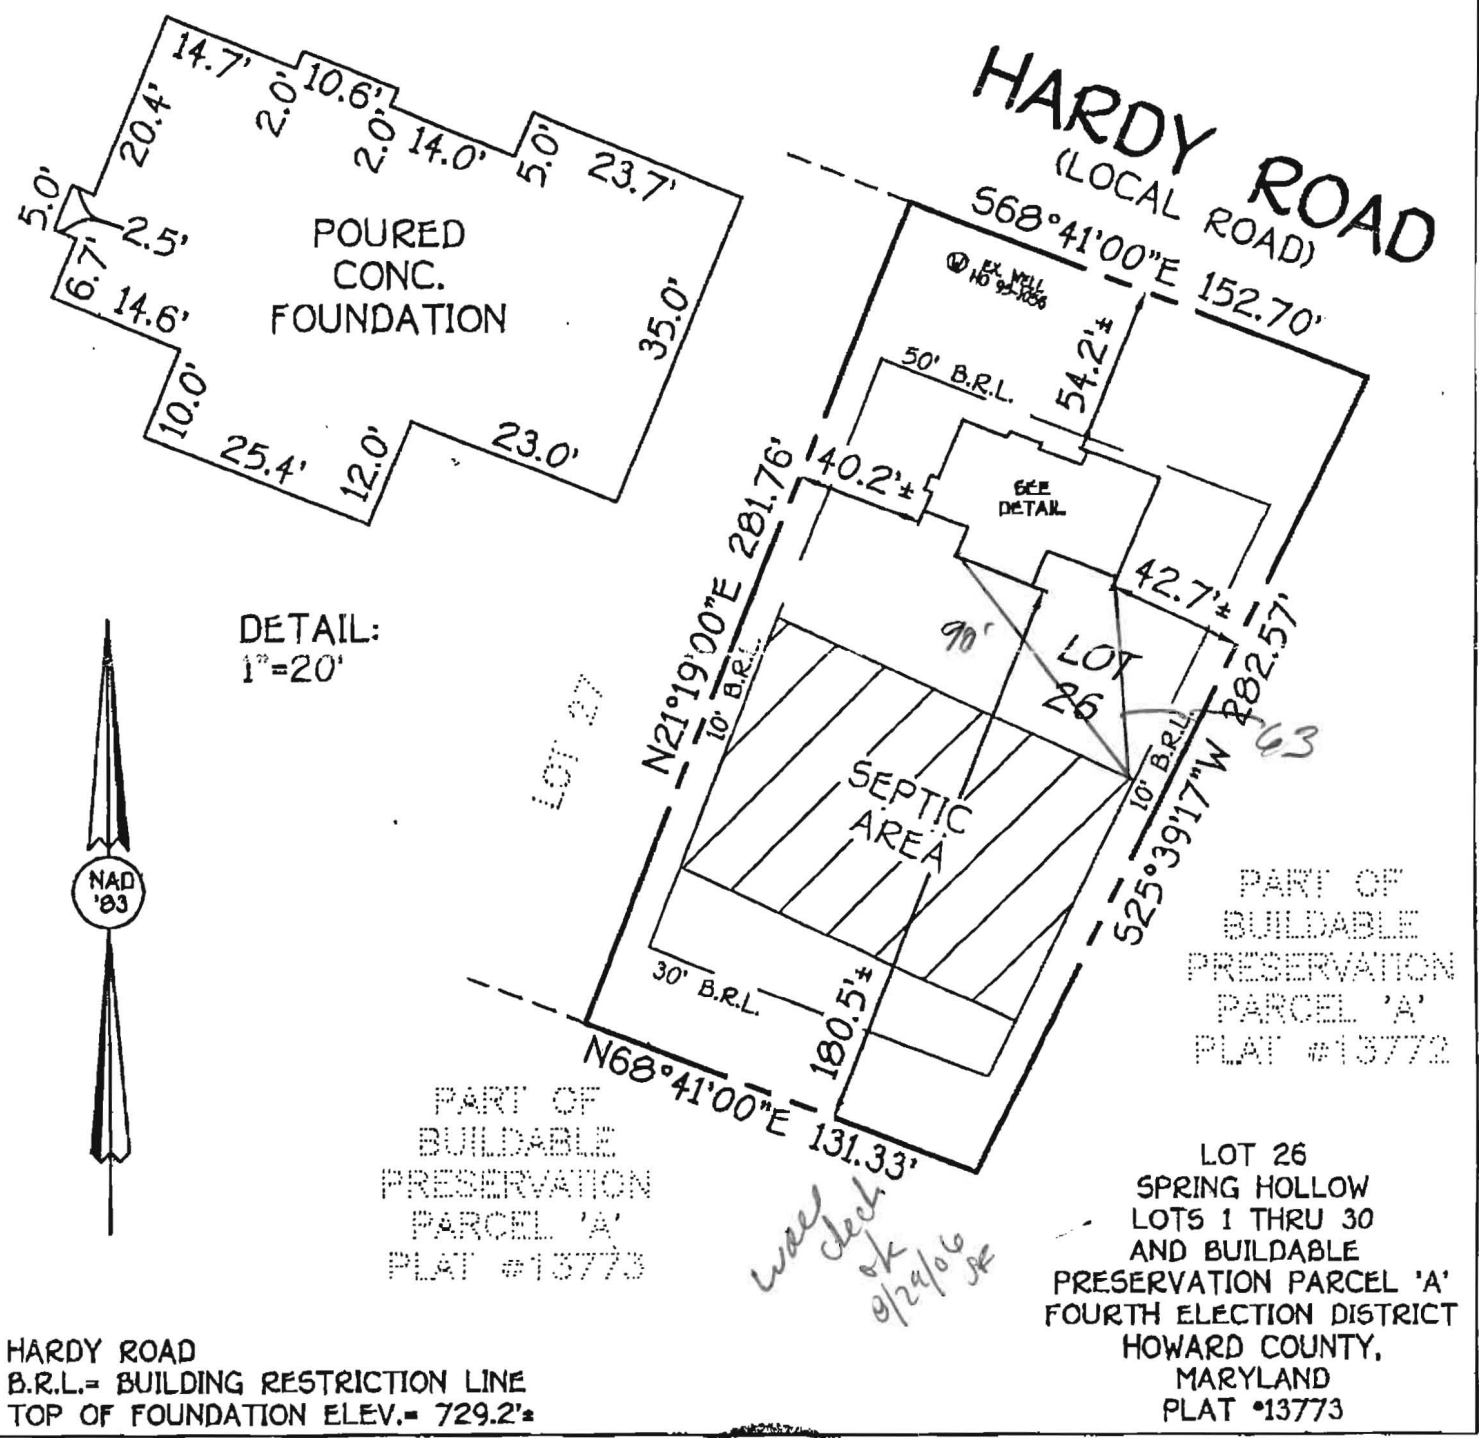

HARDY ROAD
 B.R.L.= BUILDING RESTRICTION LINE
 TOP OF FOUNDATION ELEV.= 729.2'

FISHER, COLLINS & CARTER, INC.
 CIVIL ENGINEERING CONSULTANTS & LAND SURVEYORS
 CENTENNIAL SQUARE OFFICE PARK - 10272 BALTIMORE NATIONAL PIKE
 ELLIDOTT CITY, MARYLAND 21042
 (410) 481 - 2255

FCC •

STATE OF MARYLAND
 MARK L. ROBEL
 NO. 339
 REGISTERED
 PROPERTY LINE SURVEYOR

Mark L. Robel 6/06/06
 PROFESSIONAL LAND SURVEYOR DATE
 REG. # 339

HOUSE LOCATION DRAWING

FOUNDATION LOCATION: 5/31/06
 FINAL LOCATION: _____
 BOUNDARY SURVEY: _____

SCALE: 1"=60'
 DATE: 06/06/06
 DRAWN BY: VLJ
 CHECKED BY: MLR
 PROJECT No.: 05140-6001



Howard County Health Department
7178 Columbia Gateway Drive,
Columbia, MD 21046


RE: Septic Systems at 17255 and 17231 Hardy Road Mt Airy, MD 21771

To Whom It May Concern:

Pettit Homes Of Maryland wishes to have the septic permit for the above mentioned addresses transferred from Walter W. King Plumbing and Heating to Mayne's Backhoe & Septic Inc. of 11723 Legore Bridge Road Kemar, MD 12757 as we have awarded the septic contract to Mayne's Backhoe & Septic Inc.

Your anticipated help in this matter is greatly appreciated. If there is anything further you may need please do not hesitate to call me at 301-252-3088.

Sincerely, harveywallick

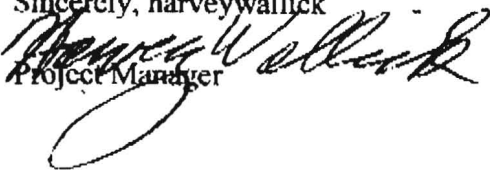
Project Manager

