

Permit
9/14/83
9:30 AM

APPLICATION

SEWAGE DISPOSAL TESTING

STATE OF MARYLAND - DEPARTMENT OF HEALTH AND MENTAL HYGIENE

A 33082

HOWARD COUNTY HEALTH DEPARTMENT
ENVIRONMENTAL HEALTH SERVICES

P. O. BOX 476 ELLICOTT CITY, MARYLAND 21043
TELEPHONE: 992-2330

DISTRICT 3rd

DATE August 24, 1983

TO: THE COUNTY HEALTH OFFICER
ELLICOTT CITY, MARYLAND

I, HEREBY, APPLY FOR THE NECESSARY TEST IN ORDER TO CONSTRUCT (OR RECONSTRUCT) A SEWAGE DISPOSAL SYSTEM.

PROPERTY OWNER MARTIN KLINE
~~Kenard Warfield c/o Tracy, Schulte & Associates~~

ADDRESS 8450 Baltimore National Pike PHONE 465-6105
Ellicott City, Maryland 21043

PROPERTY LOCATION:

SUBDIVISION Warfield LOT NO. 2 LOT NEW 6

ROAD AND DESCRIPTION Burnt Wood Road West of St. Rt. 32

13855 Burntwoods Dr.

SIZE OF LOT 6.2 Acres TYPE BLDG. Vacant
(NUMBER OF BEDROOMS)

THE SYSTEM INSTALLED UNDER THIS APPLICATION IS ACCEPTABLE ONLY UNTIL PUBLIC FACILITIES BECOME AVAILABLE. I FULLY UNDERSTAND THE FEE CONNECTED WITH THE FILING OF THIS PERC TEST APPLICATION IS NON-REFUNDABLE UNDER ANY CIRCUMSTANCES. I ALSO AGREE TO COMPLY WITH ALL M.O.S.H.A. REQUIREMENTS IN TESTING THIS LOT.

APPROVED BY Raymond Hodges FOR James K. Tracy (SIGNATURE OF APPLICANT) DATE 7/24/85

REJECTED BY _____ FOR _____ DATE _____

HOLD PENDING FURTHER TESTS _____ DATE _____

REASONS FOR REJECTION OR HOLDING 10/17/83 PERC OK HOLD FOR PLAT R.H.
7/12/85 Speed Muller R.H.

BLDG. PERMIT SIGNED AND RETURNED 10/20/86

S. Abel
BP 8415

THIS IS NOT A PERMIT

SOIL PROFILE

0

INDICATE NORTH - NAME ADJOINING ROADWAY AS BASE LINE.

DATE	TEST NO.	DEPTH	PRE-WET		TEST - 1" DROP		TIME
			START	STOP	START	STOP	

REMARKS _____

TYPE OF SOIL _____

TESTED BY _____ ALSO PRESENT _____

EH-12-1079

APPLICATION

SEWAGE DISPOSAL TESTING

A 33082

STATE OF MARYLAND - DEPARTMENT OF HEALTH AND MENTAL HYGIENE

P _____

HOWARD COUNTY HEALTH DEPARTMENT
ENVIRONMENTAL HEALTH SERVICES
P. O. BOX 478 ELLICOTT CITY, MARYLAND 21043
TELEPHONE: 992-2330

DISTRICT 3rd

DATE August 24, 1983

TO: THE COUNTY HEALTH OFFICER
ELLICOTT CITY, MARYLAND

I, HEREBY, APPLY FOR THE NECESSARY TEST IN ORDER TO CONSTRUCT (OR RECONSTRUCT) A SEWAGE DISPOSAL SYSTEM.

PROPERTY OWNER Kennard Warfield c/o Tracy, Schulte & Associates

ADDRESS 8450 Baltimore National Pike PHONE 465-6105
Ellicott City, Maryland 21043

PROPERTY LOCATION:

SUBDIVISION Warfield LOT NO. LOT NEW 6

ROAD AND DESCRIPTION Burnt Wood Road West of St. Rt. 32

SIZE OF LOT 6.2 Acres TYPE BLDG. Vacant
(NUMBER OF BEDROOMS)

THE SYSTEM INSTALLED UNDER THIS APPLICATION IS ACCEPTABLE ONLY UNTIL PUBLIC FACILITIES BECOME AVAILABLE. I FULLY UNDERSTAND THE FEE CONNECTED WITH THE FILING OF THIS PERC TEST APPLICATION IS NON-REFUNDABLE UNDER ANY CIRCUMSTANCES. I ALSO AGREE TO COMPLY WITH ALL M.O.S.H.A. REQUIREMENTS IN TESTING THIS LOT.

James K. Tracy
(SIGNATURE OF APPLICANT)

APPROVED BY _____ FOR _____ DATE _____

REJECTED BY _____ FOR _____ DATE _____

HOLD PENDING FURTHER TESTS _____ DATE _____


REASONS FOR REJECTION OR HOLDING _____

THIS IS NOT A PERMIT

496.55

Lot 2
LOT 2

724.03

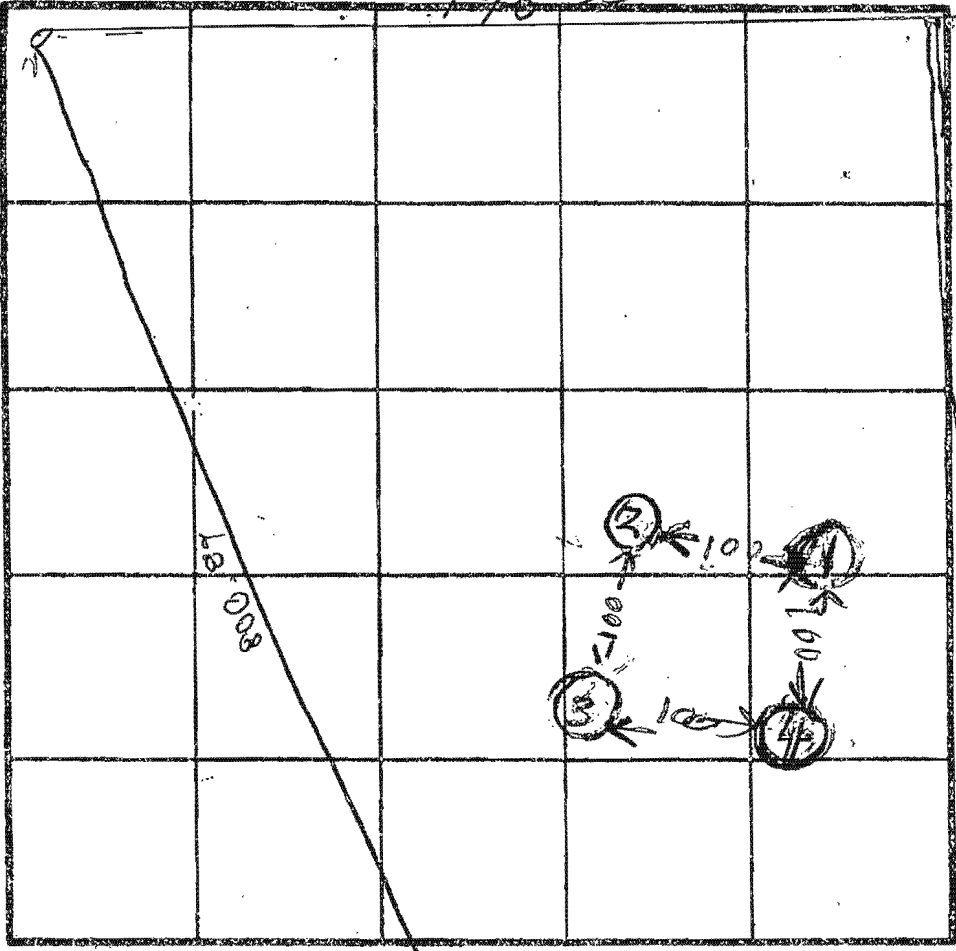

HOLE ELEVATION
 ① HIGH
 ② LOW
 ③ LOW
 ④ HIGH

INDICATE NORTH - NAME ADJOINING ROADWAY AS BASE LINE.

SOIL PROFILE
 ①
 BROWN CLAY
 BROWN SAND

②
 BROWN CLAY
 BROWN SANDY SILTY LOAM

③
 BROWN CLAY
 BROWN SANDY LOAM
 GRAY SANDY

④
 BROWN CLAY
 TAN SAND

DATE	TEST NO.	DEPTH	PRE-WET		TEST - 1" DROP		TIME
			START	STOP	START	STOP	
9/1/83	1 S 1 V	5.5 13	115 LOOKS	125 OK	122	128	7
9/1/83	2 S 2 V	4 13	149 LOOKS	55 OK	155	209	14
	3 S 3 V	4 13	231 LOOKS	233 OK	233	238	5
10/7/83	4 V	14	LOOKS OK				

REMARKS PERC HOLES PER SURVEYOR STAKES IN WOODS

TYPE OF SOIL

TESTED BY R. HODGES

ALSO PRESENT SKIP CASSBUN

EH-12-1079

