

APPLICATION

SEWAGE DISPOSAL TESTING

STATE OF MARYLAND - DEPARTMENT OF HEALTH AND MENTAL HYGIENE

HOWARD COUNTY HEALTH DEPARTMENT
ENVIRONMENTAL HEALTH SERVICES
P. O. BOX 476 ELLICOTT CITY, MARYLAND 21043
TELEPHONE: 992-2330

A 3354P

P _____

DISTRICT 3rd

DATE 2/8/84

2/22/84 - 9:30 A.M.
2/21/84
9:30 A.M.

TO: THE COUNTY HEALTH OFFICER
ELLICOTT CITY, MARYLAND

I, HEREBY, APPLY FOR THE NECESSARY TEST IN ORDER TO CONSTRUCT (OR RECONSTRUCT) A SEWAGE DISPOSAL SYSTEM.

PROPERTY OWNER Wm. S. Hebb

ADDRESS Porto Bello Farm, Drayden, Md. PHONE _____

PROPERTY LOCATION:

SUBDIVISION Hebb Property LOT NO. 1, 2, 3, 4

ROAD AND DESCRIPTION Rt 144, 24.87 A., tax map 15, parcel 39

SIZE OF LOT lot 144-50a, ~~50a~~ TYPE BLDG. _____ (NUMBER OF BEDROOMS) _____

THE SYSTEM INSTALLED UNDER THIS APPLICATION IS ACCEPTABLE ONLY UNTIL PUBLIC FACILITIES BECOME AVAILABLE. I FULLY UNDERSTAND THE FEE CONNECTED WITH THE FILING OF THIS PERC TEST APPLICATION IS NON-REFUNDABLE UNDER ANY CIRCUMSTANCES. I ALSO AGREE TO COMPLY

WITH ALL M.O.S.H.A. REQUIREMENTS IN TESTING THIS LOT. Wm. R. Hopkins
(SIGNATURE OF APPLICANT)

APPROVED BY Thomas Dodger FOR Trench or Driveway DATE 12/26/81

REJECTED BY _____ FOR _____ DATE _____

HOLD PENDING FURTHER TESTS _____ DATE _____

REASONS FOR REJECTION OR HOLDING 2/29/84 PERC OK HOLD FOR PLAT R1-
12/26/81 Specimen




THIS IS NOT A PERMIT

SEE PLAT



②

④

①
SOIL PROFILE

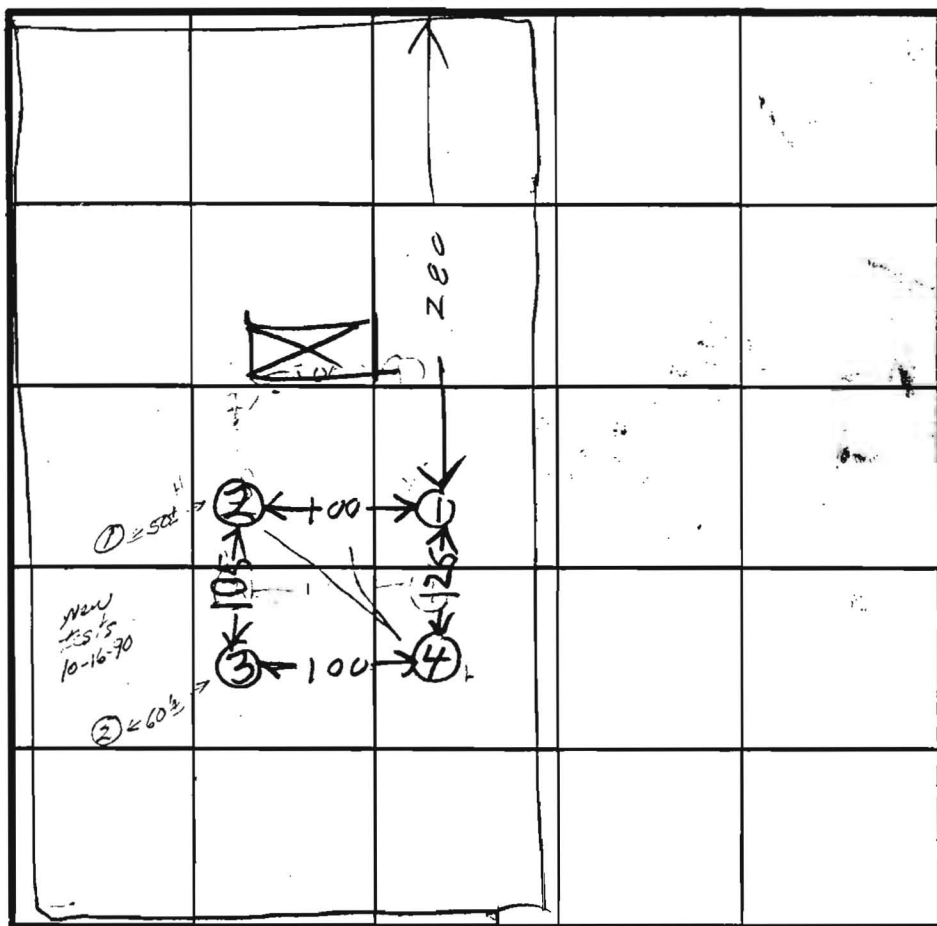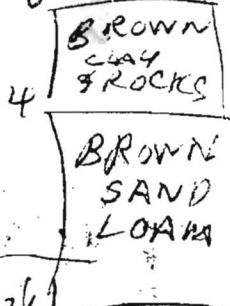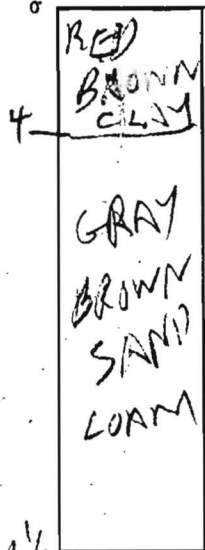

HOLE ELEVATION
④ = LOWEST
② = HIGHEST
① = NEXT HIGHEST
③ = NEXT LOWEST

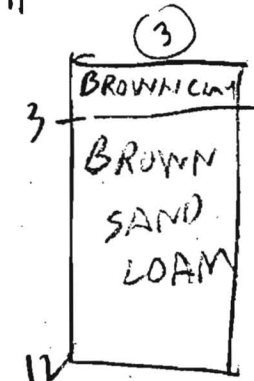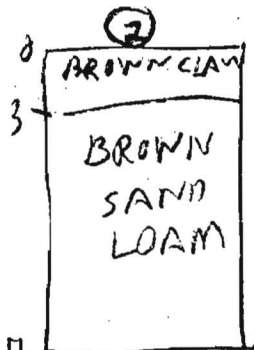

RT 144

DATE	TEST NO.	DEPTH	PRE-WET		TEST - 1" DROP		TIME
			START	STOP	START	STOP	
2/21/84	1S	5 1/2	1237	1238	1235	1240	2
	1V	13 1/2	LOOKS	OK			
	2S	4	124	125	125	126	1
	2V	11	LOOKS	OK			
	3S	4	148	150	150	153	3
	3V	12	LOOKS	OK			
	4S	5	218	222	222	237	15
	4V	12 1/2	LOOKS	OK			
10-16-90	1S	4					2
	1V	13					OK
	2S	3.5					4
	2V	13					OK

REMARKS THESE HOLES ARE NOT PER ENGINEERS PLAT SEE ATTACHED PLAT

TYPE OF SOIL
TESTED BY B HODGES

DEVELOPER W HOPKINS
BACKLIVE OTIS KE TIERMAN
ALSO PRESENT
BALKHOE JEFF

EH-12-1079

APPLICATION

PERCOLATION TESTING

A 46314
P _____

HOWARD COUNTY HEALTH DEPARTMENT
BUREAU OF ENVIRONMENTAL HEALTH
P.O. BOX 476 ELLICOTT CITY, MARYLAND 21043
TELEPHONE: 461-9933

DISTRICT Third
DATE Aug. 22, 1990

TO: THE COUNTY HEALTH OFFICER
ELLICOTT CITY, MARYLAND

I, HEREBY, APPLY FOR THE NECESSARY TEST IN ORDER TO CONSTRUCT (OR RECONSTRUCT) A SEWAGE DISPOSAL SYSTEM.

PROPERTY OWNER William R. Hopkin CHARLES C FEAGA, JR.

ADDRESS 3138 Rogers Ave., Ellicott City, Md. 21043 PHONE 461-5391
(301) 465-8891

PROSPECTIVE BUYER N/A

ADDRESS _____ PHONE _____

PROPERTY LOCATION:

SUBDIVISION Hebb Property, Lots 1 -4 LOT NO. 1

ROAD AND DESCRIPTION South side of Md. Rte. 144, 1650' ± East of Md. Rte. 32.
(12235 Frederick Road)

TAX MAP 15 PARCEL # 39

SIZE OF LOT 3 acres ± TYPE BLDG. Commercial
(SINGLE FAMILY DWELLING OR COMMERCIAL)

*4 BEDROOMS
CHANGED TO SFD*

THE SYSTEM INSTALLED UNDER THIS APPLICATION IS ACCEPTABLE ONLY UNTIL PUBLIC FACILITIES BECOME AVAILABLE. I FULLY UNDERSTAND THE FEE CONNECTED WITH THE FILING OF THIS PERC TEST APPLICATION IS NON-REFUNDABLE UNDER ANY CIRCUMSTANCES. I ALSO AGREE TO COMPLY WITH ALL M.O.S.H.A. REQUIREMENTS IN TESTING THIS LOT.

William R. Hopkin
(SIGNATURE OF APPLICANT)

APPROVED BY _____ FOR _____ DATE _____

REJECTED BY _____ FOR _____ DATE _____

HOLD PENDING FURTHER TESTS _____ DATE _____

REASONS FOR REJECTION OR HOLDING _____



BLDG. PERMIT SIGNED
AND RETURNED 12/20/93
Serial # 51982
SFD - 4 Bedroom

THIS IS NOT A PERMIT

BACK


374.45
W

SOIL PROFILE

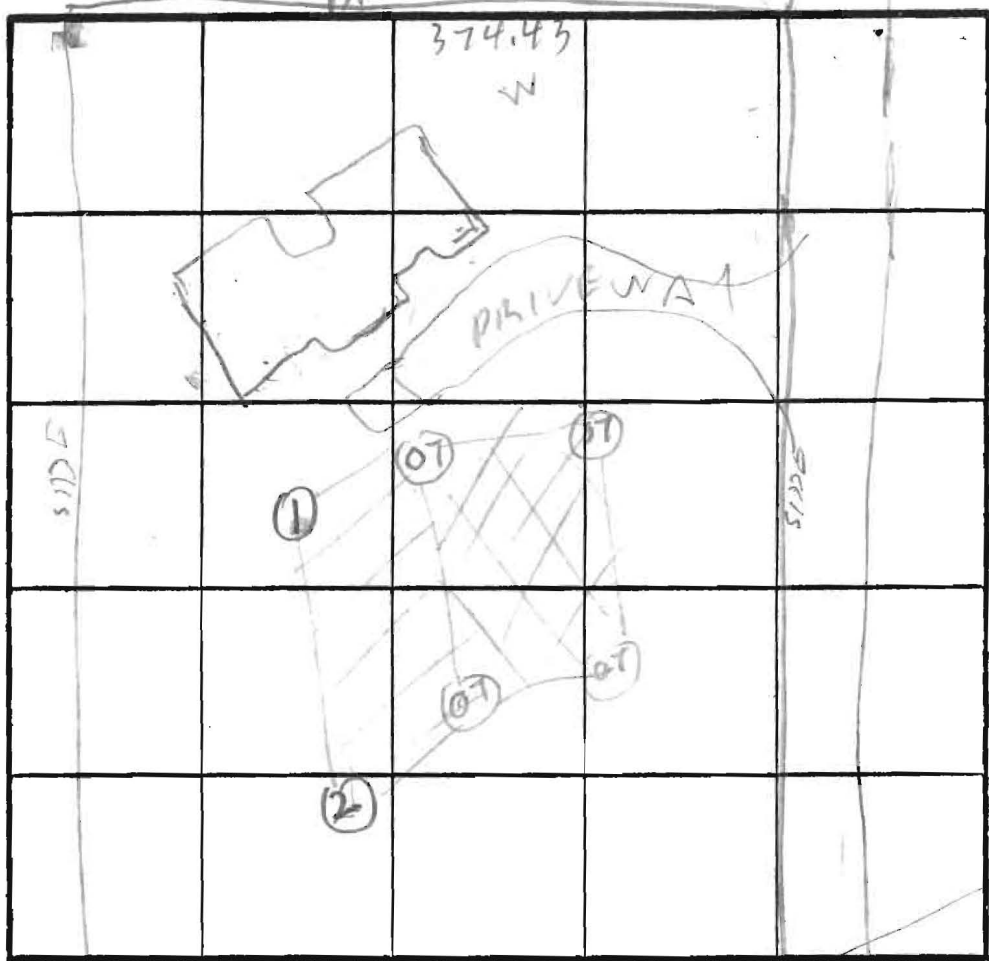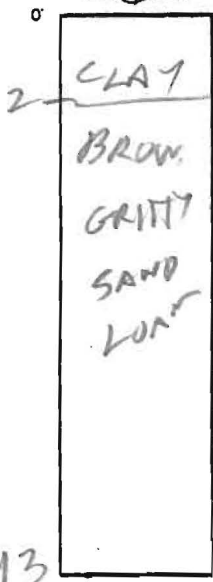

OT = OLD TEST

INDICATE NORTH - NAME ADJOINING ROADWAY AS BASE LINE.

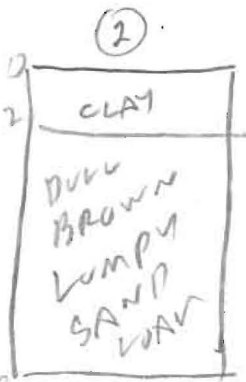

DATE	TEST NO.	DEPTH	PRE-WET		TEST - 1" DROP		TIME
			START	STOP	START	STOP	
10/16/90	13	4	1231	1232	1232	1234	2
	14	1.3	OK				
1	25	3.5	1237	1238	1238	1241	4
	24		OK				
OT = OLD TESTS							

REMARKS _____

TYPE OF SOIL _____

TESTED BY B. Hoppers

ALSO PRESENT RICK JACK OF T-YORK

EH-12-1079