

5/8/85
9:30

APPLICATION

6351A2

SEWAGE DISPOSAL TESTING

STATE OF MARYLAND - DEPARTMENT OF HEALTH AND MENTAL HYGIENE

P _____

HOWARD COUNTY HEALTH DEPARTMENT
ENVIRONMENTAL HEALTH SERVICES

P. O. BOX 476 ELLICOTT CITY, MARYLAND 21043
TELEPHONE: 992-2330

DISTRICT 4th

DATE 3/27/85

TO: THE COUNTY HEALTH OFFICER
ELLICOTT CITY, MARYLAND

I, HEREBY, APPLY FOR THE NECESSARY TEST IN ORDER TO CONSTRUCT (OR RECONSTRUCT) A SEWAGE DISPOSAL SYSTEM.

PROPERTY OWNER JAMES + LINDA BOGARD

ADDRESS 2850 DAISY RD WOODBINE PHONE 854-6411
953-5000 x 7715

PROPERTY LOCATION:

SUBDIVISION DAISY RD LOT NO. 1

ROAD AND DESCRIPTION DAISY RD - on right hand side before you
get to DAISY GARAGE, NAME + HOUSE NUMBER ON MAILBOX

SIZE OF LOT 3-4 acres TYPE BLDG. residential
(NUMBER OF BEDROOMS)

THE SYSTEM INSTALLED UNDER THIS APPLICATION IS ACCEPTABLE ONLY UNTIL PUBLIC FACILITIES BECOME AVAILABLE. I FULLY UNDERSTAND THE
FEE CONNECTED WITH THE FILING OF THIS PERC TEST APPLICATION IS NON-REFUNDABLE UNDER ANY CIRCUMSTANCES. I ALSO AGREE TO COMPLY
WITH ALL M.O.S.H.A. REQUIREMENTS IN TESTING THIS LOT.

Linda L Bogard
(SIGNATURE OF APPLICANT)

APPROVED BY _____ FOR _____ DATE _____

REJECTED BY _____ FOR _____ DATE _____



HOLD PENDING FURTHER TESTS _____ DATE _____

REASONS FOR REJECTION OR HOLDING OWNER NOTIFIED BY PHONE TO HAVE ENGINEER CONTACT THIS DEPT
TO DISCUSS SUBDIVISION PLANS. 5/8/85 CW

THIS IS NOT A PERMIT

14243

SOIL PROFILE

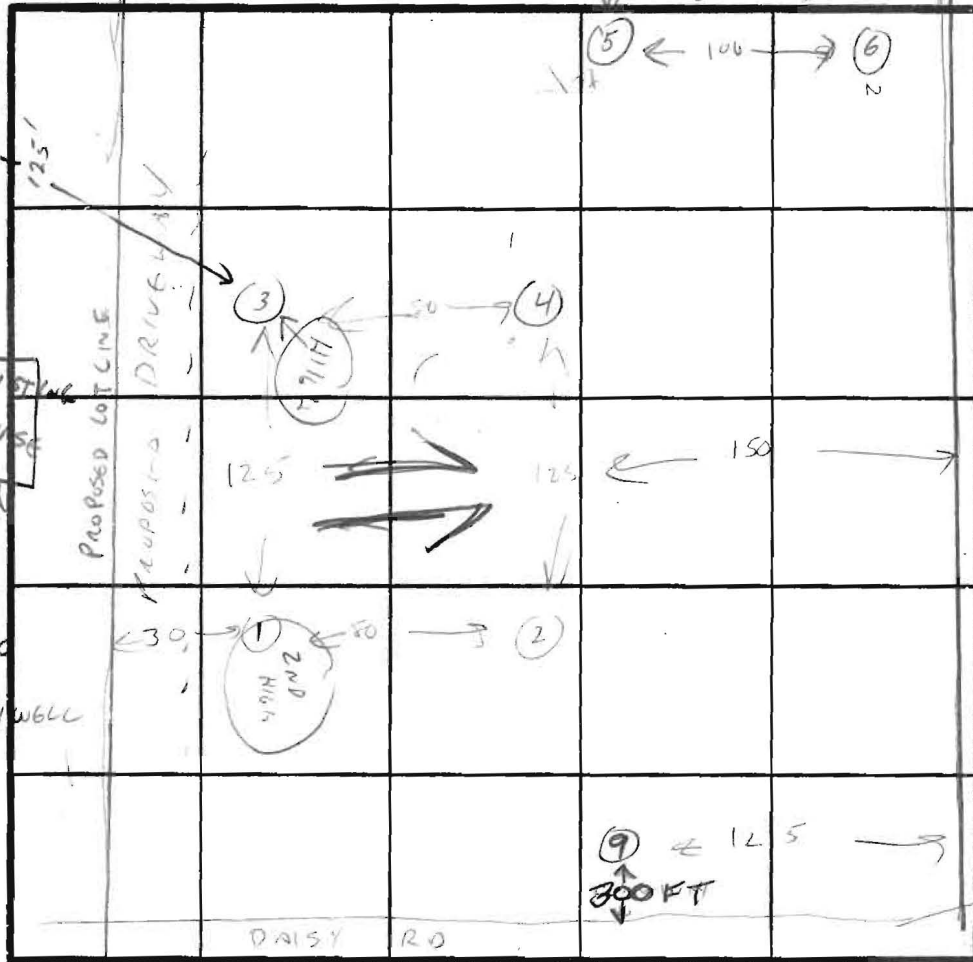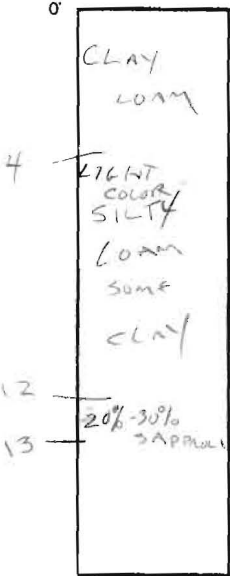

INDICATE NORTH - NAME ADJOINING ROADWAY AS BASE LINE.

DATE	TEST NO.	DEPTH	PRE-WET		TEST - 1' DROP		TIME
			START	STOP	START	STOP	
5/8/85	1	4	11:10	11:16	11:16	11:23	7 MIN
		9	11:11	11:20	11:20	11:33	13 MIN
		13	VIS	OK			
5/8/85	2	4	11:16	11:21	11:21	11:32	11 MIN
		9	11:14	11:21	11:21	11:28	7 MIN
		13	VIS	OK			
5/8/85	3	4	11:21	11:27	11:27	11:38	11 MIN
		9	11:23	11:40	11:40	11:58	18 MIN
		13	VIS	OK			
5/8/85	4	4	11:30	11:36	11:36	11:43	7 MIN
		8	11:27	11:31	11:31	11:39	8 MIN
		13	DARK				
5/8/85	5-6-7-8	SIMILAR TO HOLES 1-2-3				5-12 MINUTES IF TESTED	
5/8/85	9	NOT TESTED CLAY & WATER				CLAY TO 4' LOAM FROM 4-13'	

AVG X
12'
INLET 4'
BOTTOM 9'
START AT HOLE (2)



TEST #9



10,000 SQ FT ESTABLISHED BY PATTERN 1-2-3-4 BUT PDS NOT LEAVE SUFFICIENT REPAIR AREA FOR EXISTING LOT.

REMARKS ∴ HOLES 1-2-3 SHOULD BE INCLUDED IN REPAIR AREA FOR EXISTING LOT AND NEW ALTERNATE AREA 5-6-7-8 SHOULD BE USED FOR THIS LOT.

TESTED BY C. Willard ALSO PRESENT WAYNE (OF ARNOLD SEPTIC)

EH-12-1079

