

LAYOUT _____ INSP 4 _____

INSP 2 _____ INSP 5 _____

INSP 3 _____ INSP 6 _____

ISSUE DATE: _____

P _____

APPROVAL DATE: _____

A535743

PERMIT

INDEXED

TAX ID # 04-344472

ON-SITE SEWAGE DISPOSAL SYSTEM HOWARD COUNTY HEALTH DEPARTMENT BUREAU OF ENVIRONMENTAL HEALTH

_____ IS PERMITTED TO INSTALL ALTER

ADDRESS: _____ PHONE NUMBER: _____

SUBDIVISION: Woodcamp Farms LOT NUMBER: 19

ADDRESS: 17565 Hardy Road PROPERTY OWNER: Mark Terry

SEPTIC TANK CAPACITY (GALLONS): _____ OUTLET BAFFLE FILTER REQUIRED

PUMP CHAMBER CAPACITY (GALLONS): _____ COMPARTMENTED TANK REQUIRED

NUMBER OF BEDROOMS: _____

SQUARE FEET PER BEDROOM: _____

LINEAR FEET OF TRENCH REQUIRED: _____


TRENCHES:	Trench to be _____ feet wide. Inlet _____ feet below original grade. Bottom maximum depth _____ feet below original grade. Effective area begins at _____ feet below original grade. _____ feet of stone below distribution pipe.
LOCATION:	
NOTES:	

PLANS APPROVED: _____ DATE: _____

- NOTE: PERMIT VOID AFTER 2 YEARS
- NOTE: CONTRACTOR RESPONSIBLE FOR SCHEDULING A PRE-CONSTRUCTION INSPECTION FOR ALL INSTALLATIONS
- NOTE: WATERTIGHT SEPTIC TANKS REQUIRED
- NOTE: ALL PARTS OF SEPTIC SYSTEM SHALL BE 100 FEET FROM ANY WATER WELL
- NOTE: MANHOLE RISERS REQUIRED ON ALL SEPTIC TANKS AND PUMP CHAMBERS UNLESS SPECIFICALLY AUTHORIZED

NEITHER THE HOWARD COUNTY COUNCIL NOR THE HEALTH DEPARTMENT IS RESPONSIBLE FOR THE SUCCESSFUL OPERATION OF ANY SYSTEM PERMITTED RESPONSIBLE FOR OBTAINING FINAL APPROVAL ON THIS PERMIT CALL 410-313-2640 FOR INSPECTION OF SEPTIC SYSTEM

A 535743

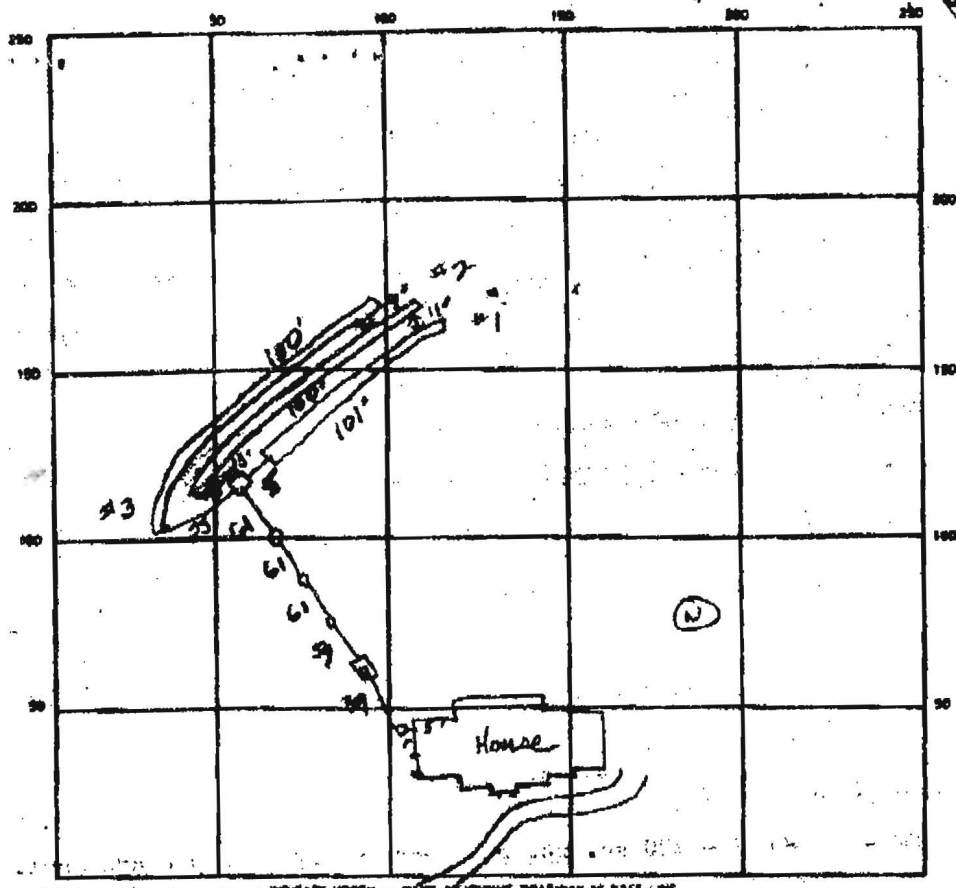

Gresnu

INDICATE NORTH - BASE ADJOINING ROADWAY AS BASE LINE

Hardy Rd

SEPTIC TANK LEVEL 2000 gpl CLEANOUTS Lat house, 3 in line, 1 on s. tank

DISTRIBUTION BOX LEVEL ok w/ baffle

DRAIN FIELD/TILE FIELD DEPTH 5 FT TRENCH WIDTH 3 FT INLET DEPTH 3 3 2.5 FT

EFFECTIVE GRAVEL DEPTH 2.0 2.0 2.5 FT TOTAL LENGTH 101 100 100 FT

NUMBER OF TRENCHES 3 ONE SIDEWALL BOTTOM AREA 303 300 300 SQ FT

DRYWELL INSIDE DIAMETER _____ FT EFFECTIVE DEPTH BELOW INLET _____ FT

ABSORBENT AREA 903 SQ FT

REMARKS 11-21-89 Trenches were covered except at tail ends.
Lines connecting trenches were open at distribution box.
Ok to cover all work JEN

DATE SYSTEM APPROVED 11-21-89 INSPECTOR Anne F. Nadeau