


2794

brown 1
 o-b s:cl 2 1/2
 o-b-r ab s:cl 3 1/2
 heavy b-o heavy brown 5
 yellow brown silt/bay 3
 silt 1/4

2792
 brown 1
 o-r-b s:cl ab 3
 silt o-r-b heavy 5
 y-b s:cl 5
 1/3-1/5
 < 5% chert frags

2798
 brown 1
 o-b heavy 1 3
 o-b-r s:cl 5
 yellow b/white 1/5
 w/ < 5% frags

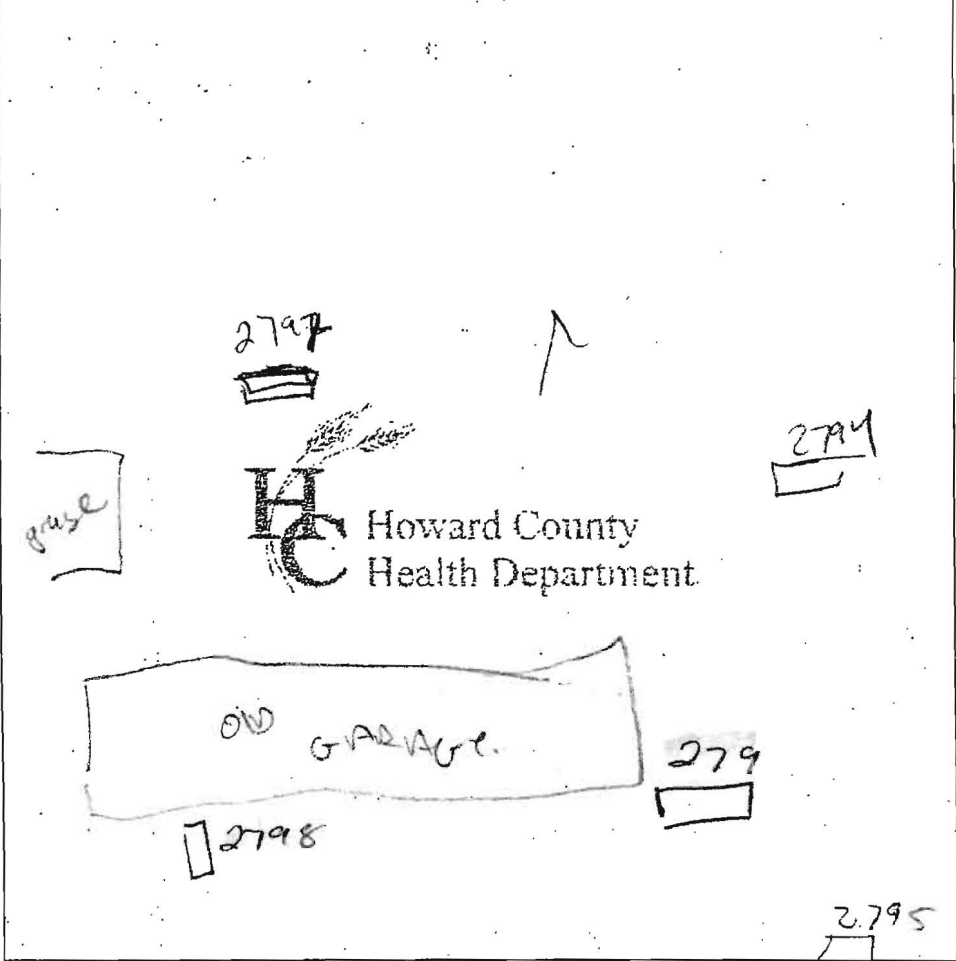

2795
 brown 1
 o-b-red s:cl ab 3
 o-b-r heavy s:cl 6
 y-b s:cl-s:cl 7
 heavy y-b 1/5 massive

2799
 brown 1
 o-b s:cl 5
 red-o brown s:cl 6
 yellow brown white s:cl 1
 1/5

DATE	TEST #	DEPTH	START	BREAK 1" DROP	STOP 2" DROP	TIME OF 2nd INCH	P/F/H
✓	2797	5/13	12:22	12:24	12:27	3 P	
✓	2798	5/13	12:30	12:58	1:22	24 P	
✓	2799	6/13	12:47	12:58	1:10	12 P	
✓	2794	5 1/4/13	1:10	1:13	1:17	4 P	
* 279 - will go faster another 1 drop							


REMARKS Deep tanks
 SANITARIAN PM BACKHOE KVR OTHERS _____
 TEST HOLES USED IN SDA _____ AVG. PERC TIME _____ SQ. FT/BR _____
 TRENCH WIDTH _____ INLET DEPTH 3 MAX. BOT DEPTH 8 EFFECTIVE SW C

13

AP 4351
 Red Br Heavy Loam 3.5'-5'
 Red Br Si. Loam and Or Br Sa Loam ~10% Rock 5.5'
 Or Br Sa Loam ~10% Rock 13.5'

4352
 Red Br Heavy Loam 4'
 Red Br Loam Very Little Rock 5.5'
 Tan Sa Loam 10-15% Saprolite 13.5'

4353
 Red Br Heavy Loam 4'-5'
 Red Br Loam Very Little Rock 5.5'-6'
 Beige Sa Loam ~15% Saprolite

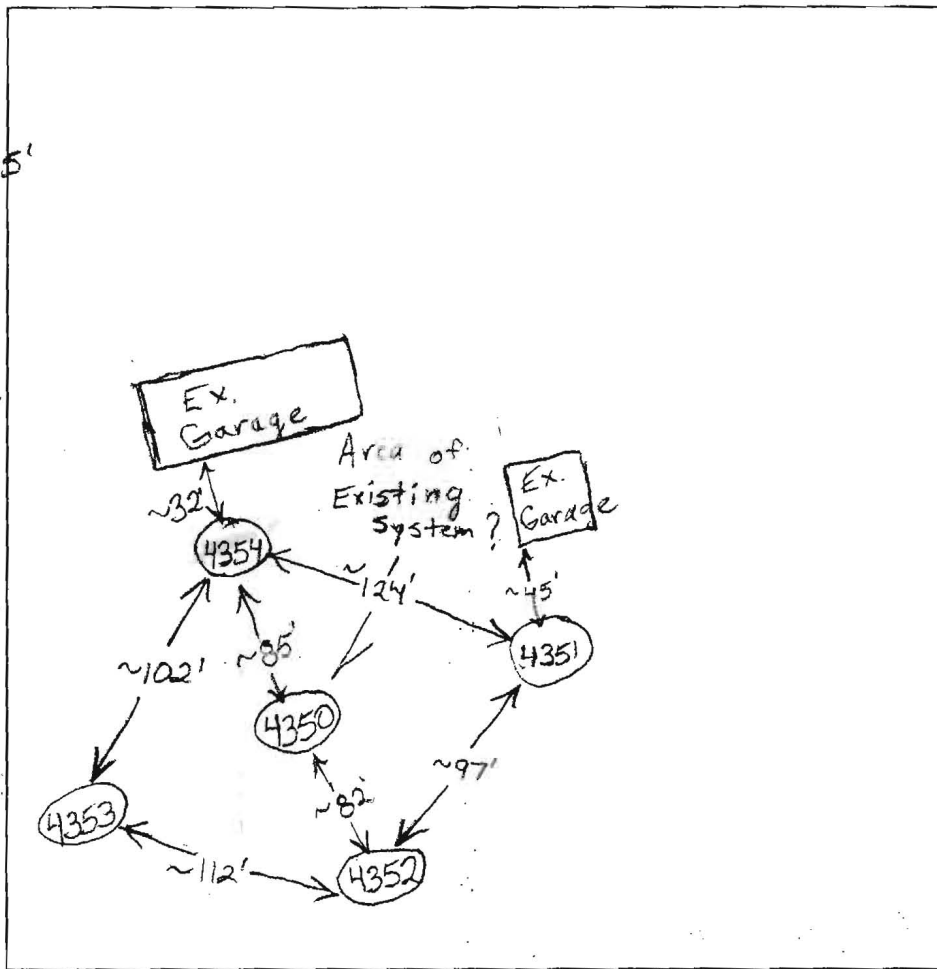

4354
 Red Br Heavy Loam 4'-5'
 Red Br Loam Very Little Rock 5'-5.5'
 Light Br Sa Loam 10-15% Saprolite 13.5'

4350
 Red Br Heavy Loam 4'-4.5'
 Red Br Loam Scarce Rock 5.5'-6'
 Or Br Sa Loam 15-20% Saprolite 13.5'

DATE	TEST #	DEPTH	START	BREAK 1" DROP	STOP 2" DROP	TIME OF 2nd INCH	P/F/H
9/17/03	4351	7'/13.5'	9:53	9:54:45	9:54:45	9:58	~3 O.K.
	4352	6'3"/13.5'	10:03:30	10:05	10:05	10:07	2 O.K.
	4350	13.5'	— See Profile —>				O.K.
	4353	6.5'/13.5'	10:18:15	10:20:15	10:20:15	10:23:45	3 1/2 O.K.
	4354	6.5'/13.5'	10:33	10:34:20	10:34:20	10:35:45	4 1/2 O.K.

REMARKS _____
 SANITARIAN B. Baker BACKHOE K+K OTHERS _____
 TEST HOLES USED IN SDA _____ AVG. PERC TIME _____ SQ. FT/BR _____
 13.5' TRENCH WIDTH _____ INLET DEPTH _____ MAX. BOT DEPTH _____ EFFECTIVE SW _____

