



Howard County  
Health Department

# APPLICATION

## FOR PERCOLATION TESTING AND SITE EVALUATION

TEST DATE(S) \_\_\_\_\_

TEST TIME \_\_\_\_\_

AP 522987

AGENCY REVIEW: \_\_\_\_\_

DATE 7/22/05

**DO NOT WRITE ABOVE THIS LINE**

I HEREBY APPLY FOR THE NECESSARY TESTING/EVALUATION PRIOR TO ISSUANCE OF SEWAGE DISPOSAL SYSTEM PERMIT(S) TO:

CHECK AS NEEDED:

- CONSTRUCT NEW SEPTIC SYSTEM(S)
- REPAIR/ADD TO AN EXISTING SEPTIC SYSTEM
- REPLACE AN EXISTING SEPTIC SYSTEM

CHECK AS NEEDED:

- NEW STRUCTURE(S)
- ADDITION TO AN EXISTING STRUCTURE
- REPLACE AN EXISTING STRUCTURE

CHECK ONE:

- CREATE NEW LOT(S)
- BUILD ON AN EXISTING LOT IN A SUBDIVISION
- BUILD ON AN EXISTING PARCEL OF RECORD

IS THE PROPERTY WITHIN 2500' OF ANY RESERVOIR?

- YES
- NO

THE TYPE OF STRUCTURE IS:

- RESIDENTIAL WITH PROPOSED BEDROOMS IN THE COMPLETED STRUCTURE (NOTE UNKNOWN IF APPROPRIATE)
- COMMERCIAL (PROVIDE DETAIL OF NUMBERS AND TYPES OF EMPLOYEES/CUSTOMERS ON ACCOMPANYING PLAN)
- INSTITUTIONAL/GOVERNMENT (PROVIDE DETAIL OF NUMBERS AND TYPES OF EMPLOYEES/USERS ON ACCOMPANYING PLAN)

PROPERTY OWNER(S)	<b>Frances Devlin</b>			
DAYTIME PHONE	<b>410-997-4600</b>	Goodier Bldrs.	CELL	FAX
MAILING ADDRESS	<b>Echo Farm Route 3, 43 East Litchfield Rd.,</b>		<b>Litchfield</b>	<b>CT 06750</b>
	STREET		CITY/TOWN	STATE ZIP
APPLICANT	<b>Heritage Land Development</b>			
DAYTIME PHONE	<b>410-489-7900</b>	CELL	<b>410-982-2882</b>	FAX <b>410-489-9768</b>
MAILING ADDRESS	<b>3060 Washington Road, Suite 220</b>		<b>Glenwood</b>	<b>MD 21738</b>
	STREET		CITY/TOWN	STATE ZIP
APPLICANT'S ROLE	<input checked="" type="checkbox"/> DEVELOPER	<input type="checkbox"/> BUILDER	<input type="checkbox"/> BUYER	<input type="checkbox"/> RELATIVE/FRIEND
	<input type="checkbox"/> REALTOR	<input type="checkbox"/> CONSULTANT		
PROPERTY LOCATION	<b>Meriweather Farm - Section 3</b>			
SUBDIVISION NAME				LOT NO. <b>84</b>
PROPERTY ADDRESS	<b>14944 Roxbury Road</b>		<b>Glenelg</b>	
	STREET	TOWN/POST OFFICE		
TAX MAP PAGE(S)	<b>21</b>	GRID <b>16</b>	PARCEL(S) <b>28</b>	PROPOSED LOT SIZE <b>1 Acre</b>

AS APPLICANT, I UNDERSTAND THE FOLLOWING: THE SYSTEM INSTALLED SUBSEQUENT TO THIS APPLICATION IS ACCEPTABLE ONLY UNTIL PUBLIC SEWAGE IS AVAILABLE. THIS APPLICATION IS COMPLETE WHEN ALL APPLICABLE FEES AND A SUITABLE SITE PLAN HAVE BEEN RECEIVED. I ACCEPT THE RESPONSIBILITY FOR COMPLIANCE WITH ALL M.O.S.H.A. AND "MISS UTILITY" REQUIREMENTS. APPROVAL IS BASED UPON SATISFACTORY REVIEW OF A PERC CERTIFICATION PLAN. TEST RESULTS WILL BE MAILED TO APPLICANT.


*Jenny Rutter*  
SIGNATURE OF APPLICANT

HOWARD COUNTY HEALTH DEPARTMENT, BUREAU OF ENVIRONMENTAL HEALTH, WELL AND SEPTIC PROGRAM  
3525-H ELLICOTT MILLS DRIVE, ELLICOTT CITY, MARYLAND 21043-4544 (410) 313-1771 FAX (410) 313-2648  
TDD (410) 313-2323 TOLL FREE 1-877-4MD-DHMH

A/P 5116  
 Brown L  
 Brown/Orange heavy L  
 Brown/Yellow Sel  
 Brown/Yellow S1  
 Brown/S12 SL w/ 25% units  
 AB 9'

5212  
 Brown L 2'  
 Orange/Brown Sel w/ 15% chert Qtz 4 1/2'  
 Red/Brown SL 5 1/2'  
 Yellow/Brown SL w/ time Rock 11'

5117  
 Brown L 1'  
 Yellow/Brown Rock Sel 4 1/2'  
 Yellow/Brown SL w/ 10% chert Qtz 5 1/2'  
 Yellow/Brown S1 w/ time Rock 10 1/2'

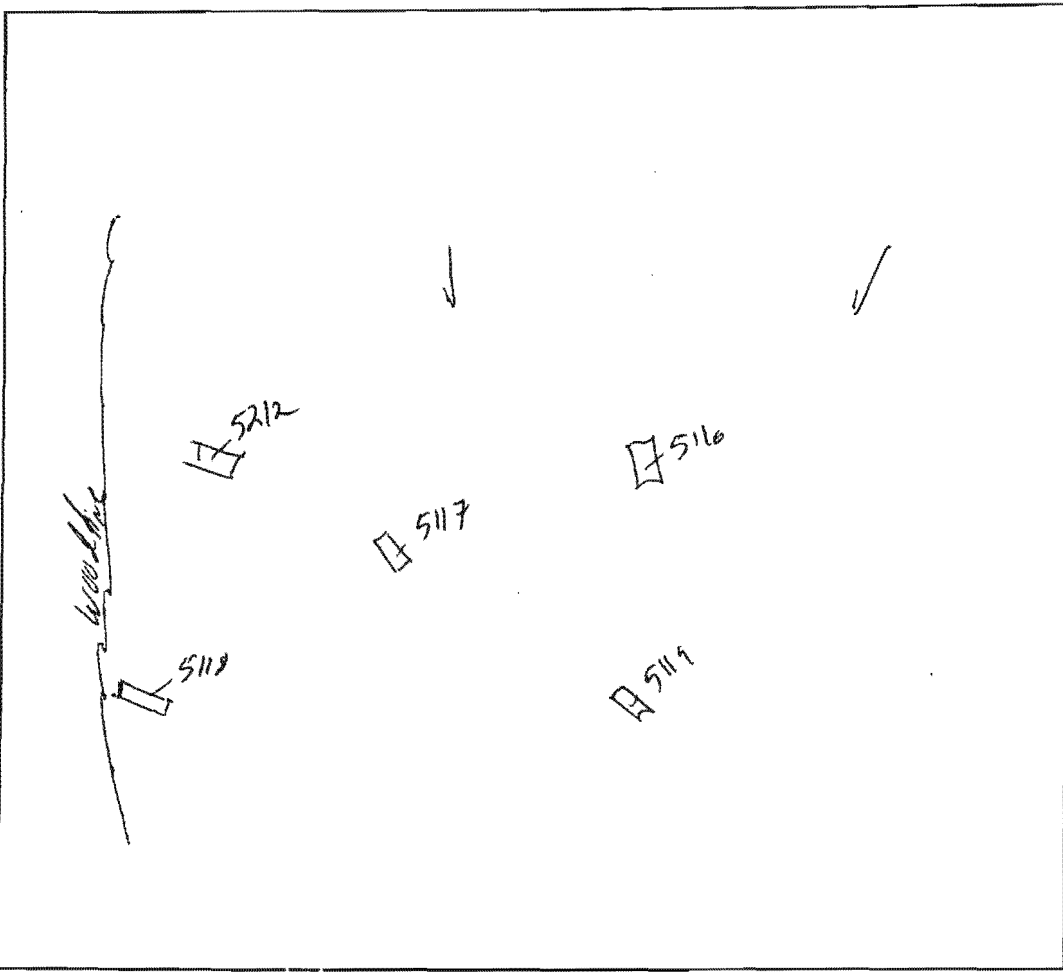


5118  
 Brown L  
 Orange/Brown Sel  
 Yellow/Brown SL  
 Yellow/Brown S1 w/ time Rock

5117  
 Brown L  
 Orange/Yellow Sel  
 Yellow/Brown SL w/ time Rock 11'

DATE	TEST #	DEPTH	START	BREAK 1" DROP	STOP 2" DROP	TIME OF 2nd INCH	P/F/H
9/15/05	5116	5' 9"	7:36	7:44	7:57	13 min	P
	5212	5' 11"	7:38	7:40	7:44	4 min	P
	5117	5' 10 1/2"	- Visual -			OK	P
	5118	5' 12"	7:51	7:54	7:58	4 min	P
	5119	4' 11"	7:57	7:59	8:01	2 min	P

REMARKS lot 75 5116 shared  
 SANITARIAN \_\_\_\_\_ BACKHOE \_\_\_\_\_ OTHERS \_\_\_\_\_  
 TEST HOLES USED IN SDA \_\_\_\_\_ AVG. PERC TIME \_\_\_\_\_ SQ. FT/BR \_\_\_\_\_  
 TRENCH WIDTH \_\_\_\_\_ INLET DEPTH \_\_\_\_\_ MAX. BOT DEPTH \_\_\_\_\_ EFFECTIVE S/W \_\_\_\_\_

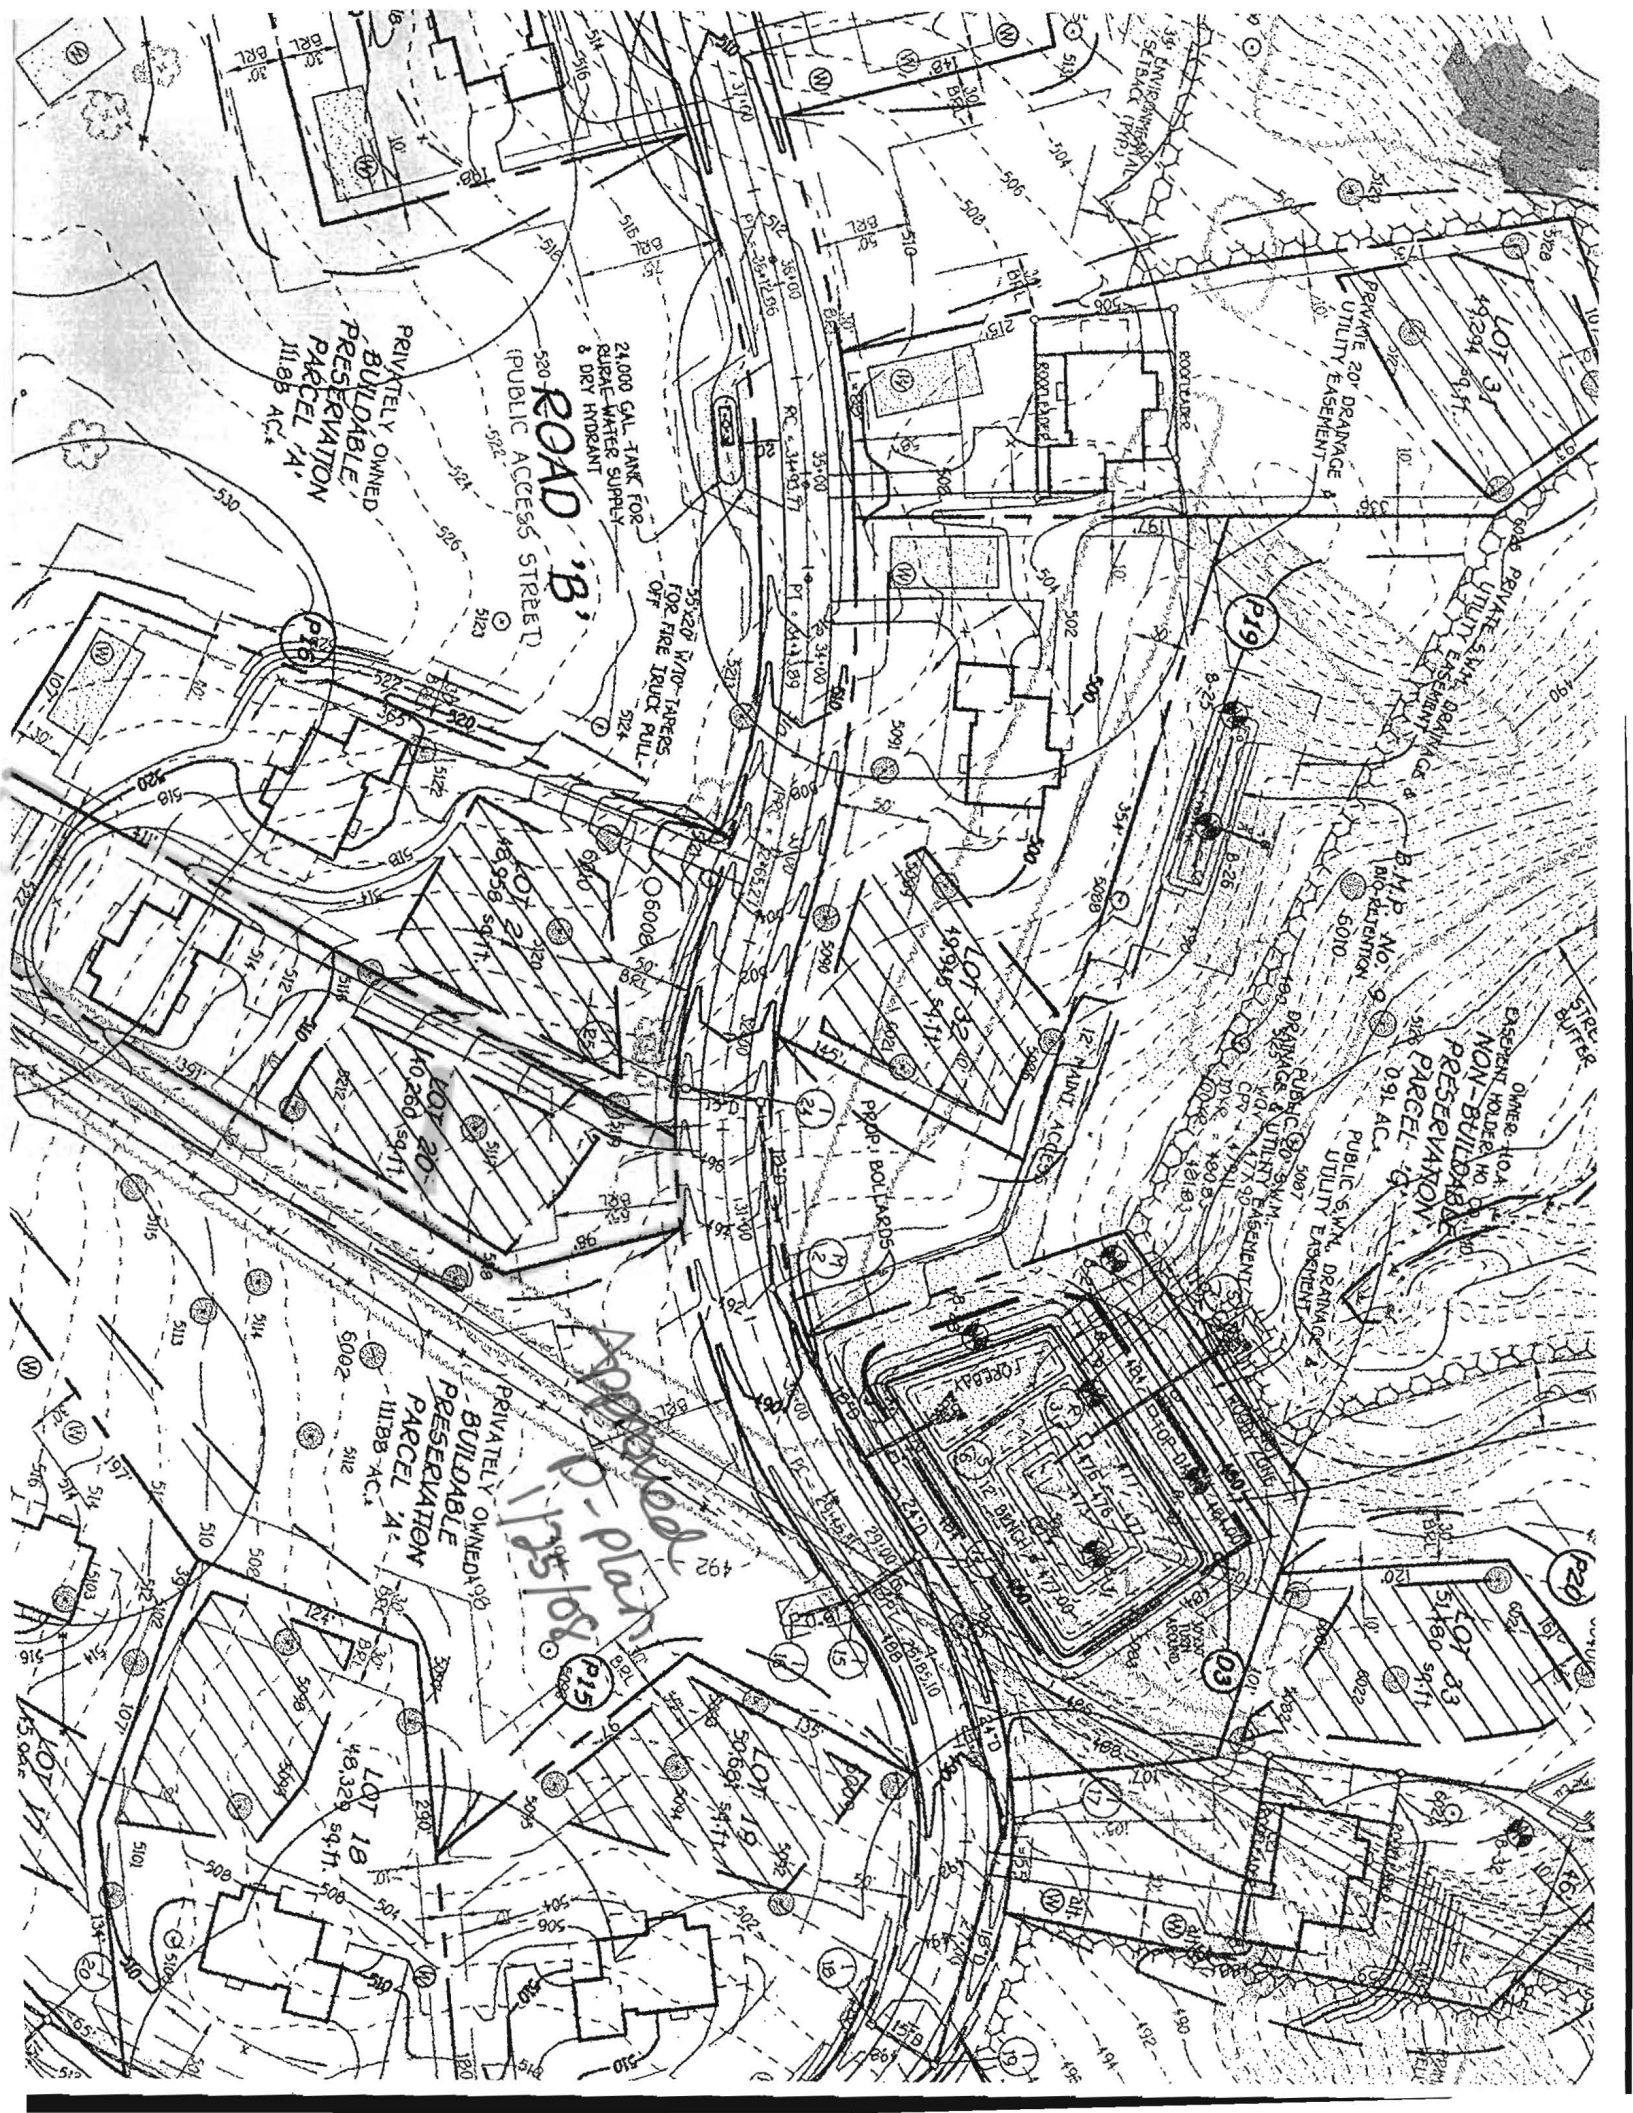

PRIVATELY OWNED  
BUILDABLE  
PRESERVATION  
PARCEL 4A  
11.88 AC.

24,000 GAL. TANK FOR  
RURAL WATER SUPPLY  
& DRY HYDRANT

ROAD 'B'  
(PUBLIC ACCESS STREET)

55x20' W/10' TANKS  
FOR FIRE TRUCK PULL  
OFF

PRIVATE 20' DRAINAGE &  
UTILITY EASEMENT

OWNER: HOA  
ESSENTIAL HOLDER NO. 1  
NON-BUILDABLE  
PRESERVATION  
PARCEL 4  
0.91 AC.

PRIVATELY OWNED  
BUILDABLE  
PRESERVATION  
PARCEL 4A  
11.88 AC.

Approp. park  
1/25/68

LOT 18  
46,329 sq. ft.

LOT 19  
50,681 sq. ft.

LOT 20  
48,956 sq. ft.

LOT 23  
51,480 sq. ft.

