


SITE INSPECTION SHEET

OWNER: Eugene & Diana Madlangbayan PHONE #: 202-361-5923
ADDRESS: 6701 Groveleigh Drive CONTRACTOR: _____
21046 WELL TAG #: no tag
SUBDIVISION: _____ LOT: _____ COUNTY #: _____
PROPOSAL: inspection for owner to retain well

LOCATION DIAGRAM

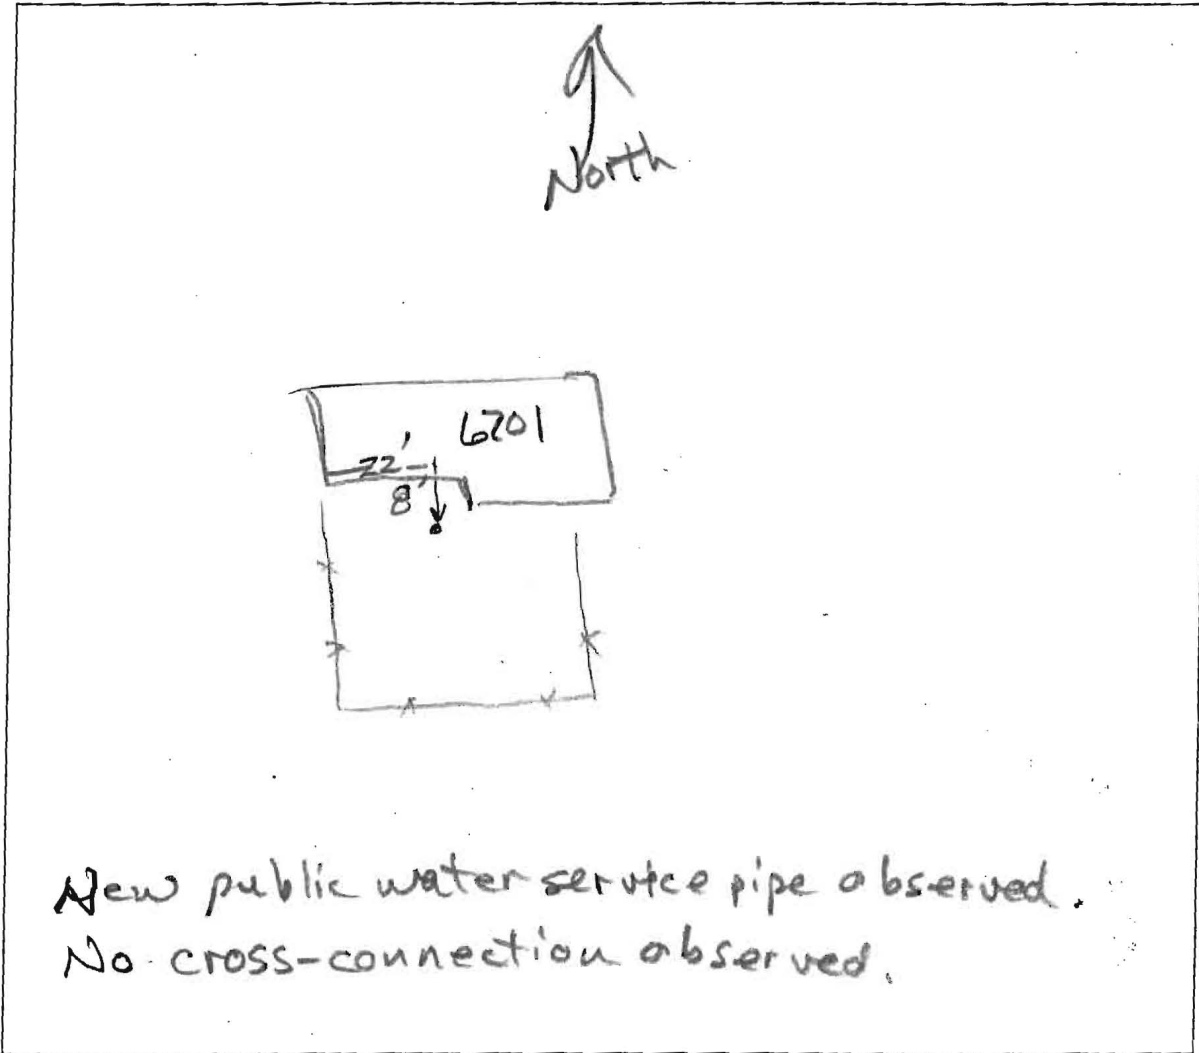

COMMENTS: Well^{case} painted black, 14-inches tall
relatively new 2-pc green metal cap
plastic conduit tight in cap part
well plumbed to pressure tank - to hose bib.
DATE: 12/17/2014 INSPECTOR: R. Buckley