



APPLICATION

FOR PERCOLATION TESTING AND SITE EVALUATION

TEST DATE(S) _____ TEST TIME _____

AP 536078

AGENCY REVIEW: _____

DATE 3-16-12

DO NOT WRITE ABOVE THIS LINE

I HEREBY APPLY FOR THE NECESSARY TESTING/EVALUATION PRIOR TO ISSUANCE OF SEWAGE DISPOSAL SYSTEM PERMIT(S) TO:

CHECK AS NEEDED:

- CONSTRUCT NEW SEPTIC SYSTEM(S)
- REPAIR/ADD TO AN EXISTING SEPTIC SYSTEM
- REPLACE AN EXISTING SEPTIC SYSTEM

CHECK AS NEEDED:

- NEW STRUCTURE(S)
- ADDITION TO AN EXISTING STRUCTURE
- REPLACE AN EXISTING STRUCTURE

CHECK ONE:

- CREATE NEW LOT(S)
- BUILD ON AN EXISTING LOT IN A SUBDIVISION
- BUILD ON AN EXISTING PARCEL OF RECORD

IS THE PROPERTY WITHIN 2500' OF ANY RESERVOIR?

- YES
- NO

THE TYPE OF STRUCTURE IS:

- RESIDENTIAL WITH 4 PROPOSED BEDROOMS IN THE COMPLETED STRUCTURE (NOTE **UNKNOWN** IF APPROPRIATE)
- COMMERCIAL (PROVIDE DETAIL OF NUMBERS AND TYPES OF EMPLOYEES/ CUSTOMERS ON ACCOMPANYING PLAN)
- INSTITUTIONAL/GOVERNMENT (PROVIDE DETAIL OF NUMBERS AND TYPES OF EMPLOYEES/USERS ON ACCOMPANYING PLAN)

PROPERTY OWNER(S) Tim Keane

DAYTIME PHONE 410-480-0022 CELL 443-324-9806 FAX 410-480-0015

MAILING ADDRESS 2675 Park Ave E.C. 21003
STREET CITY/TOWN STATE ZIP

APPLICANT Tim Keane

DAYTIME PHONE _____ CELL _____ FAX _____

MAILING ADDRESS _____
STREET CITY/TOWN STATE ZIP

APPLICANT'S ROLE: DEVELOPER BUILDER BUYER RELATIVE/FRIEND REALTOR CONSULTANT

PROPERTY LOCATION
SUBDIVISION/PROPERTY NAME CFOC LOT NO. 7

PROPERTY ADDRESS 1475 Rt 32 Sykesville MD 21784
STREET TOWN/POST OFFICE


TAX MAP PAGE(S) 9 GRID 17/18 PARCEL(S) 41 PROPOSED LOT SIZE 3 Acres

AS APPLICANT, I UNDERSTAND THE FOLLOWING: THE SYSTEM INSTALLED SUBSEQUENT TO THIS APPLICATION IS ACCEPTABLE ONLY UNTIL PUBLIC SEWERAGE IS AVAILABLE. THIS APPLICATION IS COMPLETE WHEN ALL APPLICABLE FEES AND A SUITABLE SITE PLAN HAVE BEEN RECEIVED. I ACCEPT THE RESPONSIBILITY FOR COMPLIANCE WITH ALL M.O.S.H.A. AND "MISS UTILITY" REQUIREMENTS. APPROVAL IS BASED UPON SATISFACTORY REVIEW OF A PERC CERTIFICATION PLAN.

TEST RESULTS WILL BE MAILED TO APPLICANT.

Tim Keane
SIGNATURE OF APPLICANT

HOWARD COUNTY HEALTH DEPARTMENT, BUREAU OF ENVIRONMENTAL HEALTH, WELL AND SEPTIC PROGRAM
7178 COLUMBIA GATEWAY DRIVE COLUMBIA, MARYLAND 21046 (410) 313-2640 FAX (410) 313-2648
TDD (410) 313-2323 TOLL FREE 1-877-4MD-DHMH

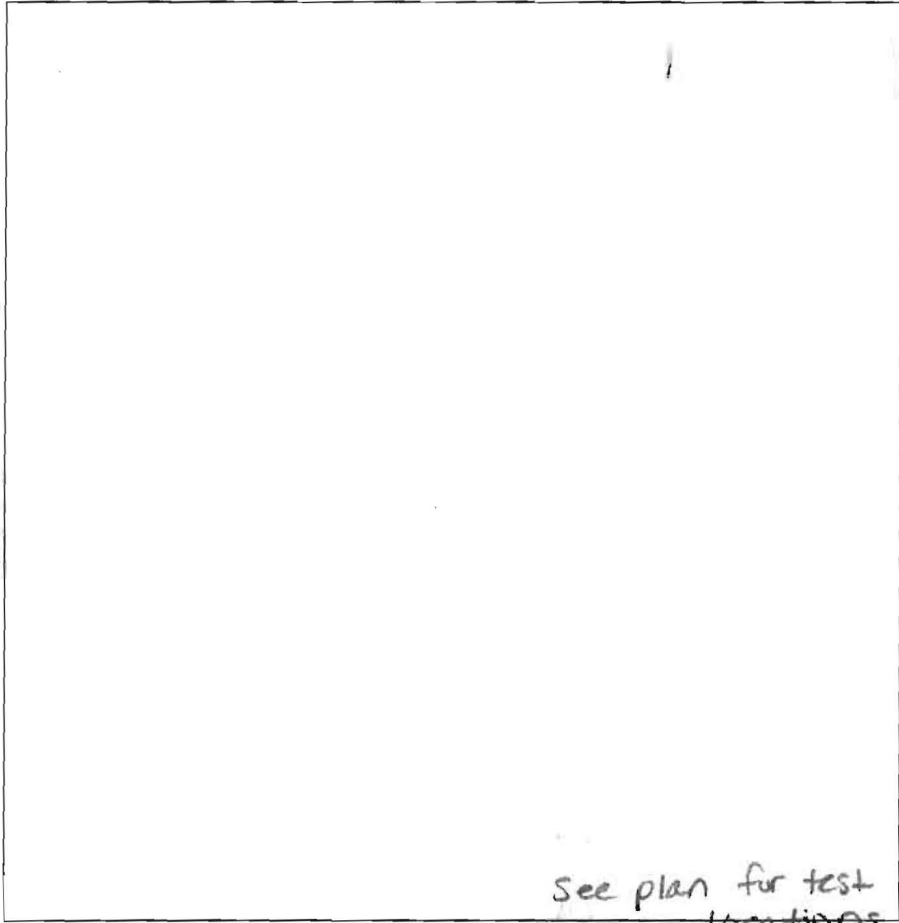

705
 1.5' roots brn
 few boulders
 neat lorg
 scl msbk
 3' red/yellow
 sl saprolite
 w/ Mn
 5' yellow
 fsl saprolite
 w/ Mn + Fe
 deposits 3pl
 8' quartz
 10' bottom
 12' bottom

700
 1' roots/brn
 red/org brn
 ch scl
 2c sbk
 4' yellow brn
 sl
 msbk
 9' yellow
 brn fsl
 Saprolite
 org brn
 ch sl w/ Mn
 12'

704
 1' brn l
 org brn
 l sbk
 3' brn
 sl 15% rx
 6' brn ch
 fsl
 10' brn
 vch w/ Mn
 sl
 11.2' bl sl

701
 brn l
 sbk
 org brn
 scl 2c sbk
 3.5' red yellow
 sl 15%
 quartz
 f sbk
 7' yellow
 brn ch sl
 ch brn
 fsl 12'

702
 org brn
 l sbk
 scl
 4' yellow
 brn Saprolite
 6' yellow
 brn fsl
 Saprolite
 w/ Mn 12'

See plan for test locations.

DATE	TEST #	DEPTH	START	BREAK 1" DROP	STOP 2" DROP	TIME OF 2ND INCH	P/F/H
3-21-12	705	5.5'	1:11	1:20	1:29	9	P
	706	5 1/2'	1:27	1:36	1:43	7	P
	704	11.5'	VISUAL				OK
	701	5 1/8"	2:05	2:10	2:17	7	P
	702	5.5' / 12'	2:18	2:21	2:25	4	P

REMARKS Lot 7 holes dug per plan
 SANITARIAN HR/HS BACKHOE Jace OTHERS Tim Keane
 TEST HOLES USED IN SDA 5 AVG. PERC TIME 6.75 SQ. FT/BR
 TRENCH WIDTH 2 INLET DEPTH 4 MAX. BOT DEPTH 8 EFFECTIVE SW 2'

181
NIES
IES
87
TIAL
O

Signed PC
7-16-12

TM. 0009 P. 0309
TIMOTHY & KARN MYRES
LOT 8E
L. 02390 F. 00649
USE: RESIDENTIAL
ZONE: RR-DEO

LOT 7
130,680.01 SF
3.00 AC

TM. 0009 P. 0309
CLAUDIA A. MENESES-GONZALEZ
MARCO GONZALEZ
LOT 8F
L. 10921 F. 00158
USE: RESIDENTIAL
ZONE: RR-DEO

TM. 0009 P. 0309
HANNA, CYNTHIA JEANNE
LOT 8G
L. 12096 F. 00221
USE: RESIDENTIAL
ZONE: RR-DEO

SF

