


Approved Septic System Plan
Howard County Health Department

B1400 2038 REVISIONS
4 approved to original permit
3/9/2015
See Circled Items

Owner: Barbara A. Liston
Builder: Barbara A. Liston
Address: 342 Watersville Road, Mount Airy, MD 21771
Date: Feb. 19, 2015
House Type: Single Family Rancher
Location: Single Story & Basement, Tax Map 2, Block 15, Parcel 17

Topography is from Howard County Aerial Photogrametry. Contour Interval is 5 ft.

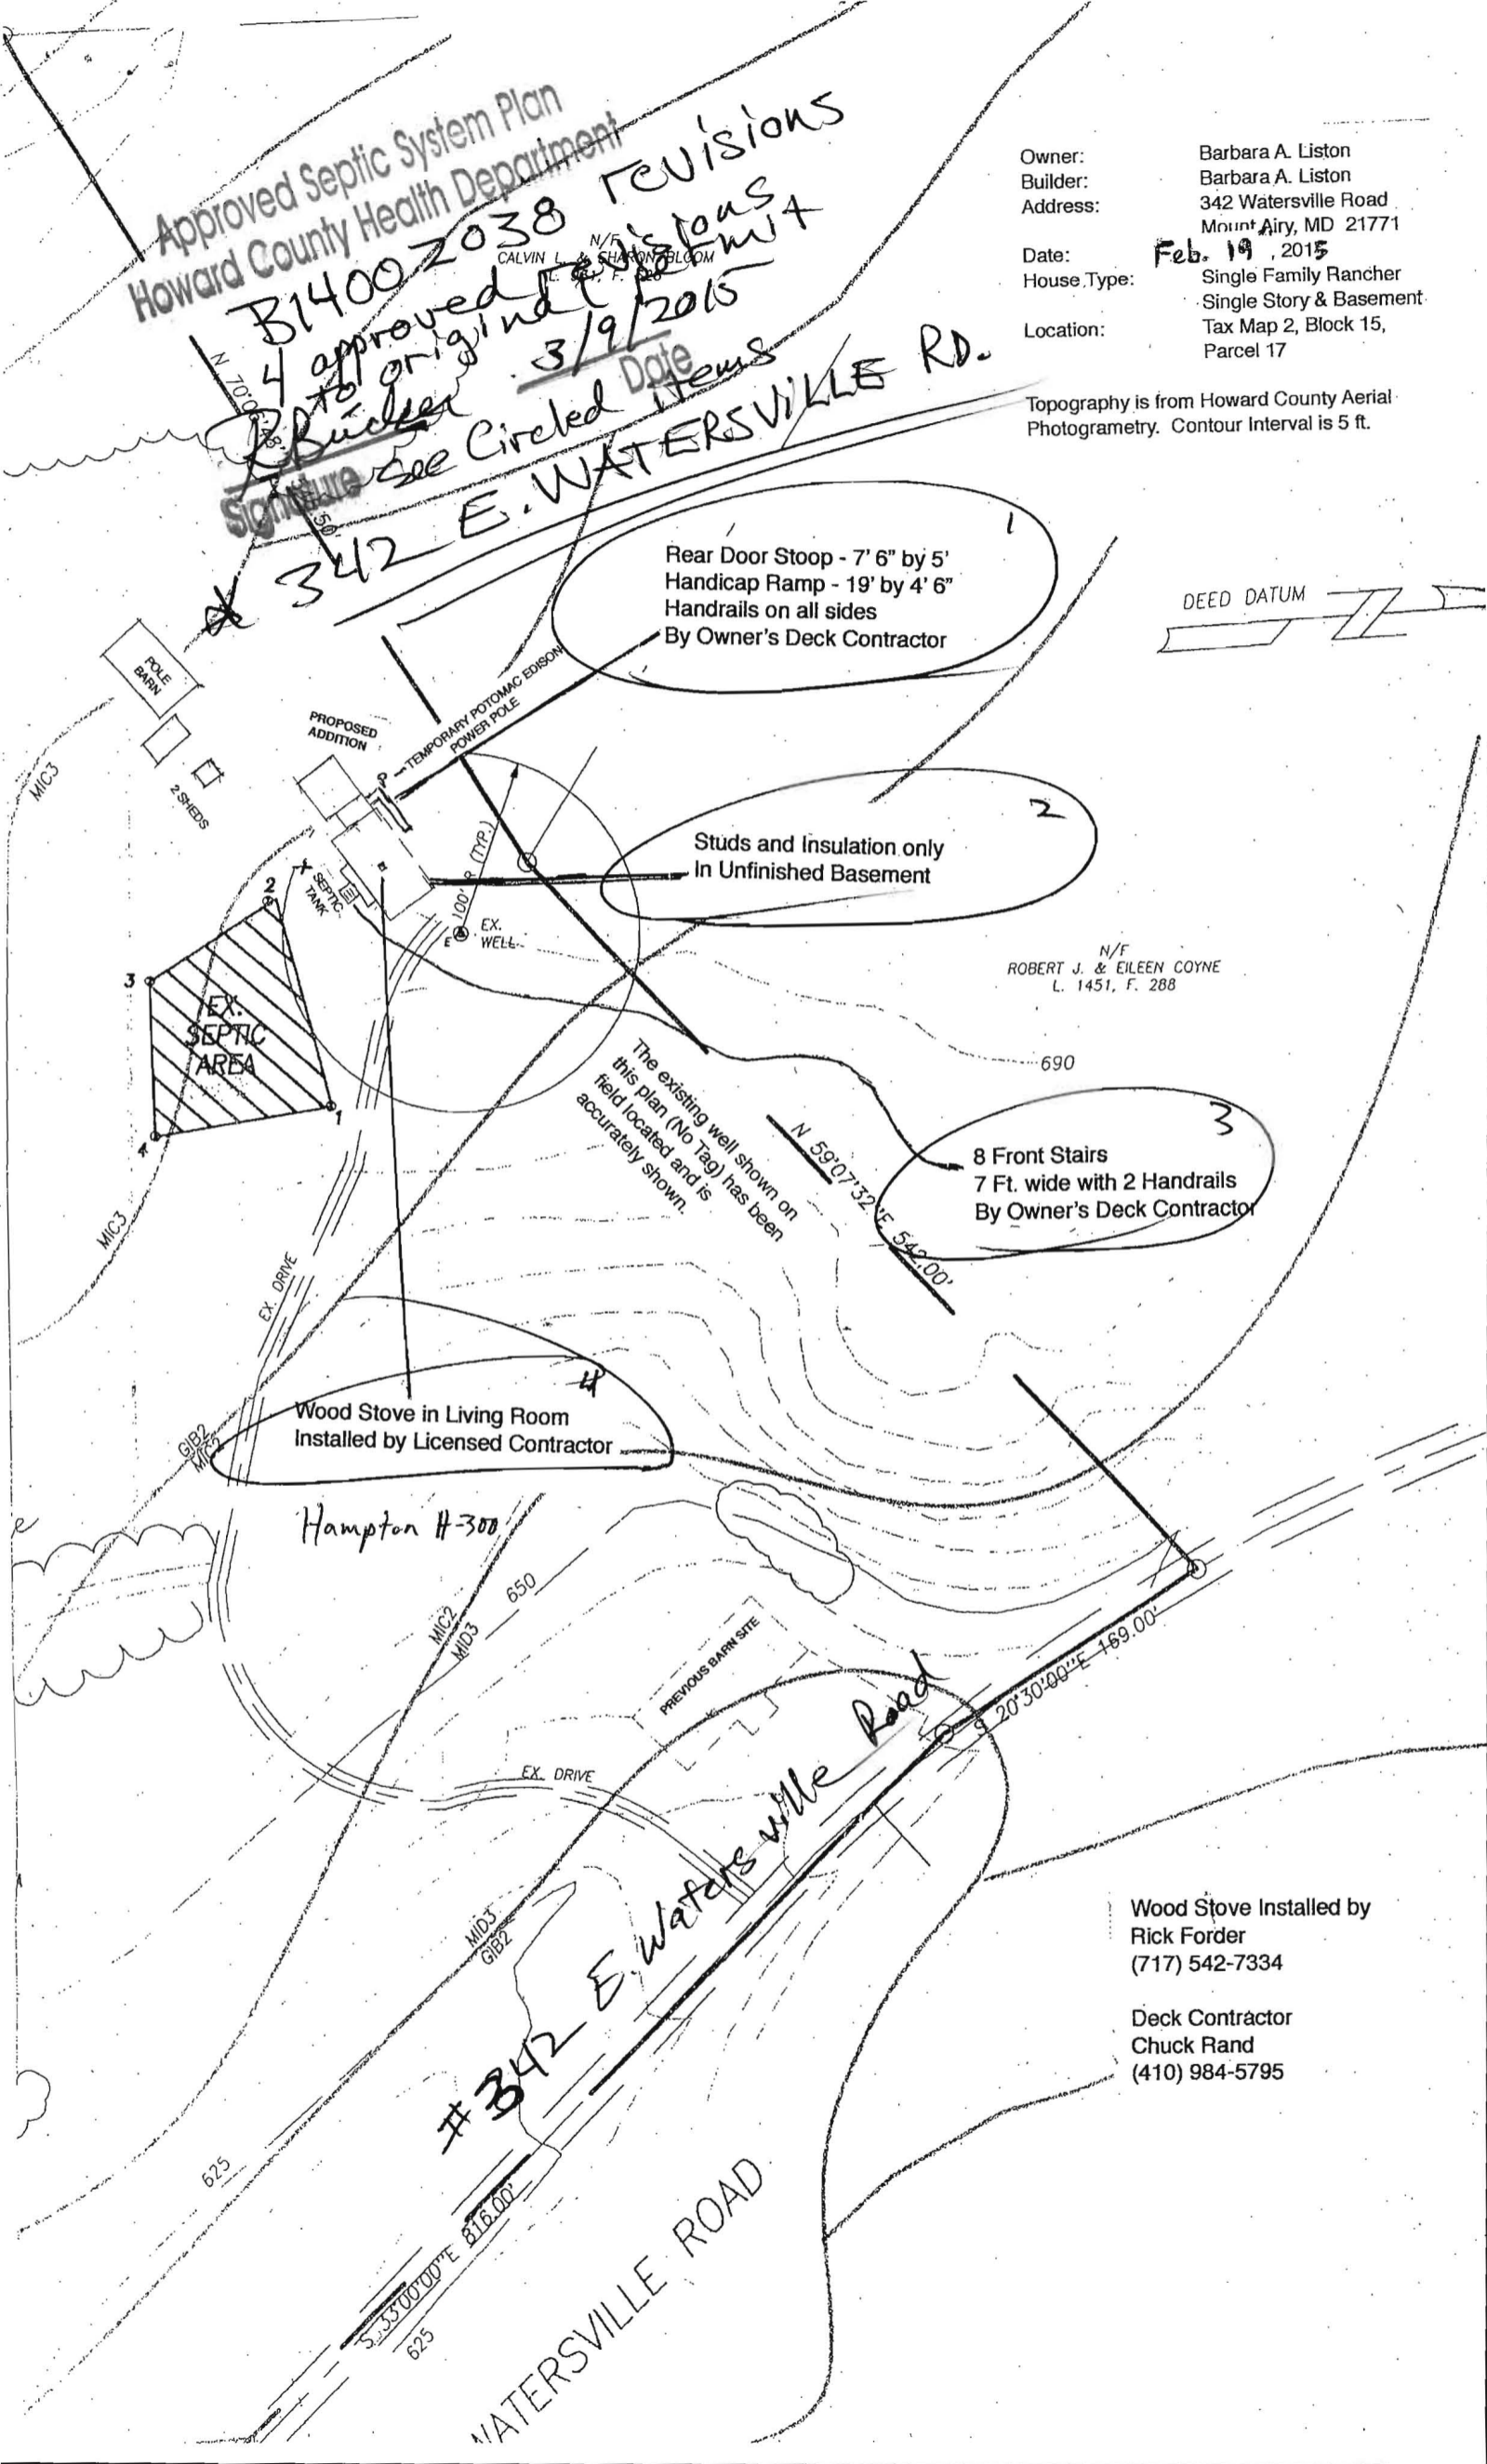

DEED DATUM

N/F
ROBERT J. & EILEEN COYNE
L. 1451, F. 288

Wood Stove Installed by
Rick Forder
(717) 542-7334

Deck Contractor
Chuck Rand
(410) 984-5795

Hampton #300

#342 E. Watersville Road

WATERSVILLE ROAD

Name: Barbara Liston
Street Address: 342 Watersville Rd
City, State, Zip: Mount Airy MD 21771
Date: 2/19/15

Amendment, Permit # B14002038⁽³⁾

Ms. Debbie Whalen
Division of Plan Review
Department of Inspections, Licenses and Permits
Howard County Government
3430 Court House Dr
Ellicott City, MD 21043

RECEIVED
FEB 26 2015
LICENSES & PERMITS
DIVISION

Dear Ms. Whalen:

I am requesting to amend Permit # B14002038 at
342 E. Watersville Rd. Mount Airy to
Add steep and handicap ramp at rear door
Add steps to front porch
Add studs and insulation only to basement
Add wood stove with stainless steel stove pipe in Living Room

Enclosed:

1 Fee: \$25⁰⁰ check # 1236
4 Plot Plans invoice # 392203
Sets of Construction Drawings
Other:

If there is anything we can do to assist you, please let me know.

Sincerely,

Barbara Jane Kurtz POA

Name: Barbara Jane Kurtz (daughter)
Title: Power of Attorney for Barbara Liston (Mother)
Phone: (540) 333-1996
Email: donovankepa@gmail.com

CC: DPZ
HEALTH ✓