

Retest

# APPLICATION

SEWAGE DISPOSAL TESTING

A 30377

STATE OF MARYLAND - DEPARTMENT OF HEALTH AND MENTAL HYGIENE

P \_\_\_\_\_

HOWARD COUNTY HEALTH DEPARTMENT  
ENVIRONMENTAL HEALTH SERVICES  
P.O. BOX 476 ELLICOTT, MARYLAND 21043  
TELEPHONE: 992-2330

DISTRICT 6th

DATE 11/20/79

TO: THE COUNTY HEALTH OFFICER,  
ELLICOTT CITY, MARYLAND

I, HEREBY, APPLY FOR THE NECESSARY TEST IN ORDER TO CONSTRUCT (OR RECONSTRUCT) A SEWAGE DISPOSAL SYSTEM.

PROPERTY OWNER Bruno and Sonya ~~XXXXXXXXXX~~ Tarabocchia

ADDRESS 7888 Hammond Parkway, Laurel, Md. 20810 PHONE 776-7579

PROPERTY LOCATION:

SUBDIVISION \_\_\_\_\_ LOT NO. \_\_\_\_\_

ROAD AND DESCRIPTION 11200 Harding Road

SIZE OF LOT 1 acre m/l TYPE BLDG. 5 bedrooms

THE SYSTEM INSTALLED UNDER THIS APPLICATION IS ACCEPTABLE ONLY UNTIL PUBLIC FACILITIES BECOME AVAILABLE.

I FULLY UNDERSTAND THE FEE CONNECTED WITH THE FILING OF THIS PERC TEST APPLICATION IS NON-REFUNDABLE UNDER

ANY CIRCUMSTANCES.

SIGNATURE OF APPLICANT /s/ Bruno Tarabocchia

APPROVED BY \_\_\_\_\_ FOR \_\_\_\_\_ DATE \_\_\_\_\_

REJECTED BY \_\_\_\_\_ FOR \_\_\_\_\_ DATE \_\_\_\_\_

HOLD PENDING FURTHER TESTS \_\_\_\_\_ DATE \_\_\_\_\_


REASONS FOR REJECTION OR HOLDING 2/15/80 UNSATISFACTORY WATER BUT HOLD FOR

REVIEW

# THIS IS NOT A PERMIT



SOIL PROFILE

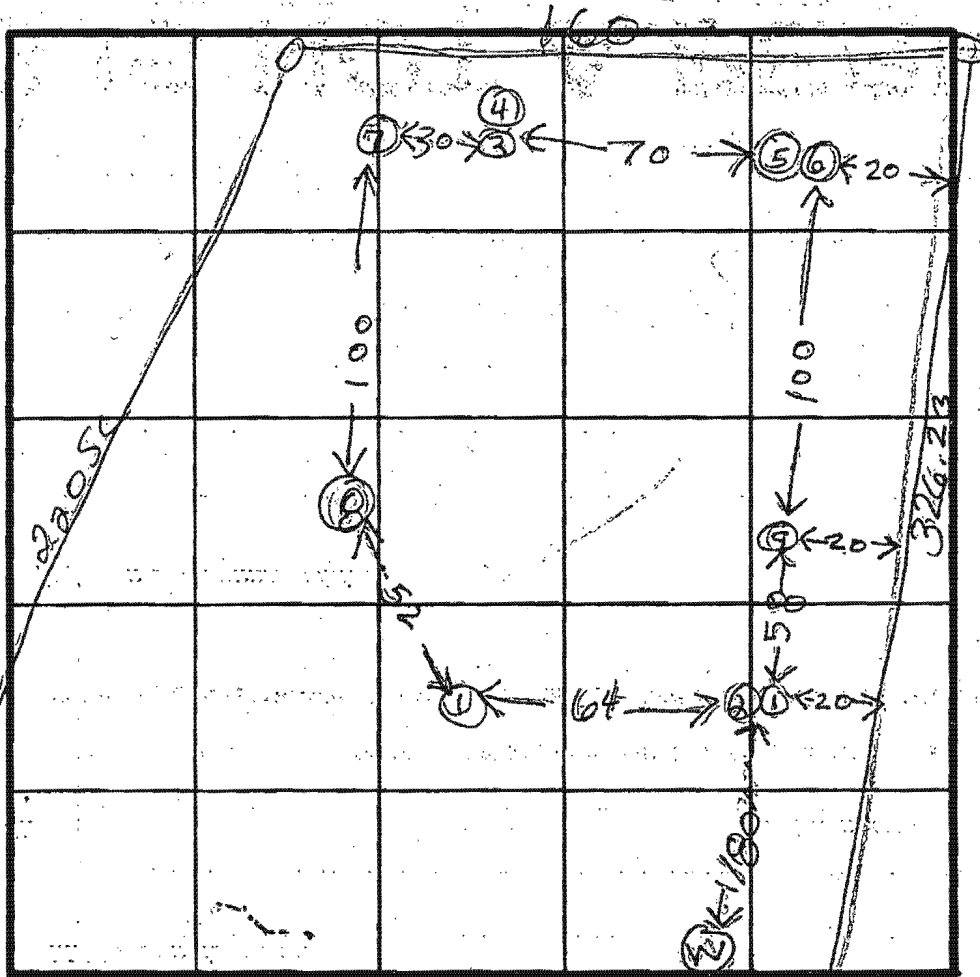

INDICATE NORTH - NAME ADJOINING ROADWAY AS BASE LINE

ESTIMATED  
HOLE  
ELEVATIONS

8 = 0

7 = 1

3 = +5

1 = +5

12 = +10

9 = +10

6 = +10

DATE	TEST NO.	DEPTH	PRE-WET		TEST - 1" DROP		TIME
			START	STOP	START	STOP	
11/1/80	7 V	11	TOP 5 FT	CLAY	8	BUT 6 SANDY	
	8 W	9	TOP 5 FT	CLAY	7 1/2	BT	
	9 V	12	TOP 5 FT	CLAY	13H	BT	

REMARKS

TYPE OF SOIL

TESTED BY

R. HODGES

ALSO PRESENT

BRUNO

