

PRELIMINARY

APPLICATION

A 17788

SEWAGE DISPOSAL TESTING

STATE OF MARYLAND - DEPARTMENT OF HEALTH AND MENTAL HYGIENE

P _____

4th

HOWARD COUNTY HEALTH DEPARTMENT
ENVIRONMENTAL HEALTH SERVICES
P. O. BOX 476, ELLICOTT CITY, MARYLAND 21043
TELEPHONE: 465-5000, EXT. 356

DISTRICT

DATE 12/13/72

*B.P. issued 7/17
32600*

TO: THE COUNTY HEALTH OFFICER
ELLICOTT CITY, MARYLAND

I, HEREBY, APPLY FOR THE NECESSARY TEST IN ORDER TO CONSTRUCT (OR RECONSTRUCT) A SEWAGE DISPOSAL SYSTEM.

PROPERTY OWNER Brantly Baptist Church

Any questions call Purdum & Jeschke

ADDRESS 5007 Baltimore National Pike, Balto., Md.

PHONE 465-1635

PROPERTY LOCATION:

SUBDIVISION Branterwoods LOT NO. 4, Blk. A

ROAD AND DESCRIPTION Burntwoods Road

SIZE OF LOT 155' x 260' x 155' x 260'

TYPE BLDG. 3 or 4 bedrooms

NUMBER OF BEDROOMS

IF NOT SINGLE RESIDENCE DESCRIBE _____

THE SYSTEM INSTALLED UNDER THIS APPLICATION IS ACCEPTABLE ONLY UNTIL PUBLIC FACILITIES BECOME AVAILABLE.

SIGNATURE OF APPLICANT /s/ Purdum and Jeschke

APPROVED BY _____ FOR _____ DATE _____
(KIND OF SYSTEM)

REJECTED BY _____ FOR _____ DATE _____
(KIND OF SYSTEM)

HOLD PENDING FURTHER TESTS _____ DATE _____


REASONS FOR REJECTION OR HOLDING _____

THIS IS NOT A PERMIT

08771 A

APPLICATION

STATE OF TEXAS
DEPARTMENT OF HEALTH

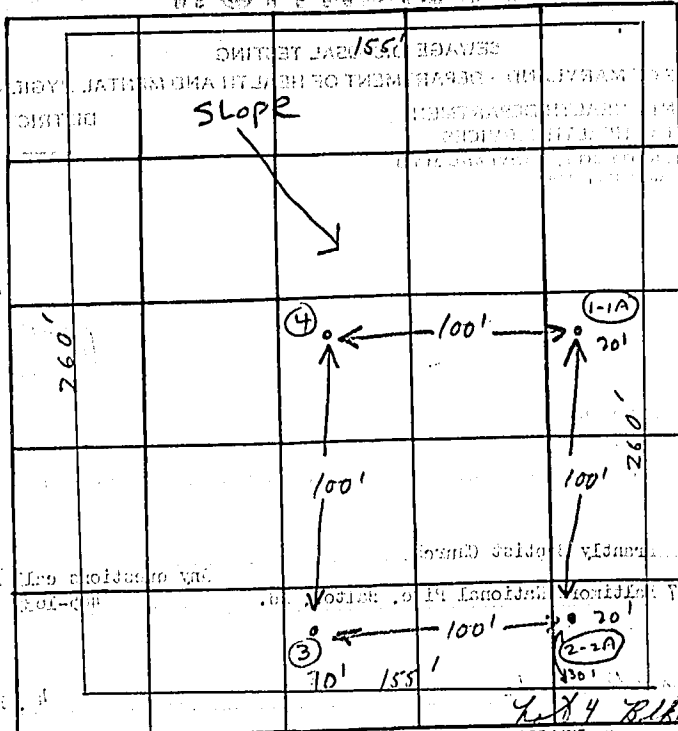

INDICATE NORTH - NAME ADJOINING ROADWAY AS BASE LINE

Unnamed Road

26
23
411

DATE	TEST NO.	DEPTH	PRE-WET		TEST - 1" DROP		TIME
			START	STOP	START	STOP	
11/21/72	1	3'	11:02	11:05	11:05	11:08	3
	1A	13'	11:02	11:18	11:18	11:32	15
	2	3'	10:43	10:46	10:46	10:54	8
	2A	13'	10:48	10:56	10:56	11:19	23
TORRE	3						
	4						

avg time
12
MIN

REMARKS Dry Well (1-1A)

TYPE OF SOIL Silt

TESTED BY Max Depth 13'