

COUNTY #

SOIL PROFILE

(512)

Red Br Heavy Loam 3'  
 Or Br Si Cl Loam Very Little Rock 5.5-6'  
 Beige Sa Loam ~15% Saprolite 8'  
 Caving Wet Water 9'  
 10'

(523)

Red Br Heavy Loam ~10% Rock 4.5-5'  
 Beige Si Loam Very Little Rock Caving To Surface Water 6'

(524)

Red Br Heavy Loam 4.5-5'  
 Red Br Si Loam Trace Rock 5.5-6'  
 Med Br Sa Loam ~26% Saprolite 7'  
 Caving Wet Water 8.5'  
 9.5'


SOIL PROFILE

(525)

Red Br Heavy Loam 3.5-5'  
 Tan Sa Loam 15-20% Saprolite 10.5'  
 Caving Water 12'

(526)

Red Br Heavy Loam and Si Cl Loam ~10% Rock 4.5-5.5'  
 Beige Sa Loam ~20% Saprolite 11.5'  
 Caving Water 12'

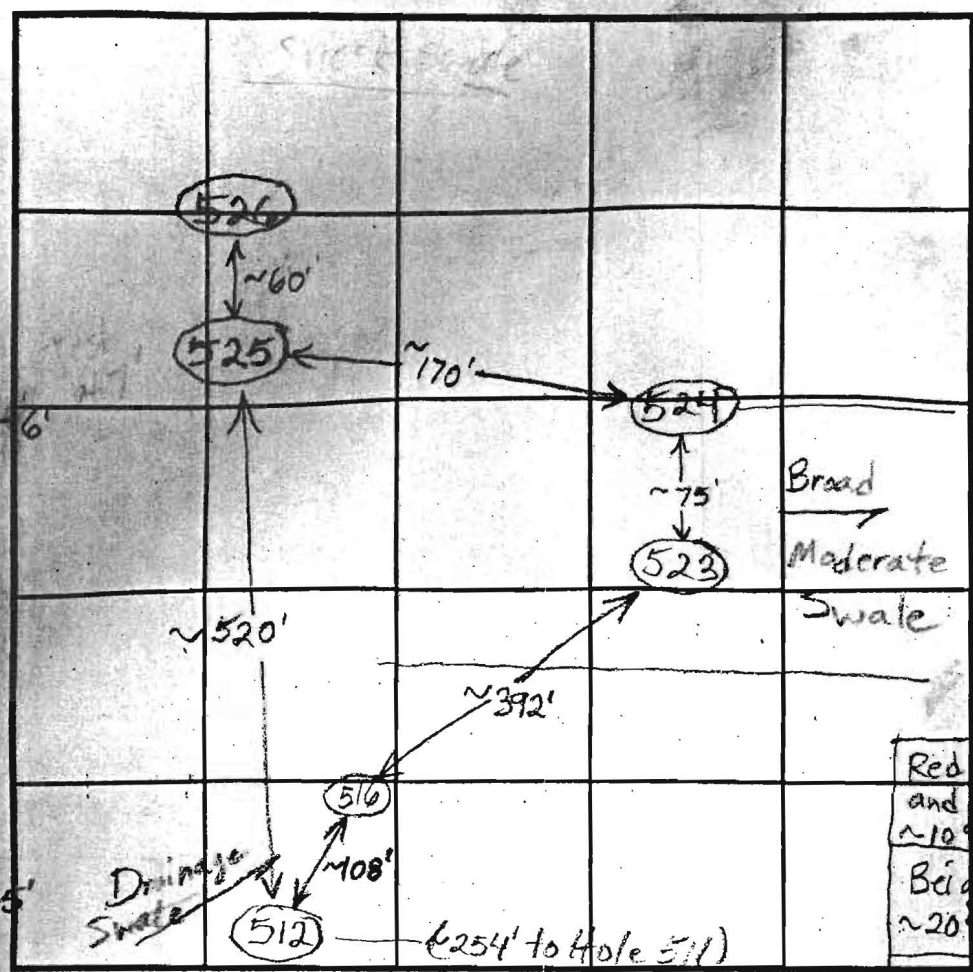

INDICATE NORTH - NAME ADJOINING ROADWAY AS BASE LINE.

Ten Oaks Road

DATE	TEST NO.	DEPTH	PRE-WET		TEST - 1" DROP		TIME	
			START	STOP	START	STOP		
1/9/04	512	5.5'/10'V	9:32:30	9:53	9:53	~7/8" in 36 minutes	Slow	(F)
		7'	9:32:30	9:37:45	9:37:45	9:47	9	
	523	6'V						(F)
	524	6'/9.5'V	10:19	10:23:15	10:23:15	10:30:45	7	(F)
		7'	10:19:30	10:22:15	10:22:15	10:27:45	4 1/2	
		5'	10:33	10:45	10:45	11:09	24	
	525	5'3"/12'V	10:52	10:58:45	10:58:45	11:14:15	15 1/2	O.K.
		7'	10:52	11:06	11:00	11:09:30	9 1/2	
	526	5.5'/12'V	11:18	11:22:15	11:22:15	11:29:45	7 1/2	O.K.
		7.5'	11:18:30	11:25:30	11:25:30	11:37	11 1/2	

REMARKS Don't Move Any Closer to Drainage Swale at 512

TYPE OF SOIL \_\_\_\_\_  
 TESTED BY B. Baker ALSO PRESENT \_\_\_\_\_  
 TRENCH DESIGN DATA: AVERAGE PERCOLATION TIME \_\_\_\_\_ TRENCH WIDTH \_\_\_\_\_  
 INLET DEPTH \_\_\_\_\_ MAXIMUM BOTTOM DEPTH \_\_\_\_\_ SQ. FT/BEDROOM \_\_\_\_\_

COUNTY #

SOIL PROFILE


0' (197)  
 Red Br  
 Cl Loam  
 1.5' Or Br  
 Si Cl Loam  
 2.5'  
 15' Tan and  
 Red Si Loam  
 ~10%  
 Rock

(199)

3' Red Br Cl  
 Loam  
 1.5' Red Br Si  
 Cl Loam  
 15.5' Brown and  
 Reddish  
 Brown  
 Si Loam  
 10-15%  
 Rock

(198)

3.5'-4' Red Br  
 Clay Loam  
 1.5' Red Or Br  
 Si Cl Loam  
 Light Br  
 Sa Loam  
 ~10%  
 Rock

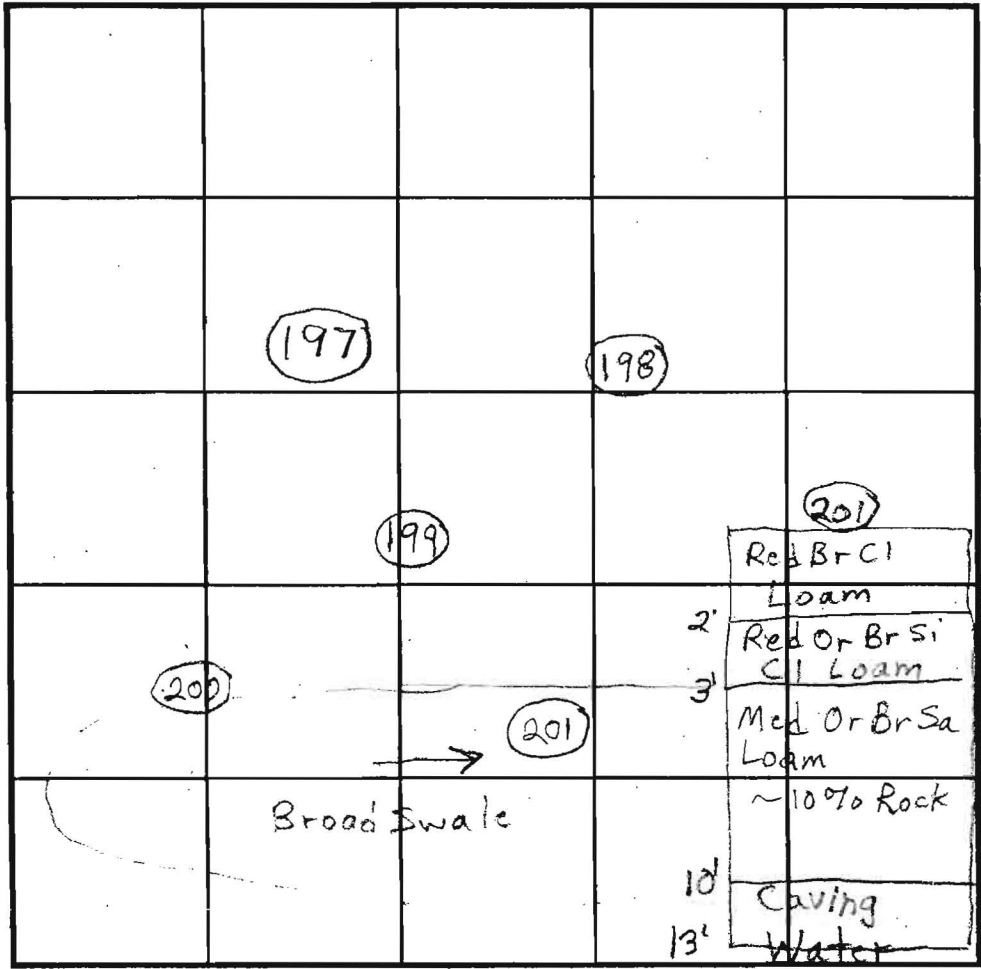

SOIL PROFILE

0' (200)  
 Red Br  
 Cl Loam  
 2.5' Or Br Si  
 Cl Loam  
 3.5' Light Br  
 Si Loam  
 and Or  
 Br Sa  
 Loams  
 ~10%  
 Rock

INDICATE NORTH - NAME ADJOINING ROADWAY AS BASE LINE.

Ten Oaks Road

DATE	TEST NO.	DEPTH	PRE-WET		TEST - 1" DROP		TIME	
			START	STOP	START	STOP		
11/29/01	*197	4.5'/15'V	2:02	- Pulled, Slow →			Slow	
	199	5.5'-6'/15.5'V	2:15	2:17	2:17	2:19:30	2 1/2	OK
	198	5.5'/15.5'V	2:32	2:35	2:35	2:42	7	OK
	197	5.5'	2:37	2:45	2:45	3:07	22	OK
	200	4.5'-5'/15'V	2:50	2:51	2:51	2:54	3	OK
	201	4'-4.5'/13'V	3:09			3:10:30	1 1/2 Total	(F)
		Repour	3:11	3:11:40	3:11:40	3:12:45	1 min 5 sec	
		Repour	3:13:20	3:14:15	3:14:15	3:15:35	1 min 20 sec	
		Repour	3:16:30	3:17:40	3:17:40	3:19:10	1 1/2	
		Fail due to	Fast rate. Also, needs WS test					

REMARKS \*197-dig deeper shelf for further review

TYPE OF SOIL

TESTED BY Brian Baker

ALSO PRESENT HATFIELDS - Donny

TRENCH DESIGN DATA: AVERAGE PERCOLATION TIME

TRENCH WIDTH

15.5'

THE SYSTEM INSTALLED UNDER THIS APPLICATION IS

FEE CONNECTED WITH THE FILING OF THIS PERC


COMPLY WITH ALL M.O.S.H.A. REQUIREMENTS IN TEST

APPROVED BY \_\_\_\_\_

DISAPPROVED BY \_\_\_\_\_

HOLD PENDING FURT

REASONS FOR \_\_\_\_\_

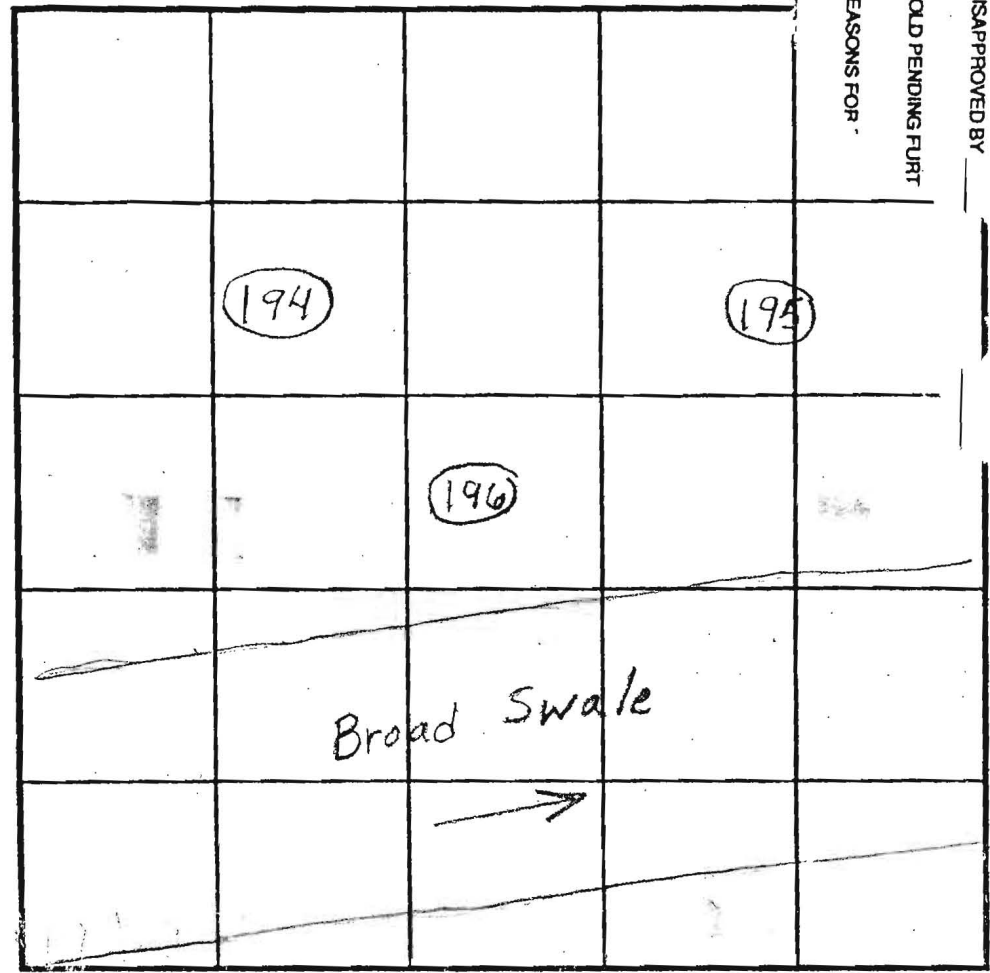

INDICATE NORTH - NAME ADJOINING ROADWAY AS BASE LINE.

Ten Oaks Road

DATE	TEST NO.	DEPTH	PRE-WET		TEST - 1" DROP		TIME
			START	STOP	START	STOP	
11/29/01	195	5'-5.5'/12.5'	3:30	3:36	3:36	4:01	25
12/11/01	194	7' / 13'8"	10:22	10:25	10:25	10:29	4
	196	7' / 15'	10:33	10:34	10:34	10:36	2

REMARKS: Holes dug per plan. Need at least one more hole 75' from the other holes per SDA.

TYPE OF SOIL: \_\_\_\_\_

TESTED BY: Brian Baker. ALSO PRESENT: HATFIELD'S - Danny

TRENCH DESIGN DATA: AVERAGE PERCOLATION TIME \_\_\_\_\_ TRENCH WIDTH \_\_\_\_\_

COUNTY # \_\_\_\_\_

SOIL PROFILE

0' (195)  
Red Br Cl Loam

3.5'  
Red Or Br Si Cl Loam

5'  
Br si Loam

7'  
Light Br Sa Loam to Bottom ~10% Rock

9'  
Pocket of >50% Rock

10.5'  
No Caving Water

12.5' (194)  
Red Br Cl Loam

3'  
Or Br Cl Loam

4'  
Or Br Si Cl Loam

6'  
Light Br Sa Loam 5-10% Rock


13'8" (196)  
Red Br Rocky Cl Loam

2.5-3'  
Or Br and Red Br si Cl Loam

5.5-6'  
Or Br and Red Br Sa Loam 5-10% Rock

12'



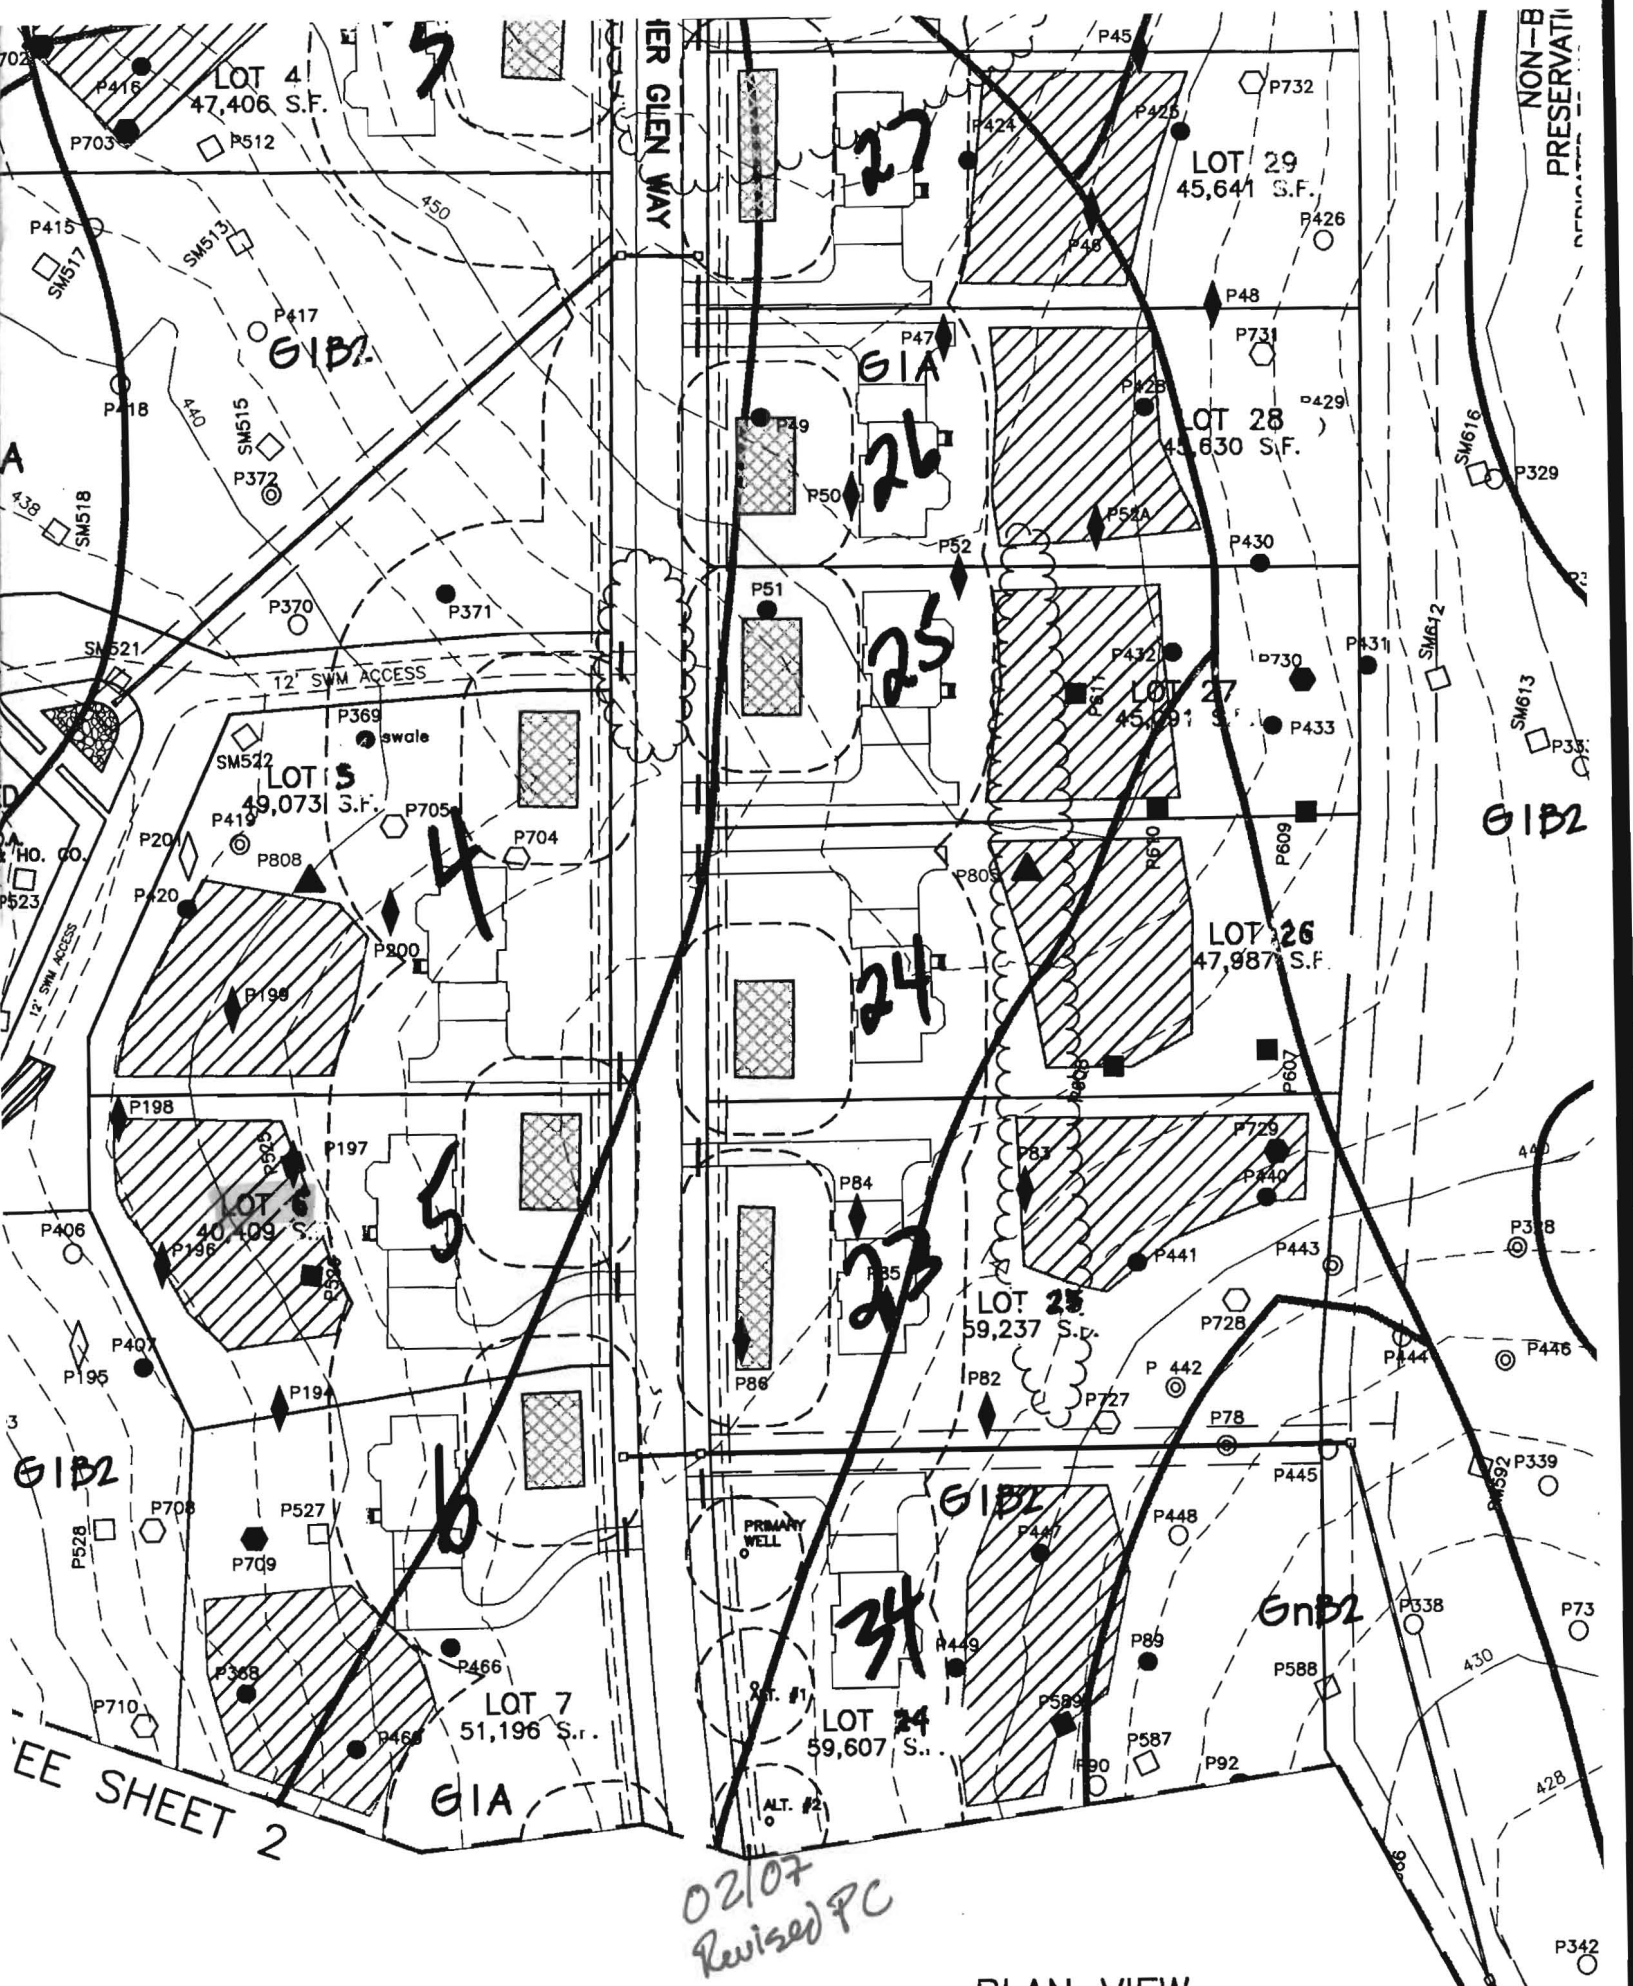

02/07  
Revised PC

PLAN VIEW  
SCALE: 1" = 100'




Signed P-Plan


PLAN VIEW  
SCALE: 1" = 100'





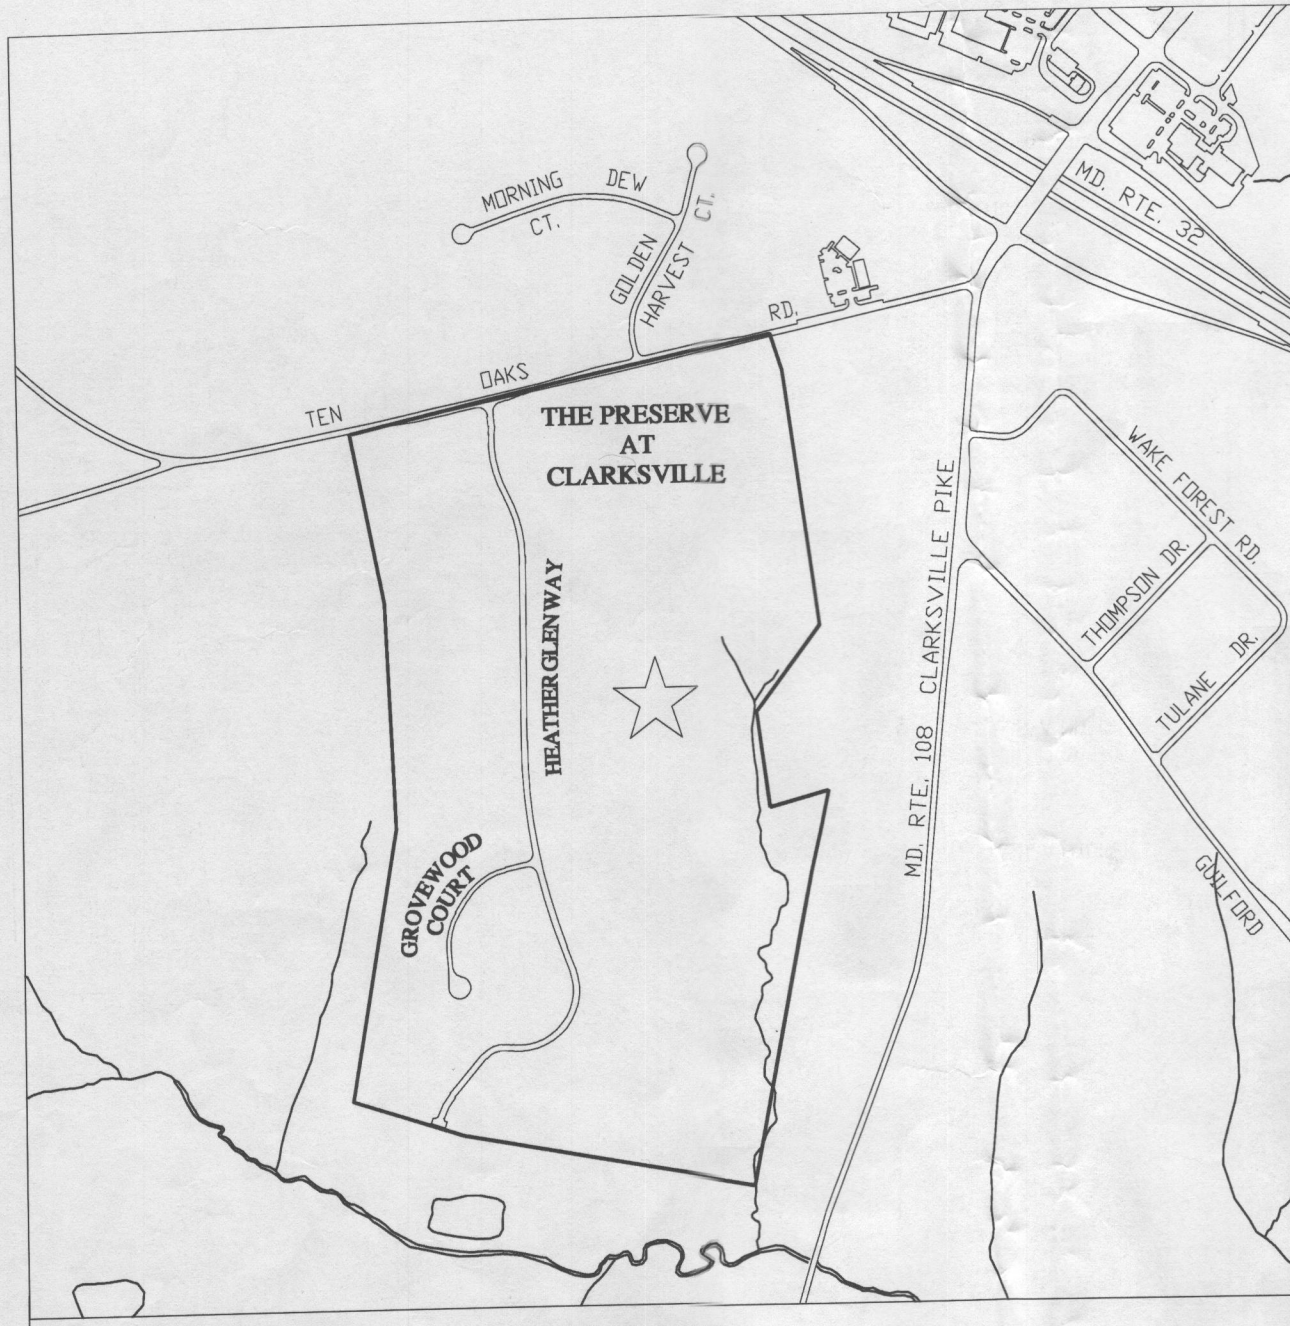


VICINITY MAP N.T.S.

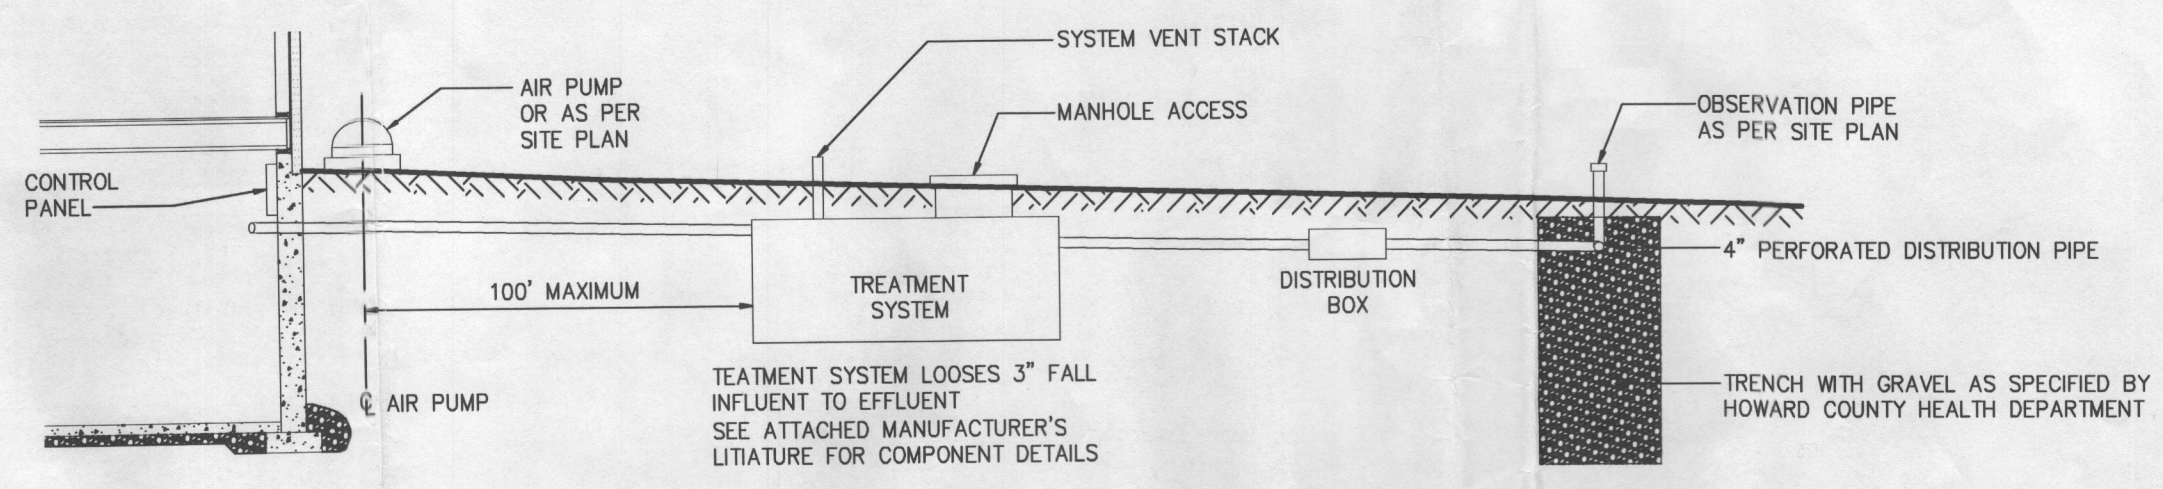

2 BAT COMPONENT CROSS SECTION  
SCALE: N.T.S.

**LEGEND**

	LIMIT OF DISTURBANCE		LIMIT OF 100YR FLOODPLAIN
	SILTY FENCE		FOREST CONSERVATION EASEMENT
	EXISTING CONTOURS (2' INTERVALS)		FOREST CONSERVATION EASEMENT RETENTION AREA
	EXISTING TREELINE		PRIVATE SEWAGE
	PROPOSED TREELINE		ABANDONED WELLBOX
	CL. STREAM		WELL REPLACEMENT AREA
	LIMIT OF WETLANDS		CONSTRUCTION DRIVE
	FOREST CONSERVATION SIGNAGE		
	SPECIMEN TREE		

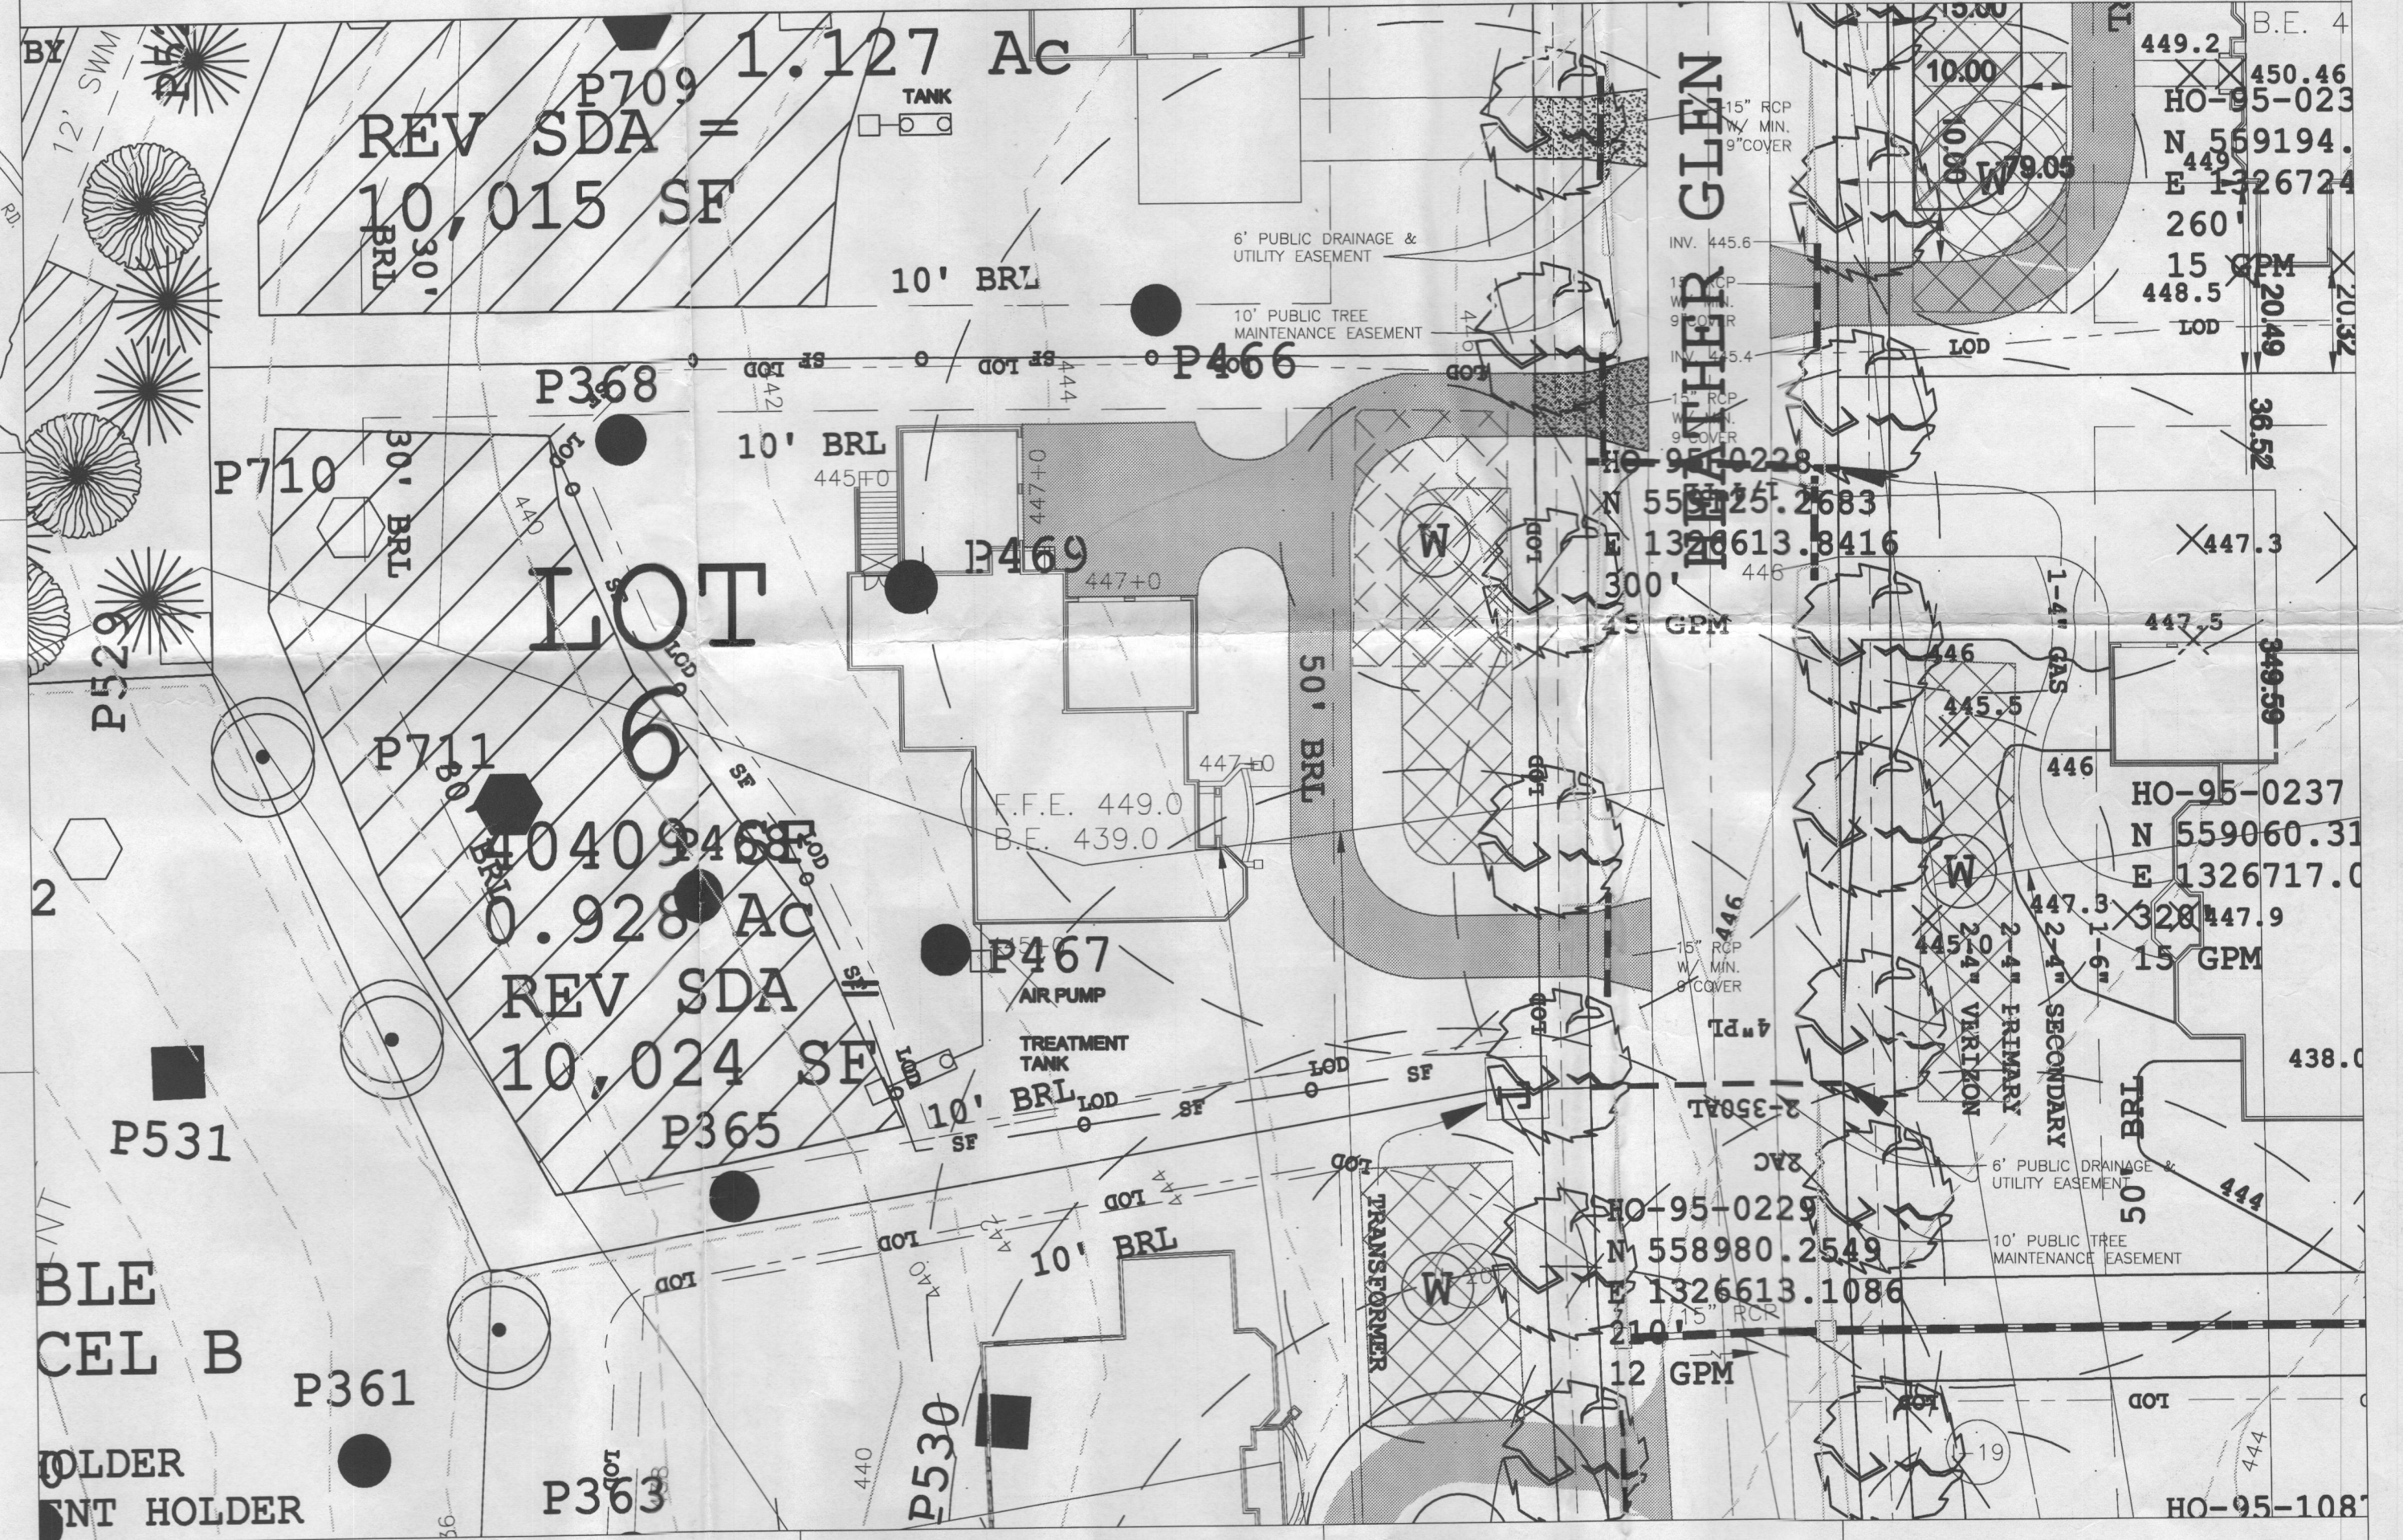

- BAT SITE PLAN NOTES:**
1. ANY CHANGE TO THE LOCATIONS OR DEPTHS TO ANY COMPONENTS MUST BE APPROVED BY THE ENGINEER AND THE HOWARD COUNTY HEALTH DEPARTMENT PRIOR TO INSTALLATION. A REVISED SITE PLAN MAY BE REQUIRED.
  2. THE MAXIMUM DEPTH OF THE BAT PER THE MANUFACTURER'S SPECIFICATION IS 4 FEET.
  3. THE BLOWER MAY NOT BE LOCATED MORE THAN 100 FEET FROM THE TANK BASED ON MANUFACTURER'S SPECIFICATIONS.
  4. THE BAT SYSTEM SHALL BE MAINTAINED AND OPERATED FOR THE LIFE OF THE SYSTEM.
  5. THE BAT SHALL BE OPERATED BY AND MAINTAINED BY A CERTIFIED SERVICE PROVIDER.
  6. WITHIN ONE MONTH OF INSTALLATION, A PERSON INSTALLING THE BAT SYSTEM SHALL REPORT TO THE MARYLAND DEPARTMENT OF THE ENVIRONMENT (MDE) IN A MANNER ACCEPTABLE TO MDE, THE ADDRESS AND DATE OF COMPLETION OF THE BAT INSTALLATION AND THE TYPE OF BAT INSTALLED.
  7. ELECTRICAL WORK FOR THE BAT INSTALLATION MUST BE PERFORMED BY A LICENSED ELECTRICIAN.
  8. AN AGREEMENT AND EASEMENT MUST BE COMPLETED AND SIGNED BY ALL APPLICABLE PARTIES, AND RECORDED IN LAND RECORDS OF HOWARD COUNTY.
  9. THE HEALTH DEPARTMENT REQUIRES DOCUMENTATION FOR THE START-UP CERTIFICATION FROM THE MANUFACTURER PRIOR TO FINAL APPROVAL OF THE INSTALLATION.
  10. THERE ARE NO "ON LOT" STORM WATER MANAGEMENT FEATURES ON THIS LOT.
  11. THERE ARE NO STREAMS, PONDS, FLOOD PLAINS OR 25% AND GREATER SLOPES ON THIS LOT.
  12. SYSTEM DESIGNED FOR 5 BEDROOMS.

- GENERAL NOTES:**
1. THIS AREA DESIGNATES A PRIVATE SEWAGE AREA OF AT LEAST 10,000 SQUARE FEET AS REQUIRED BY THE MARYLAND STATE DEPARTMENT OF THE ENVIRONMENT FOR INDIVIDUAL SEWAGE DISPOSAL IMPROVEMENTS OF ANY NATURE IN THIS AREA ARE RESTRICTED UNTIL PUBLIC SEWERAGE IS AVAILABLE. THESE AREAS SHALL BECOME NULL AND VOID UPON CONNECTION TO A PUBLIC SEWERAGE SYSTEM. THE COUNTY HEALTH OFFICER SHALL HAVE THE AUTHORITY TO GRANT ADJUSTMENTS TO THE PRIVATE SEWAGE AREA. RECORDATION OF MODIFIED SEWAGE AREA SHALL NOT BE NECESSARY.
  2. TOPOGRAPHY SHOWN IS TWO-FOOT CONTOUR INTERVALS AND HAS BEEN FIELD VERIFIED OR FIELD RUN.
  3. ANY CHANGES TO A PRIVATE SEWAGE AREA SHALL REQUIRE A REVISED PERC CERTIFICATION PLAN.
  4. EXISTING WELLS, SEPTIC SYSTEMS, AND SEWAGE DISPOSAL AREAS WITHIN 100' OF THE PROPERTY AND THOSE WITHIN 200' DOWNGRADEMENT OF EXISTING OR PROPOSED SEPTIC OR SEWAGE DISPOSAL AREAS HAVE BEEN SHOWN USING ALL REASONABLE EFFORTS.
  5. THE LOT SHOWN HERON WAS RECORDED ON THE PLAT # 18214 ET. SEQ. REFER TO PLAT FOR LOT DIMENSIONS, LOT AREAS, ALL EASEMENTS, LOT AREAS, ALL EASEMENTS, ANY RESTRICTIONS, AND PROVISIONS.
  6. THE EXISTING WELLS SHOWN ON THIS PLAN HAVE BEEN FIELD LOCATED BY A PROFESSIONAL LAND SURVEYOR AND ARE ACCURATELY SHOWN.
  7. TESTING AND RESULTS FOR GROSS ALPHA, GROSS BETA AND VOC'S WILL BE REQUIRED PRIOR TO USE AND OCCUPANCY.

**SITE SPECIFIC NOTES**

1. Plot Plan Lot # 6
2. ALL DRIVEWAY CULVERTS ARE TO BE 15" RCP OR HDPE WITH MINIMUM 9" COVER
3. ANY WELL DRILLED WITHIN 10' OF DRIVEWAY TO BE PROTECTED WITH TWO BOLLARDS.
4. PAVING SPECIFICATIONS: 2" ASPHALT OVER 4" CR-6 OR 2.5" ASPHALT OVER 1.5" OVERLAY

**PROPOSED ELEVATIONS:**

TOP OF BASEMENT SLAB:	439.2	GRADE AT HOUSE INVERT:	445.0
TOP OF FOUNDATION WALL:	447.8	GRADE AT SEPTIC TANK:	442.0
TOP OF FIRST SUBFLOOR:	449.0	GRADE AT DISTRIBUTION BOX:	441.5
		GRADE AT TRENCHES:	440.5
INVERT OUT OF HOUSE:	443.5		
INVERT INTO TANK:	440.6		
INVERT OUT OF TANK:	440.3		
INVERT INTO DISTRIBUTION BOX:	440.0		

APPROVED FOR PRIVATE WATER AND PRIVATE SEWERAGE SYSTEMS IN CONFORMANCE WITH THE MASTER PLAN OF HOWARD COUNTY.

*Maura J. Rossman*  
Maura J. Rossman, M.D., Health Officer  
DATE: 10/29/2013

I certify that the information shown heron is based on field work performed under my direct supervision and is correct, to the best of my knowledge and belief.

*Dale Thompson*  
Dale Thompson  
DATE: 25 Sep 2013

**SEPTIC DESIGN PARAMETERS:**

1st Floor Sq. Ft.	3104 sq.ft.
2nd Floor Sq. Ft.	3891 sq.ft.
Basement Sq. Ft.	3104 sq.ft.
Number of Bedrooms	5

**TAGGED WELL DATA**

TAG NUMBER:	HO-95-0228
NORTHING:	559125.2883
EASTING:	1326613.8416
WELL YIELD:	15 GPM
WELL DEPTH:	300'

**DEVELOPER:** Dayton Oaks, LLC  
**BUILDER:** Compass Homes  
6206 Heather Glen Way  
Clarksville, MD 21029  
**SCALE:** 1:30  
**DATE:** 9/25/13

**PROJECT NAME:** Phung Residence PC-6  
PRESERVE @ CLARKSVILLE  
CLARKSVILLE  
HOWARD COUNTY  
MARYLAND

**TITLE:** SITE PLAN LOT #6  
6238 Heather Glen Way  
Clarksville, Maryland 21029

**PURPOSE:** *Revise Well Box Easement Revised perc cert*