



Building Permit Application

Howard County Maryland
Department of Inspections, Licenses and Permits
3430 Court House Drive
Permits: 410-313-2455
www.howardcountymd.gov

Date Received: _____

Health

Permit No.: B15001080

Filing Address: 6555 Belmont Woods Rd
 City: Elkridge State: Md Zip Code: 21075
 Site/Apt. #: _____ SDP/WP/BA #: _____
 Census Tract: 601104 Subdivision: 0008
 Section: _____ Area: _____ Lot: _____
 Tax Map: 0032 Parcel: 0002 Grid: 0019
 Zoning: _____ Map Coordinates: _____ Lot Size: 68,1900
 Existing Use: Rec + Parks Historic Rental Facility - Tent
 Proposed Use: same
 Estimated Construction Cost: \$ 74,000 FROM 4-1-15 TO 12-1-15
 Description of Work: Belman Manor Tent - 60x80 pole tent, back of manor, temporary Apr - Nov used for rental events - NO FOOD PREP
 Occupant or Tenant: Howard Co. Rec + Parks
 Was tenant space previously occupied? Yes No
 Contact Name: Catherine Allen - employee
 Address: 6555 Belmont Woods Rd
 City: Elkridge State: Md Zip Code: 21075
 Phone: 410 313-1686 Fax: _____
 Email: callen@howardcountymd.gov

Property Owner's Name: How. Co. Recreation + Parks
 Address: 7120 Oakland Mills Rd
 City: Columbia State: Md Zip Code: 21046
 Phone: see below Fax: _____
 Email: _____
 Applicant's Name & Mailing Address, (if other than stated herein)
 Applicant's Name: John Marshall, Chief
 Address: 7120 Oakland Mills Rd
 City: Columbia State: Md Zip Code: 21046
 Phone: 410 313 1081 Fax: _____
 Email: jmarshall@howardcountymd.gov
 Contractor Company: Party Palace Rentals
 Contact Person: Dave Kaddy
 Address: 1615 Robin Circle Forest Hill, Md
 City: Bethesda State: Md Zip Code: 21058
 License No.: 09943869
 Phone: 410 836 0085 Fax: 410 836 0086
 Email: dave@partypalacerentals.com
 Engineer/Architect Company: _____
 Responsible Design Prof.: _____
 Address: _____
 City: _____ State: _____ Zip Code: _____
 Phone: _____ Fax: _____
 Email: _____

Commercial Building Characteristics	Residential Building Characteristics	
Height:	<input type="checkbox"/> SF Dwelling <input type="checkbox"/> SF Townhouse	
No. of stories:	Depth	Width
Gross area, sq. ft./floor:	1 st floor:	
	2 nd floor:	
Area of construction (sq. ft.):	Basement:	
	<input type="checkbox"/> Finished Basement	
Use group:	<input type="checkbox"/> Unfinished Basement	
	<input type="checkbox"/> Crawl Space	
Construction type:	<input type="checkbox"/> Slab on Grade	
<input type="checkbox"/> Reinforced Concrete	No. of Bedrooms:	
<input type="checkbox"/> Structural Steel	Multi-family Dwelling	
<input type="checkbox"/> Masonry	No. of efficiency units:	
<input type="checkbox"/> Wood Frame	No. of 1 BR units:	
<input type="checkbox"/> State Certified Modular	No. of 2 BR units:	
	No. of 3 BR units:	
	Other Structure:	
	Dimensions:	
<input checked="" type="checkbox"/> Roadside Tree Project Permit:	Footings:	
<input type="checkbox"/> Yes <input checked="" type="checkbox"/> No	Roof:	
<input type="checkbox"/> Roadside Tree Project Permit #:	<input type="checkbox"/> State Certified Modular	
	<input type="checkbox"/> Manufactured Home	

Utilities	
Water Supply	
<input type="checkbox"/> Public	
<input checked="" type="checkbox"/> Private	
Sewage Disposal	
<input type="checkbox"/> Public	
<input checked="" type="checkbox"/> Private	
Electric: <input type="checkbox"/> Yes <input type="checkbox"/> No	
Gas: <input type="checkbox"/> Yes <input type="checkbox"/> No	
Heating System	
<input type="checkbox"/> Electric <input type="checkbox"/> Oil	
<input type="checkbox"/> Natural Gas <input type="checkbox"/> Propane Gas	
<input type="checkbox"/> Other:	
Sprinkler System:	
<input type="checkbox"/> Yes <input type="checkbox"/> No	
Grading Permit Number:	
Building Shell Permit Number:	

THE UNDERSIGNED HEREBY CERTIFIES AND AGREES AS FOLLOWS: (1) THAT HE/SHE IS AUTHORIZED TO MAKE THIS APPLICATION; (2) THAT THE INFORMATION IS CORRECT; (3) THAT HE/SHE WILL COMPLY WITH ALL REGULATIONS OF HOWARD COUNTY WHICH ARE APPLICABLE THERETO; (4) THAT HE/SHE WILL PERFORM NO WORK ON THE ABOVE REFERENCED PROPERTY NOT SPECIFICALLY DESCRIBED IN THIS APPLICATION; (5) THAT HE/SHE GRANTS COUNTY OFFICIALS THE RIGHT TO ENTER ONTO THIS PROPERTY FOR THE PURPOSE OF INSPECTING THE WORK PERMITTED AND POSTING NOTICES.

Applicant's Signature: [Signature]
 Email Address: jmarshall@howardcountymd.gov
 Title/Company: Chief, Bureau of Parks and Program Services
Howard Co. Dept. of Recreation and Parks

Print Name: John Marshall
 Date: 3/27/2015
 Per Bob Lalush this is a govt. use

Checks Payable to: DIRECTOR OF FINANCE OF HOWARD COUNTY
 PLEASE WRITE NEATLY & LEGIBLY
FOR OFFICE USE ONLY

AGENCY	DATE	SIGNATURE OF APPROVAL
State Highways		
Building Officials		
PSZA (Zoning)		
PSZA (Engineering)		
Health	<u>4/1/15</u>	<u>[Signature]</u>


Is Sediment Control approval required for issuance? Yes No
 CONTINGENCY CONSTRUCTION START

DPZ SETBACK INFORMATION	
Front:	
Rear:	
Side:	
Side St.:	
All minimum setbacks met?	<input type="checkbox"/> Yes <input type="checkbox"/> No
Is Entrance Permit Required?	<input type="checkbox"/> Yes <input type="checkbox"/> No
Historic District?	<input type="checkbox"/> Yes <input type="checkbox"/> No
Lot Coverage for New Town Zone:	
SDP/Red-line approval date:	

Filing Fee	\$	
Permit Fee	\$	<u>NA</u>
Tech Fee	\$	
Excise Tax	\$	
PSFS	\$	
Guaranty Fund	\$	
Add'l per Fee	\$	
Total Fees	\$	
Sub- Total Paid	\$	
Balance Due	\$	
Check	#	



Belmont Manor and Historic Park
6555 Belmont Woods Rd
Elkridge, MD 21075

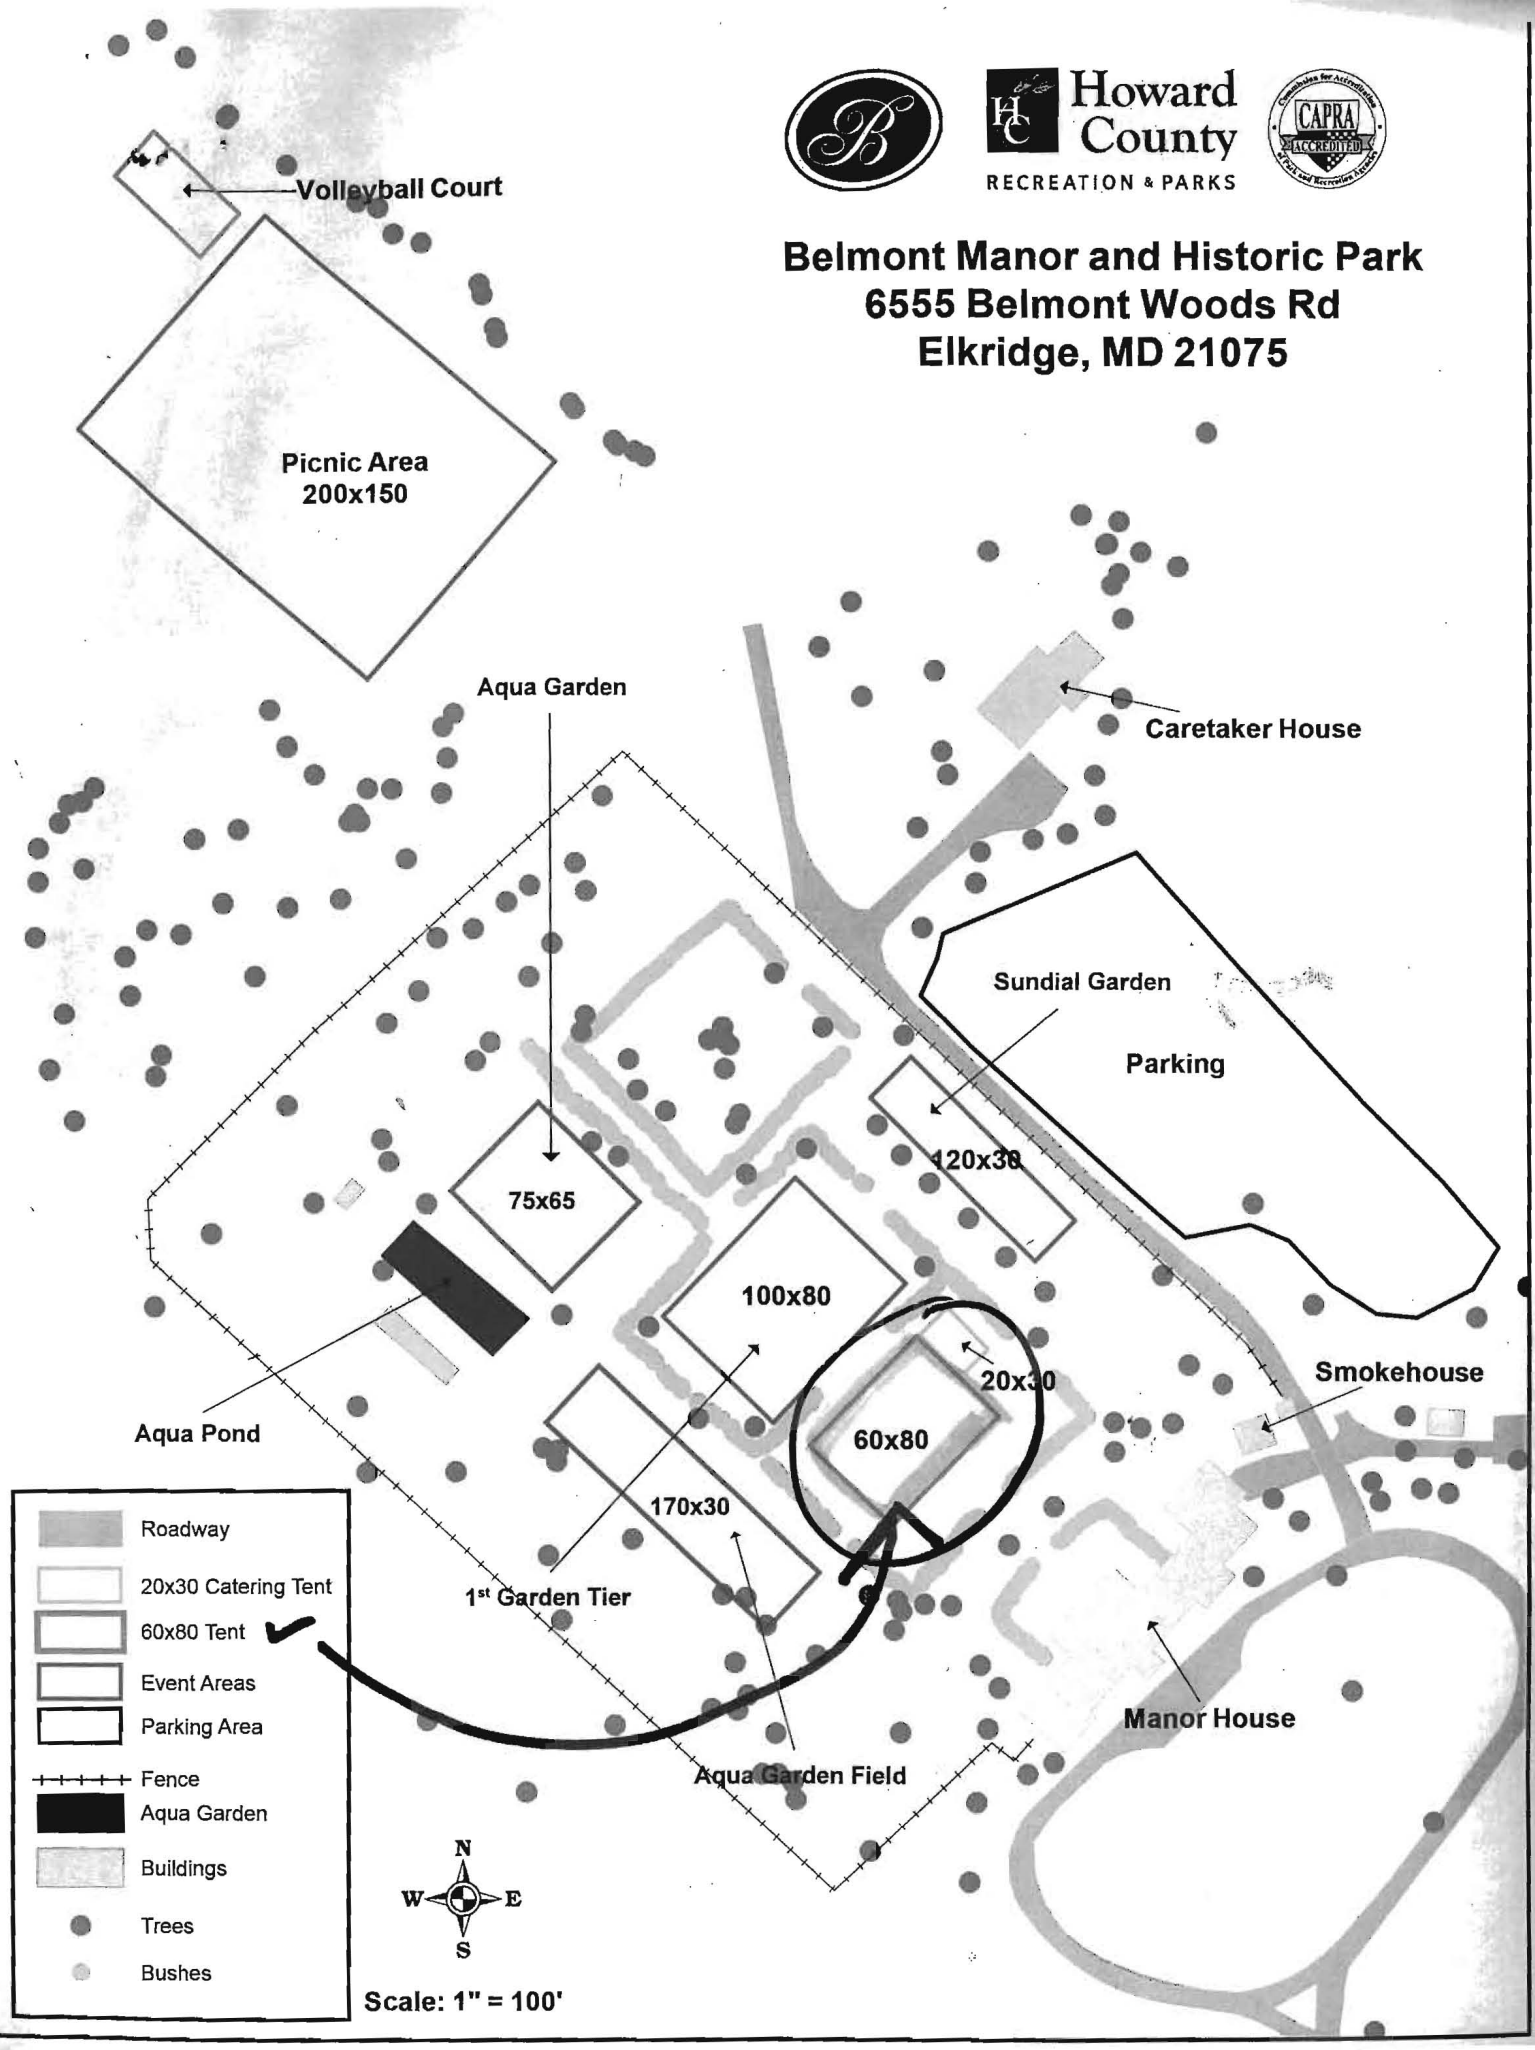

	Roadway
	20x30 Catering Tent
	60x80 Tent ✓
	Event Areas
	Parking Area
	Fence
	Aqua Garden
	Buildings
	Trees
	Bushes



Scale: 1" = 100'

221000 11/20/88 11:11

