

12/23/75
a.m. if possible

PERMIT

P 21903

SEWAGE DISPOSAL SYSTEM

A 21290

MARYLAND STATE DEPARTMENT OF HEALTH

HOWARD COUNTY

ELLICOTT CITY

INDEXED

DISTRICT 5th

05-375177

DATE 7/30/75

Edwin G. Willson Builder, Inc. (Jack Fyrd) PERMITTED TO INSTALL ALTER

ADDRESS P. O. Box 32, Ashton, Maryland PHONE 774-9698

A SEWAGE DISPOSAL SYSTEM LOCATED AT

14215 CLARKVILLE PIKE

SUBDIVISION (Fox Haven) ROAD Route 108 LOT 26

PROPERTY OWNER ~~Edwin G. Willson~~ RYAN ROTH

ADDRESS same as above

SPECIFICATIONS 4 bedrooms

DRAIN FIELD DEPTH FEET, BOTTOM AREA SQ. FT.

SEEPAGE PITS ABSORBENT SIDE-WALL AREA SQ. FT.

SEPTIC TANK CAPACITY 1250 GALLONS

FOR GARBAGE GRINDER, INCREASE DISPOSAL AREA 22% & TANK CAPACITY 50%.

OTHER DRY WELL AND TRENCH - 300 sq. ft. absorbent sidewall area to begin below the first 3/4 ft. of original grade with maximum depth permitted for dry well 10 1/2 ft. below original grade. Dry well inlet to be 3 ft. below original grade. Come off dry well 5 ft. - solid pipe and begin trench (earth buffer). Trench to be 10 1/2 ft. deep - 52 ft. long - 7 ft. gravel under pipe. Place dry well 140 ft. from rear lot line and (309.22 line) and 30 ft. from the left side line (445.98 line) as seen when facing from the road. Call for inspection of trench before gravel is installed.

NOTE: ALL PIPE FROM HOUSE TO DISPOSAL AREA MUST BE CAST IRON. PERMIT VOID AFTER THREE YEARS. NOTE: INSTALL STAND PIPE ON SEPTIC TANK AND DRY WELL. STAND PIPES MUST BE 6 INCHES IN DIAMETER. CAST IRON, CONCRETE OR TERRA COTTA ACCEPTED.

PLANS APPROVED BY Donald W. Monaghan DATE 7/29/75

FILL SEPTIC TANK AND DISTRIBUTION BOX WITH WATER BEFORE CALLING FOR AN INSPECTION. COVER NO WORK UNTIL INSPECTED AND APPROVED.

NEITHER THE HOWARD COUNTY COMMISSIONERS NOR THE HEALTH DEPARTMENT IS RESPONSIBLE FOR THE SUCCESSFUL OPERATION OF ANY SYSTEM.

pool permit signed
#39256 3/18/79


A 21290

3/2/06 - BOO 157922 - 2ND STORY ADDITION

SITE INSPECTION SHEET

OWNER: RYAN ROTA PHONE #: _____
ADDRESS: 14215 Rt 108 CONTRACTOR: _____
SUBDIVISION: _____ LOT: _____ WELL TAG #: _____
PROPOSAL: _____ COUNTY #: _____

LOCATION DIAGRAM

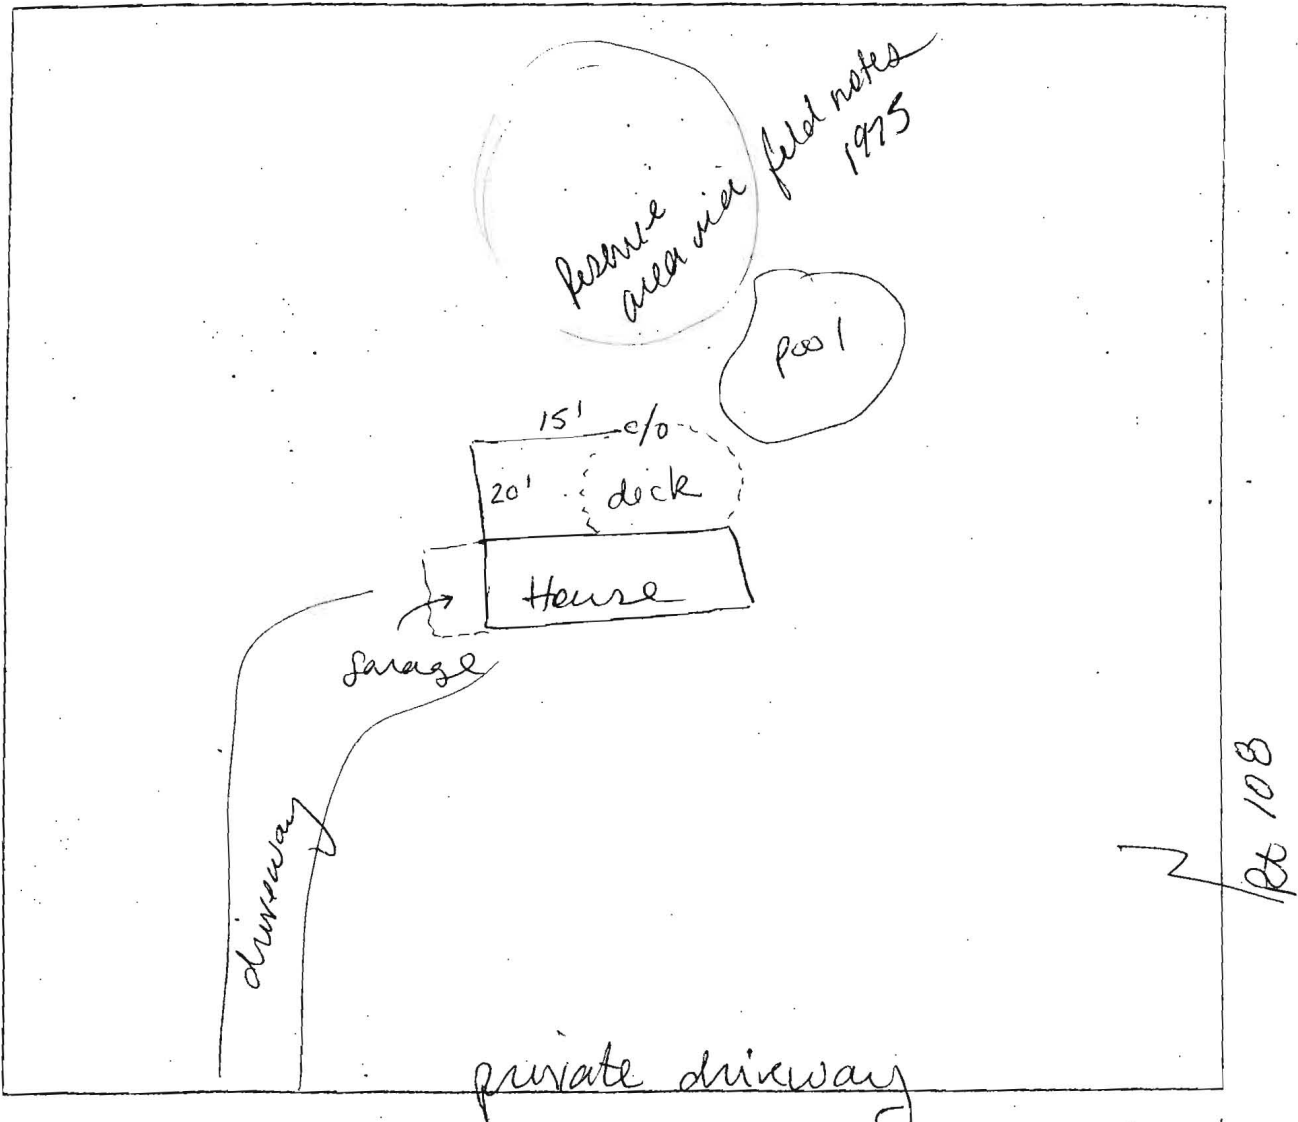

COMMENTS: location as shown on field notes dated 12/23/75. Current system ok. 2/27/06 (SR)

Freedom Septic Service, Inc
2809 Liberty Road
Sykesville, MD 21784

Phone:(410) 795-2947
(800) 278-3078
Fax: (410) 549-1163
E-mail: freedomseptic@netzero.com

March 1, 2006

To whom it may concern:

This letter is to state that Freedom Septic Service Inc. has pumped 1,000 gallons out of the septic system located at:

14215 Clarksville Pike
Highland MD 20777

On this date March 1, 2006.

If there are any questions feel free to call the office at 410-795-2947.