

C1 8583

SEQUENCE NO. (MDE USE ONLY)

STATE OF MARYLAND WELL COMPLETION REPORT

THIS REPORT MUST BE SUBMITTED WITHIN 45 DAYS AFTER WELL IS COMPLETED.

1 2 3 6 (THIS NUMBER IS TO BE PUNCHED IN COLS. 3-6 ON ALL CARDS)

COUNTY NUMBER 13

ST/CO USE ONLY DATE Received MM DD YY

DATE WELL COMPLETED MM DD YY 4 8 10

Depth of Well 22 220 26 (TO NEAREST FOOT)

PERMIT NO. FROM "PERMIT TO DRILL WELL" OK 4/30/15 SC HO-95-1894

OWNER Splitter Philip STREET OR RFD 3775 Chatham Rd TOWN Ellicott City SUBDIVISION SECTION LOT 12

WELL LOG Table with columns: DESCRIPTION, FEET (FROM, TO), check if water bearing. Includes entries for Top Soil, Brown Clay, and Sandstone.

GROUTING RECORD: WELL HAS BEEN GROUTED (Y), TYPE OF GROUTING MATERIAL (CM, BC), NO. OF BAGS (6), NO. OF POUNDS (300), GALLONS OF WATER (150), DEPTH OF GROUT SEAL (0 to 220 ft).

CASING RECORD: MAIN CASING TYPE (PL), Nominal diameter top (main) casing (1 inch), Total depth of main casing (220 feet).

OTHER CASING (if used) diameter inch, depth (feet) from to

SCREEN RECORD: screen type or open hole (ST, BR, HO, PL, OT), DEPTH (nearest ft.)

NUMBER OF UNSUCCESSFUL WELLS: 0

WELL HYDROFRACTURED (Y), CIRCLE APPROPRIATE LETTER (A, E, P)

I HEREBY CERTIFY THAT THIS WELL HAS BEEN CONSTRUCTED IN ACCORDANCE WITH COMAR 26.04.04 "WELL CONSTRUCTION" AND IN CONFORMANCE WITH ALL CONDITIONS STATED IN THE ABOVE CAPTIONED PERMIT...

DRILLERS LIC. NO. 1 M SD 150 DRILLERS SIGNATURE (Must match signature on application) LIC. NO. 1 D

SITE SUPERVISOR (sign. of driller or journeyman responsible for sitework if different from permittee)

DEPTH (nearest ft.) Table with columns 1-24 and rows E, A, C, H, S, C, R, E, E, N

GRAVEL PACK IF WELL DRILLED WAS FLOWING WELL INSERT F IN BOX 68

MDE USE ONLY (NOT TO BE FILLED IN BY DRILLER) T (E.R.O.S.) W Q 70 72 74 75 76 TELESCOPE CASING LOG INDICATOR OTHER DATA

PUMPING TEST: HOURS PUMPED (6), PUMPING RATE (11), METHOD USED TO MEASURE PUMPING RATE, WATER LEVEL (distance from land surface) BEFORE PUMPING (17 to 20 ft), WHEN PUMPING (22 to 25 ft), TYPE OF PUMP USED (A, C, J, P, R, S, T, O, other)

PUMP INSTALLED: DRILLER INSTALLED PUMP (YES), IF DRILLER INSTALLS PUMP, THIS SECTION MUST BE COMPLETED FOR ALL WELLS. TYPE OF PUMP INSTALLED PLACE (A,C,J,P,R,S,T,O) IN BOX 29. CAPACITY: GALLONS PER MINUTE (31 to 35), PUMP HORSE POWER (37 to 41), PUMP COLUMN LENGTH (43 to 47), CASING HEIGHT (circle appropriate box and enter casing height) above/below LAND SURFACE (4 nearest foot)

LOCATION OF WELL ON LOT: SHOW PERMANENT STRUCTURE SUCH AS BUILDING, SEPTIC TANKS, AND /OR LANDMARKS AND INDICATE NOT LESS THAN TWO DISTANCES (MEASUREMENTS TO WELL)

* Please See Attached *

B 1 **5018**
1 2 3 6

SEQUENCE NO.
(MDE USE ONLY)

STATE OF MARYLAND
APPLICATION FOR PERMIT TO DRILL WELL
W532579 please type

STATE PERMIT NUMBER
HO-95-1894
70 *fill in this form completely* 79

Date Received (APA)
OWNER INFORMATION
8 MM DD YY 13
Spitler Philip
15 Last Name Owner First Name 34
36 *3745 Chatham Rd.*
Street or RFD 55
57 *Ellicott City MD 21042*
Town 70 State 72 Zip 76

B 3 **LOCATION OF WELL**
8 COUNTY *Howard* 21
23 SUBDIVISION *Macalpine* 42
SECTION *2* 44 46 LOT *12* 48 50
52 NEAREST TOWN *Ellicott City* 71
MILES FROM TOWN (enter 0 if in town) *0* M I
73 76 77 78

DRILLER INFORMATION
Curtis Winslow M S D 150
Driller's Name 76 License No. 81
Winslow Pump and Well, Inc.
Firm Name
P.O. Box 521 Hollywood, MD 20636
Address
Curtis Winslow 3.25.10
Signature Date

B 4
1 2 DIRECTION OF WELL FROM TOWN (CIRCLE BOX)
3745 Chatham Rd.
11 NEAR WHAT ROAD 30
ON WHICH SIDE OF ROAD (CIRCLE APPROPRIATE BOX)
NORTH N
WEST W
EAST E
SOUTH S
34 *930* 37
DISTANCE FROM ROAD ENTER FT OR MI 38 39
TAX MAP: *24* BLK: *16* PARCEL *168*

B 2 **WELL INFORMATION**
1 2 APPROX. PUMPING RATE (GAL. PER MIN.) *0*
8 12
AVERAGE DAILY QUANTITY NEEDED (GAL. PER DAY) *0*
14 20

USE FOR WATER (CIRCLE APPROPRIATE BOX)
 D DOMESTIC POTABLE SUPPLY & RESIDENTIAL IRRIGATION
 F FARMING (LIVESTOCK WATERING & AGRICULTURAL IRRIGATION)
22 I INDUSTRIAL, COMMERCIAL, DEWATERING
 P PUBLIC WATER SUPPLY WELL
 T TEST, OBSERVATION, MONITORING
 G GEO-THERMAL *3*

NOT TO BE FILLED IN BY DRILLER HEALTH DEPARTMENT APPROVAL
Howard (13) Public
COUNTY NAME COUNTY NO.
STATE SIGNATURE INSERT S → 41
DATE ISSUED *4/28/2010 Brian Baker 4/28/2011*
43 MM DD YY 48 CO SIGNATURE EXP. DATE
NORTH GRID *522 000* EAST GRID *847 000*
50 55 57 63


APPROXIMATE DEPTH OF WELL *250* FEET
24 28
APPROXIMATE DIAMETER OF WELL _____ NEAREST INCH

SHOW MAJOR FEATURES OF BOX & LOCATE WELL WITH AN X
SOURCES OF DRILLING WATER
1. *Deep Drilled Well*
2.
3.
WRITE THE BOX NUMBER FROM THE MAP HERE
E *847*
N *522*
000
000

METHOD OF DRILLING (circle one)
BORED (or Augered) JETTED Jetted & DRIVEN
30 AIR-ROTary AIR-PERcussion **ROTARY** (Hydraulic Rotary)
37 CABLE REVERSE-ROTary DRIVE-POINT
other _____


REPLACEMENT OR DEEPEINED WELLS (CIRCLE APPROPRIATE BOX)
 N THIS WELL WILL NOT REPLACE AN EXISTING WELL
 Y THIS WELL WILL REPLACE A WELL THAT WILL BE ABANDONED AND SEALED
39 S THIS WELL WILL REPLACE A WELL THAT WILL BE USED AS A STANDBY-CONTACT LOCAL APPROVING AUTHORITY FOR POLICY ON STANDBY WELLS
 D THIS WELL WILL DEEPEIN AN EXISTING WELL
PERMIT NUMBER OF WELL TO BE REPLACED OR DEEPEINED (IF AVAILABLE) 41 _____ 52

Not to be filled in by driller (MDE OR COUNTY USE ONLY)
APPROP. PERMIT NUMBER _____ G _____
PERMIT No. *HO 95-1894*
70 71 72 73 74 75 76 77 78 79

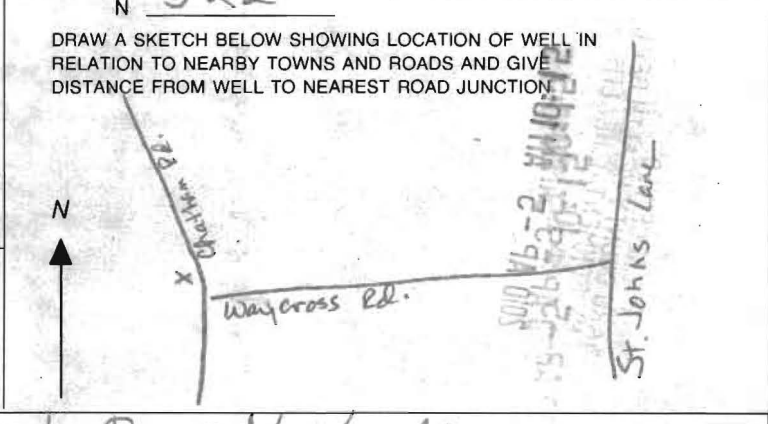

SPECIAL CONDITIONS *Grout/Slurry Needs to Be 2 lbs/gallon or 25 gallons per bag*
NOTE - APPROVING AUTHORITIES SHOULD USE SEPARATE SHEET IF NEEDED
DENV-Permit 97 © COUNTY

Phil Spitzer
3745 Chatham Rd.
Ellicott City, MD
Howard County

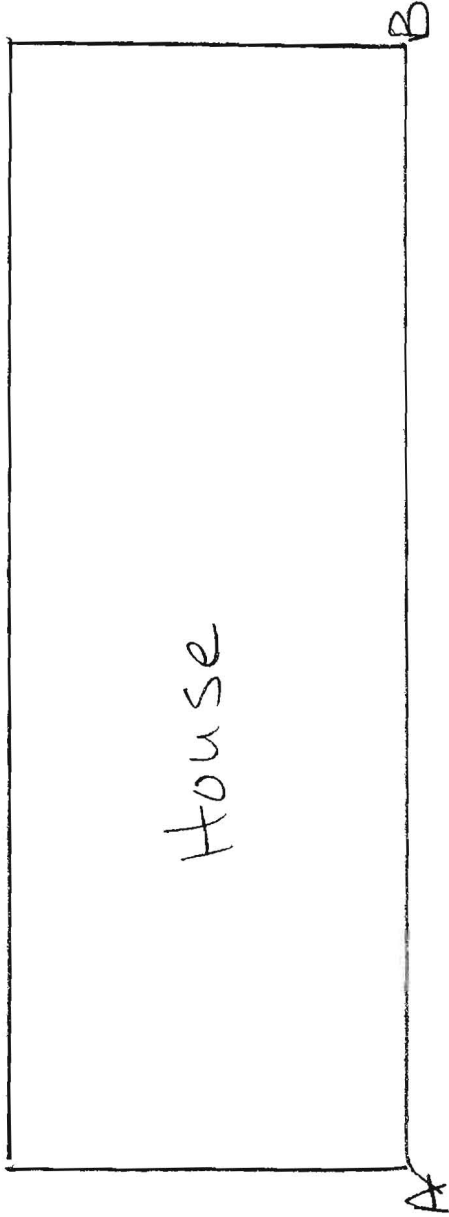

Well Number	A	B
1	87.7	56.6
2	101.3	55.6
3	95	42.4

(X) 3

(X) 2

(X) 1

WaterFurnace

Grouting Mixture
Procedures

~~33 gallons of water~~
~~11 ounces of EZ Mud~~
~~50 pound bag of Benseal~~

OR:

2 1/2 gal

Gallons
 25 ~~to 30~~ gallons of water

1-1/2 quarts of Aqua Grout

50 pound bag of Benseal

3035 [] 105-PE-345434C ----- 02100015050 TITUSVILLE PA 0002932 FT---

35 [] 105-PE-345434C ----- 02100015050 TITUSVILLE PA 0002868 FT---

SPECIFICATIONS

Charter Plastics Geothermal Pipe is manufactured from NSF Certified, High Density Polyethylene resins listed in PPI TR-4 as a PE 3408 Piping formulation. These materials carry a recommended Hydrostatic Design Basis (HDB) of 1,600 psi and a maximum recommended Hydrostatic Design Stress (HDS) of 800 psi at 73°F.


Charter Geothermal Pipe is manufactured and rated according to the following standards:

Material: ASTM D 3350, ASTM D 2837, ASTM D 1693,
 Pipe: ASTM D 3035, ASTM D 2447, ASTM F714,
 ASTM D 2513 (Sections 4.1 and 4.2)

All Charter Geothermal Pipe complies with the standards set forth by the International Ground Source Heat Pump Association (IGSHPA), Sections IC, 2.1 thru 2.4.

A certification of materials is available by request.

Charter Plastics offers the following products specifically engineered to meet the performance demands of geothermal installations:

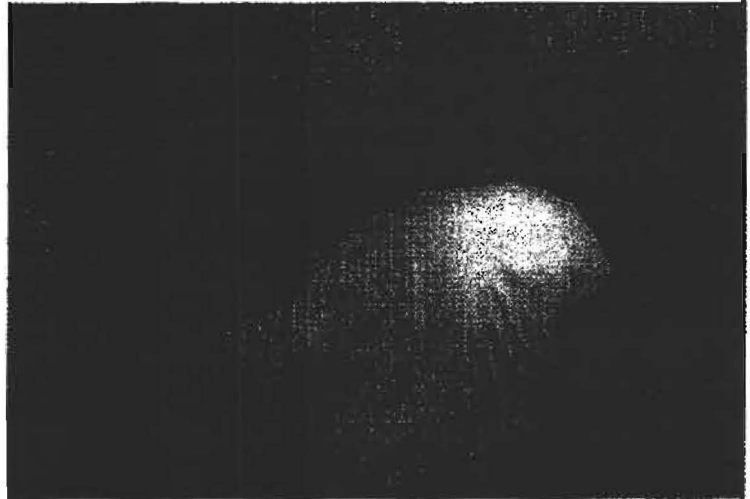

Hydrostatic Burst Testing

PROPERTIES	CHARTER GEO PIPE	CHARTER GEO — HT (HIGH TENSILE)
Minimum Year Hydrostatic Strength @ 73° F, ASTM D 2837	>5000 hours	>5000 hours
UV Stabilizer, ASTM D 1603	1600 psi	1600 psi
	2% - 2.5% C	2% - 2.5% C

Grouting Issues Related to the Vertical Closed-Loop Ground Heat Exchanger

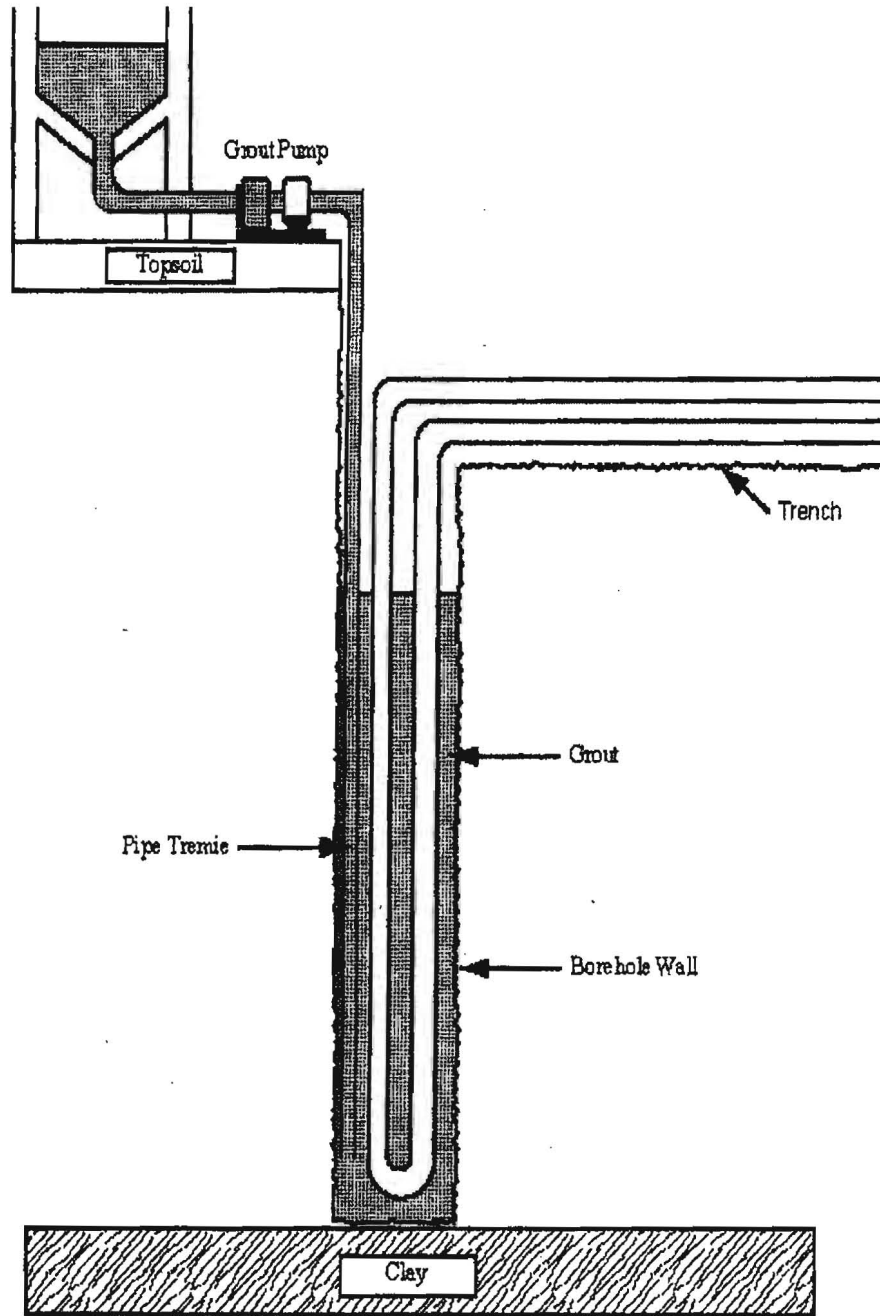


Figure 1-8 Tremie Pipe Method with Pump.

Grout Properties and Vertical GHEX design

Table 2-1
Commercially Available Bentonite Grouting Materials

Product	Solids (%)	Water (Gal)	Yield¹ (Gal)	Grout¹ Weight (lb/Gal)	Thermal^{1,2} Conductivity (Btu/hr ft F)	Permeability^{1,2,3} (cm/s)
Aquaguard	30	14	16.8	9.92	0.43	1x10 ⁻⁶
Aquagrout	22.7	20	23.2	9.50	0.43	8x10 ⁻⁸
Benseal/EZ Mud	15.3	33	36.6	8.94	0.38	6x10 ⁻⁸
BH Grout	30	14	16.8	9.93	0.45	3x10 ⁻⁸
Enviroplug	30	14	16.9	9.86	0.44	1x10 ⁻⁸
Groutwell ⁴	18	27	30.7	9.05	0.41	1x10 ⁻⁷
Puregold	30	14	16.9	9.87	0.44	2x10 ⁻⁸
Quick Grout	20	23	27.0	9.25	0.41	3x10 ⁻⁷
Volclay Grout	20	23	27.5	9.08	0.43	1x10 ⁻⁷

1. Paul and Remund et al (1996). 2. Remund et al (1993). 3. Measured permeability after approximately 80 hours. 4. Groutwell is a powdered bentonite product. Groutwell DF is a granular form of the same bentonite grout product, and displays the same physical properties.

Placement of the bentonite slurry into the borehole is generally done with a positive displacement pump and a tremie pipe. The ability to pump the grout through the tremie pipe depends on the viscosity of the grout slurry, which is a function of the type of bentonite grout being used and the time required to adequately mix and pump the slurry completely through the tremie pipe. Each of the bentonite grouting products were tested, at manufacturer's recommended percent solids, for viscosity as a function of time (Heiberger and Remund, 1997). There are significant differences in the viscosities of the various bentonite grouting products. Grouts with lower viscosities will pump easier, and those that have low and relatively constant viscosities will provide a longer working time. This should always be considered when selecting a bentonite grout so that the grouting contractor can effectively place the grout into the GHEX borehole after insertion of the U-bend.

Heiberger and Remund (1997) measured pumping pressures that were required to pump all of the commercially available bentonite grouts as a function of grout flow rate, tremie pipe diameter and pumping time. Results of those tests are summarized in