

B 1 3130 SEQUENCE NO. (MDE USE ONLY) STATE OF MARYLAND STATE PERMIT NUMBER
 1 2 3 6 **APPLICATION FOR PERMIT TO DRILL WELL** HO-95-1849
W532465 please type 70 fill in this form completely 79

Date Received (APA) _____
OWNER INFORMATION
 8 MM DD YY 13
Duffy, Patrick
 15 Last Name Owner First Name 34
12020 Floating Mound Path
 36 Street or RFD 55
Clarksville, Md 21029
 57 Town 70 State 72 Zip 76

B 3 Howard LOCATION OF WELL
 8 COUNTY 21
Village of River Hill
 23 SUBDIVISION 42
 SECTION 4 LOT 47
 44 46 48 50
Clarksville
 52 NEAREST TOWN 71
 MILES FROM TOWN (enter 0 if in town) 10 M I
 73 76 77 78

DRILLER INFORMATION
Michael Barlow M W D 3555
 76 Driller's Name License No. 81
Barlow Well Drilling Service
 Firm Name
512 Underwood Ln, Bel Air, Md
 Address
Mike 11-20-09
 Signature Date

B 4 12020 Floating Mound Path
 1 2 DIRECTION OF WELL FROM TOWN (CIRCLE BOX)
 11 NEAR WHAT ROAD 30
 ON WHICH SIDE OF ROAD (CIRCLE APPROPRIATE BOX)
 NORTH SOUTH
 WEST EAST
 34 30 37
 DISTANCE FROM ROAD
 ENTER FT OR MI 38 39
 TAX MAP: 35 BLK: 7 PARCEL 457

B 2 **WELL INFORMATION**
 1 2 APPROX. PUMPING RATE (GAL. PER MIN.) 0
 8 12
 AVERAGE DAILY QUANTITY NEEDED (GAL. PER DAY) 000
 14 20

USE FOR WATER (CIRCLE APPROPRIATE BOX)
 DOMESTIC POTABLE SUPPLY & RESIDENTIAL IRRIGATION
 FARMING (LIVESTOCK WATERING & AGRICULTURAL IRRIGATION)
 INDUSTRIAL, COMMERCIAL, DEWATERING
 PUBLIC WATER SUPPLY WELL
 TEST, OBSERVATION, MONITORING
 GEO-THERMAL 2 x 450


NOT TO BE FILLED IN BY DRILLER HEALTH DEPARTMENT APPROVAL
Howard 13
 COUNTY NAME COUNTY NO.
 STATE SIGNATURE INSERT S → 41
 DATE ISSUED 12/11/2009 Brian Baber 12/11/2010
 43 MM DD YY 48 CO SIGNATURE EXP. DATE
 NORTH GRID 501 000 EAST GRID 821 000
 50 55 57 63

APPROXIMATE DEPTH OF WELL 450 FEET
 24 28

SHOW MAJOR FEATURES OF BOX & LOCATE WELL WITH AN X
 SOURCES OF DRILLING WATER
 1.
 2.
 3.
 WRITE THE BOX NUMBER FROM THE MAP HERE
 E 8201
 N 5001
 000
 000

METHOD OF DRILLING (circle one)
 BORED (or Augered) JETTED Jetted & DRIVEN
 30 AIR-ROTary AIR-PERCussion ROTARY (Hydraulic Rotary)
 37 CABLE REVERSE-ROTary DRIVE-POINT
 other _____

REPLACEMENT OR DEEPEMED WELLS (CIRCLE APPROPRIATE BOX)
 THIS WELL WILL NOT REPLACE AN EXISTING WELL
 THIS WELL WILL REPLACE A WELL THAT WILL BE ABANDONED AND SEALED
 THIS WELL WILL REPLACE A WELL THAT WILL BE USED AS A STANDBY-CONTACT LOCAL APPROVING AUTHORITY FOR POLICY ON STANDBY WELLS
 THIS WELL WILL DEEPEM AN EXISTING WELL
 PERMIT NUMBER OF WELL TO BE REPLACED OR DEEPEMED (IF AVAILABLE) 41 _____ 52


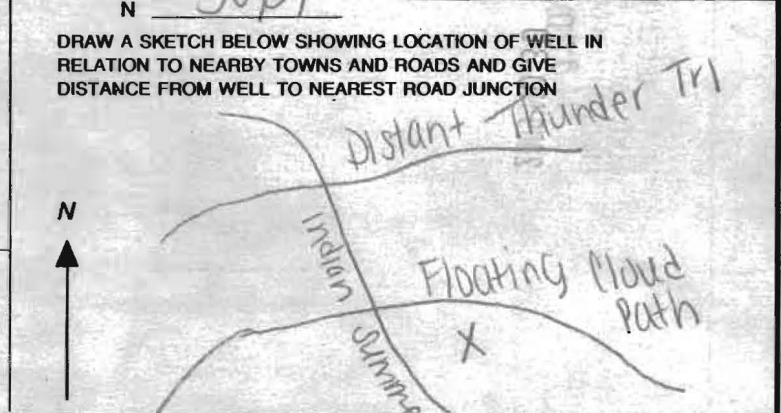


Not to be filled in by driller (MDE OR COUNTY USE ONLY)
 APPROP. PERMIT NUMBER _____ G _____
 PERMIT No. HO-95-1849
 70 71 72 73 74 75 76 77 78 79

SPECIAL CONDITIONS
 NOTE - APPROVING AUTHORITIES SHOULD USE SPECIAL CONDITIONS
Small Potholes From Bottom (P), Avoid Utility Lines

12/11/09
 Public Utilities -
 Boulder Locations Don't
 Compromise Public Health

BB

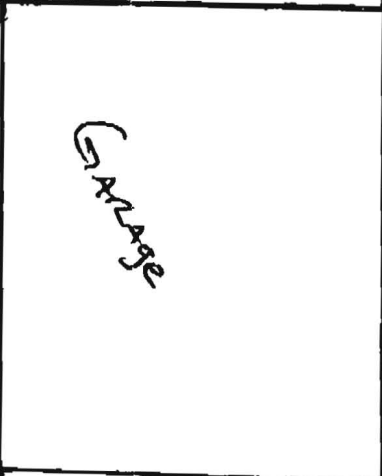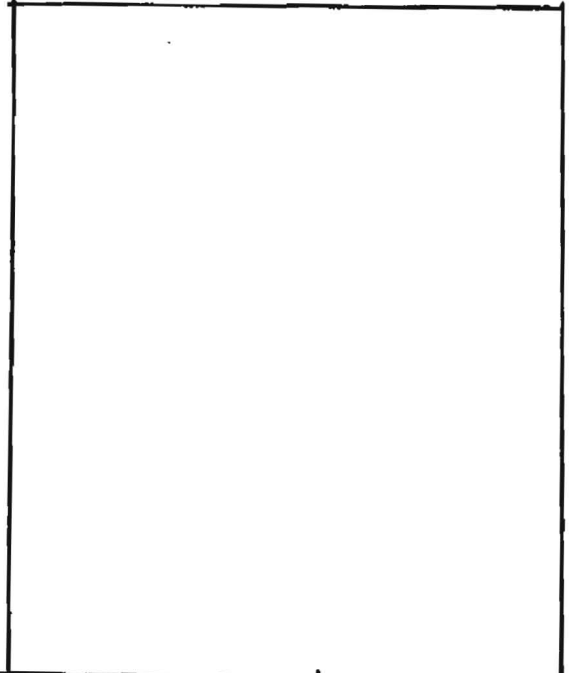

Garage




Side walk

12020 Floating Cloud Path

Driveway

Side walk

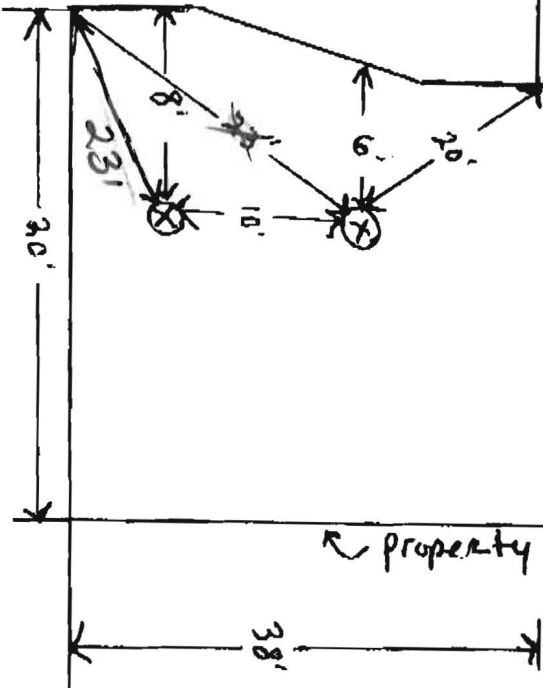

Property line