

PUB. SEWER STATUS VERIFIED BY _____

ISSUE DATE: _____

P 544485

APPROVAL DATE: 1/3/13

A REPAIR

PERMIT

Minor Septic Repair

ON-SITE SEWAGE DISPOSAL SYSTEM
HOWARD COUNTY HEALTH DEPARTMENT
BUREAU OF ENVIRONMENTAL HEALTH

Conceptual Building and Landscaping LTD IS PERMITTED TO INSTALL ALTER

ADDRESS: 9396 Baltimore National Pike, Ellicott City MD 21042 PHONE NUMBER: 443-463-4268

SUBDIVISION: Pindell Woods LOT NUMBER: 44

ADDRESS: 7004 Meandering Stream Way PROPERTY OWNER: David Diggins

SEPTIC TANK CAPACITY (GALLONS): N/A

PUMP CHAMBER CAPACITY (GALLONS): _____

NUMBER OF BEDROOMS: _____

SQUARE FEET OF HOUSE: _____

LINEAR FEET OF TRENCH REQUIRED: _____

TRENCHES:	Trench absorption area is adequate for 5 bedroom house.
LOCATION:	Expose distribution box. Confirm 2 lines feed the trenches to the left (facing back of lot). Cut 2 feeder lines to left trenches and seal at distribution box.
NOTES:	Call one day in advance for inspection.

PLANS APPROVED: Robert Bricker DATE: 12/20/12

NOTE: PERMIT VOID AFTER 2 YEARS

NOTE: CONTRACTOR RESPONSIBLE FOR SCHEDULING A PRE-CONSTRUCTION INSPECTION FOR ALL INSTALLATIONS

NOTE: WATERTIGHT SEPTIC TANKS REQUIRED

NOTE: ALL PARTS OF SEPTIC SYSTEM SHALL BE 100 FEET FROM ANY WATER WELL

NOTE: MANHOLE RISERS REQUIRED ON ALL SEPTIC TANKS AND PUMP CHAMBERS

**NEITHER THE HOWARD COUNTY COUNCIL OR THE HEALTH DEPARTMENT IS
RESPONSIBLE FOR THE SUCCESSFUL OPERATION OF ANY SYSTEM
PERMITTEE RESPONSIBLE FOR OBTAINING FINAL APPROVAL ON THIS PERMIT
CALL 410-313-1771 FOR INSPECTION OF SEPTIC SYSTEM**

NOT TO SCALE

See As-Built
3/19/04

ROAD NAME

TRENCH/DRAINFIELD DATA

WIDTH INLET BOTTOM

NUMBER OF TRENCHES
TOTAL LENGTH
ABSORPTION AREA
DISTRIBUTION BOX LEVEL
DISTRIBUTION BOX BAFFLE
DISTRIBUTION BOX PORT

SEPTIC TANK DATA

SEPTIC TANK 1 LEVEL
MANUFACTURER
CAPACITY GAL
SEAM LOC
TANK LID DEPTH
BAFFLES
BAFFLE FILTER
MANHOLE LOC
6" PORT LOC
WATERTIGHT TEST
SLOTTED
DATE ON LID

PUMP/SEPTIC TANK LEVEL
MANUFACTURER
CAPACITY GAL
SEAM LOC
TANK LID DEPTH
BAFFLES
BAFFLE FILTER
MANHOLE LOC
6" PORT LOC
WATERTIGHT TEST
SLOTTED
DATE ON LID

PRE-CONSTRUCTION:

INSTALLATION: 1/3/13 Side inspection confirmed 2 left-most trenches
near proposed pool has been disconnected @ Dist. box. OK
to cover. No As-built needed. See As-built done 3-19-04

FINAL INSPECTOR


K. [Signature]

DATE OF APPROVAL

1/13/13

Meandering Stream Way

NOT TO SCALE

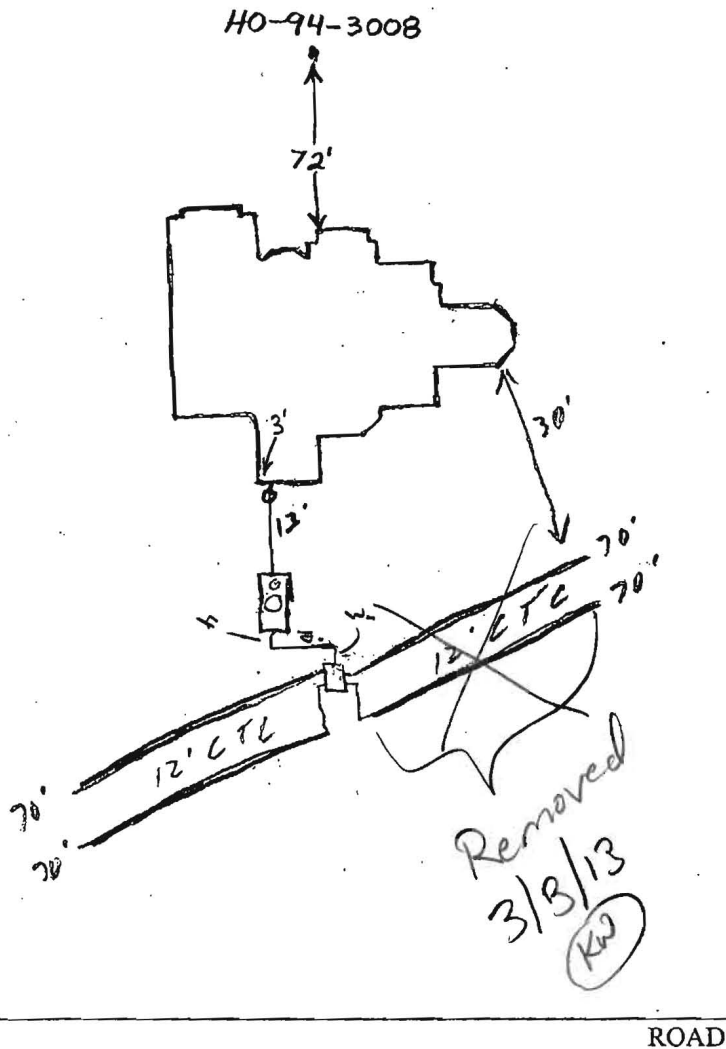

TRENCH/DRAINFIELD DATA		
WIDTH	INLET	BOTTOM
3'	4'	6'
NUMBER OF TRENCHES	4	
TOTAL LENGTH	280'	
ABSORPTION AREA	840 ϕ	
DISTRIBUTION BOX LEVEL	<input checked="" type="checkbox"/>	
DISTRIBUTION BOX BAFFLE	<input checked="" type="checkbox"/>	
DISTRIBUTION BOX PORT	<input checked="" type="checkbox"/>	

SEPTIC TANK DATA	
SEPTIC TANK 1 LEVEL	
CAPACITY	1500 GAL
SEAM LOC	Top
TANK LID DEPTH	1-2'
BAFFLES	<input checked="" type="checkbox"/>
BAFFLE FILTER	<input checked="" type="checkbox"/>
MANHOLE LOC	Center
6" PORT LOC	Front
WATERTIGHT TEST	<input checked="" type="checkbox"/>
SEPTIC TANK 2 LEVEL	
CAPACITY	_____ GAL
SEAM LOC	_____
TANK LID DEPTH	_____
BAFFLES	<input checked="" type="checkbox"/>
BAFFLE FILTER	<input checked="" type="checkbox"/>
MANHOLE LOC	_____
6" PORT LOC	_____
WATERTIGHT TEST	_____

PRE-CONSTRUCTION 3/18/04 Area staked. Contour is close to what is on B.P. plan. Place the distribution box in the middle of the installation essment and run trenches in both directions. Four 70' trenches are O.K. (BB) 3/19/04 - System installed. OK to cover all work (SO)

FINAL INSPECTOR *[Signature]*

DATE OF APPROVAL 3/19/04