

HOWARD COUNTY
PERMIT APPLICATION

PERMIT NUMBER
B07001417

Building Address 14680 DORSEY MILL RD
GLENWOOD, MD 21738
Suite/Apt. #: _____ SDP/WP/Petition #: _____
Census Tract 604002 Subdivision GLENWOOD
Section _____ Area _____ Lot _____
Tax Map 21 Parcel 30 Grid 16
Zoning RR Map Coordinates _____ Lot size 2.50 A

Property Owner's Name HELEN & RICHARD JUDD
Address 14680 DORSEY MILL RD
City GLENWOOD State MD Zip Code 21738
Home Phone 410-489-2632 Work Phone 443-538-0900
Applicant's Name & Mailing Address, (if other than stated hereon): _____
Phone _____ Fax _____

Existing Use RESIDENTIAL
Proposed Use RESIDENTIAL - NEW CONSTRUCTION
Estimated Construction Cost \$350,000
Description of Work SITE PREP, NEW HOUSE
CONSTRUCTION, DEMOLISH
EXISTING HOUSE

Contractor Company _____
Contact Person HELEN JUDD
Address SEE ABOVE
City _____ State _____ Zip Code _____
License No. _____
Phone _____ Fax _____

Occupant or Tenant HELEN & RICHARD JUDD
Contact Name HELEN JUDD
Address 14680 DORSEY MILL RD
City GLENWOOD State MD Zip Code 21738
Phone 410-489-2632 Fax 301-816-8665

Engineer or Architect Company CLARK, FINE FROCK & SACKETT
Contact Person DENNIS REAM
Address 7135 MINSTREL WAY 21045
City COLUMBIA State MD Zip Code 21045
Phone 410-381-7500 Fax 410-381-7533

BUILDING DESCRIPTION - COMMERCIAL

BUILDING DESCRIPTION - RESIDENTIAL

Building Characteristics	Utilities
Height: _____	Water Supply: _____ Public _____ Private _____
No. of stories: _____	Sewage Disposal: _____ Public _____ Private _____
Gross area, sq. ft. per floor: _____	Electric Yes <input type="checkbox"/> No <input type="checkbox"/>
Use group: _____	Gas Yes <input type="checkbox"/> No <input type="checkbox"/>
Construction type: _____ Reinforced Concrete _____ Structural Steel _____ Masonry _____ Wood Frame _____ State Certified Modular _____	Heating System: _____ Electric <input type="checkbox"/> Oil <input type="checkbox"/> Natural Gas <input type="checkbox"/> Propane Gas <input type="checkbox"/>
	Sprinkler system: N/A <input type="checkbox"/> Full _____ Partial _____ Other Suppression _____ # of Heads _____

Building Characteristics	Utilities
SF Dwelling <input checked="" type="checkbox"/> SF Townhouse <input type="checkbox"/>	Water Supply: _____ Public _____ Private <input checked="" type="checkbox"/>
1st floor: <u>46'</u> Depth <u>54'</u> Width <u>36'</u>	Sewage Disposal: _____ Public _____ Private <input checked="" type="checkbox"/>
2nd floor: " " " <u>Shape</u>	Electric Yes <input checked="" type="checkbox"/> No <input type="checkbox"/>
Basement: " " " _____	Gas Yes <input type="checkbox"/> No <input checked="" type="checkbox"/>
Finished Basement <input type="checkbox"/> Unfinished Basement <input checked="" type="checkbox"/>	Heating System: _____ Electric <input type="checkbox"/> Oil <input type="checkbox"/>
Crawl space <input type="checkbox"/> Slab on Grade <input type="checkbox"/>	Natural Gas <input type="checkbox"/>
No. of Bedrooms <u>4</u>	Propane Gas <input checked="" type="checkbox"/>
Height: <u>35'</u>	Sprinkler system: N/A <input checked="" type="checkbox"/>
Multi-family dwellings: _____	NFPA #13D _____
No. of efficiency units: _____	NFPA #13R _____
No. of 1 BR units: _____	Other: _____
No. of 2 BR units: _____	
No. of 3 BR units: _____	
Other Structure: _____	
Dimensions: _____	
Footings: _____	
Roof Height: _____	
State Certified Modular _____	
Manufactured Home _____	

THE UNDERSIGNED HEREBY CERTIFIES AND AGREES AS FOLLOWS: (1) THAT HE/SHE IS AUTHORIZED TO MAKE THIS APPLICATION; (2) THAT THE INFORMATION IS CORRECT; (3) THAT HE/SHE WILL COMPLY WITH ALL REGULATIONS OF HOWARD COUNTY WHICH ARE APPLICABLE THERETO; (4) THAT HE/SHE WILL PERFORM NO WORK ON THE ABOVE REFERENCED PROPERTY NOT SPECIFICALLY DESCRIBED IN THIS APPLICATION; (5) THAT HE/SHE GRANTS COUNTY OFFICIALS THE RIGHT TO ENTER ON TO THIS PROPERTY FOR THE PURPOSE OF INSPECTING THE WORK PERMITTED AND POSTING NOTICES.

Helen Judd
Applicant's Signature
Title/Company _____

HELEN JUDD
Print Name
4-23-07 4/23/07
Date

Checks payable to: **DIRECTOR OF FINANCE OF HOWARD COUNTY**
** PLEASE WRITE NEATLY AND LEGIBLY. **

AGENCY	DATE	SIGNATURE APPROVAL	DPZ SETBACK INFORMATION	PROPERTY ID#:
<input checked="" type="checkbox"/> Land Development, DPZ			Front: _____	Filing fee \$ <u>100.00</u>
<input checked="" type="checkbox"/> State Highways			Rear: _____	Permit fee \$ _____
<input checked="" type="checkbox"/> Building Official			Side: _____	Excise tax \$ _____
<input checked="" type="checkbox"/> Dev. Engineering, DPZ			Side St.: _____	Add'l per. fee \$ _____
<input checked="" type="checkbox"/> Health		<u>Chlor Gabriel</u>	All minimum setbacks met?	TOTAL FEES \$ _____
<input checked="" type="checkbox"/> Fire Protection		<u>updated 7-19-11</u>	YES <input type="checkbox"/> NO <input type="checkbox"/>	Sub-total paid \$ _____
Is Sediment Control approval required prior to issuance?			is Entrance Permit required?	Balance due \$ _____
YES <input checked="" type="checkbox"/> NO <input type="checkbox"/>			YES <input type="checkbox"/> NO <input type="checkbox"/>	Check # <u>2004</u>
CONTINGENCY CONSTRUCTION START: <input type="checkbox"/>			Historic District?	Validation # _____
ONE STOP SHOP: <input type="checkbox"/>			YES <input type="checkbox"/> NO <input type="checkbox"/>	
Distribution of Copies: _____	White: Building Official	Green: LDD, DPZ	Lot Coverage for NewTown Zone _____	Accepted by <u>g</u>
T:\forms\PERMIT.FRM			SDP/Red-line approval date _____	Yellow: DED, DPZ
				Pink: Health
				Gold: SHA

14680 Dorsey Mill Rd.
Glenwood, MD 21738
November 7, 2011

*Changes does not
effect BP status.
Dana
11-5-11*

Avis L. Corbin, Chief
Licenses and Permits Division
3430 Courthouse Dr.
Ellicott City, MD 21043

Dear Mrs. Corbin,

We are submitting an amendment to permit #B07001417 to include the following:

- Front porch
- Below grade door to basement for maintenance access (under front porch)
- Relocating stairway between 2nd floor and 3rd floor
- 3rd floor bath rough-in

Thank you. Our check for \$50 is enclosed.

Sincerely,

Helen Judd

Helen Judd

*Health Dept
appear to be adding (IBR)*

CC: Heather

RECEIVED

NOV 07 2011

LICENSES & PERMITS
DIVISION

14680 Dorsey Mill Rd.
Glenwood, MD 21738
July 8, 2011

*RA 23 21 25 24 22
28 27 30 31*

*In Accela + B Log
as revision under
B07001417*

Avis L. Corbin, Chief
Licenses and Permits Division
3430 Courthouse Dr.
Ellicott City, MD 21043

Dear Mrs. Corbin,

We are submitting an amendment to permit # B07001417 to now include the garage.

Thank you very much. Our check for \$50 is enclosed.

Sincerely,

Helen Judd

Helen Judd

*CC: zoning
DED
HEALTH*


*updated
approved revision
B07001417
7-19-11*

RECEIVED


JUL 8 2011

LICENSES & PERMITS
DIVISION

- LEGEND**
- CONTOUR INTERVAL
 - EXISTING CONTOUR
 - PROPOSED CONTOUR
 - DIRECTION OF DRAINAGE
 - WALK OUT BASEMENT
 - SPOT ELEVATION
 - STABILIZED CONSTRUCTION ENTRANCE
 - EROSION CONTROL MATTING
 - SILT FENCE
 - LIMIT OF DISTURBED AREA
 - TREE PROTECTION FENCE
 - EXISTING TREES TO REMAIN
 - DRY WELL

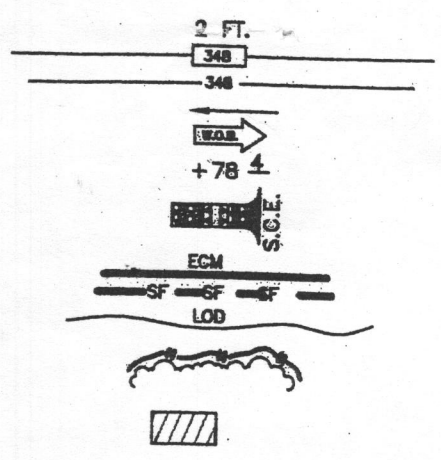

Date: 11/8/11
 Comments: BOJ201117
REVISED

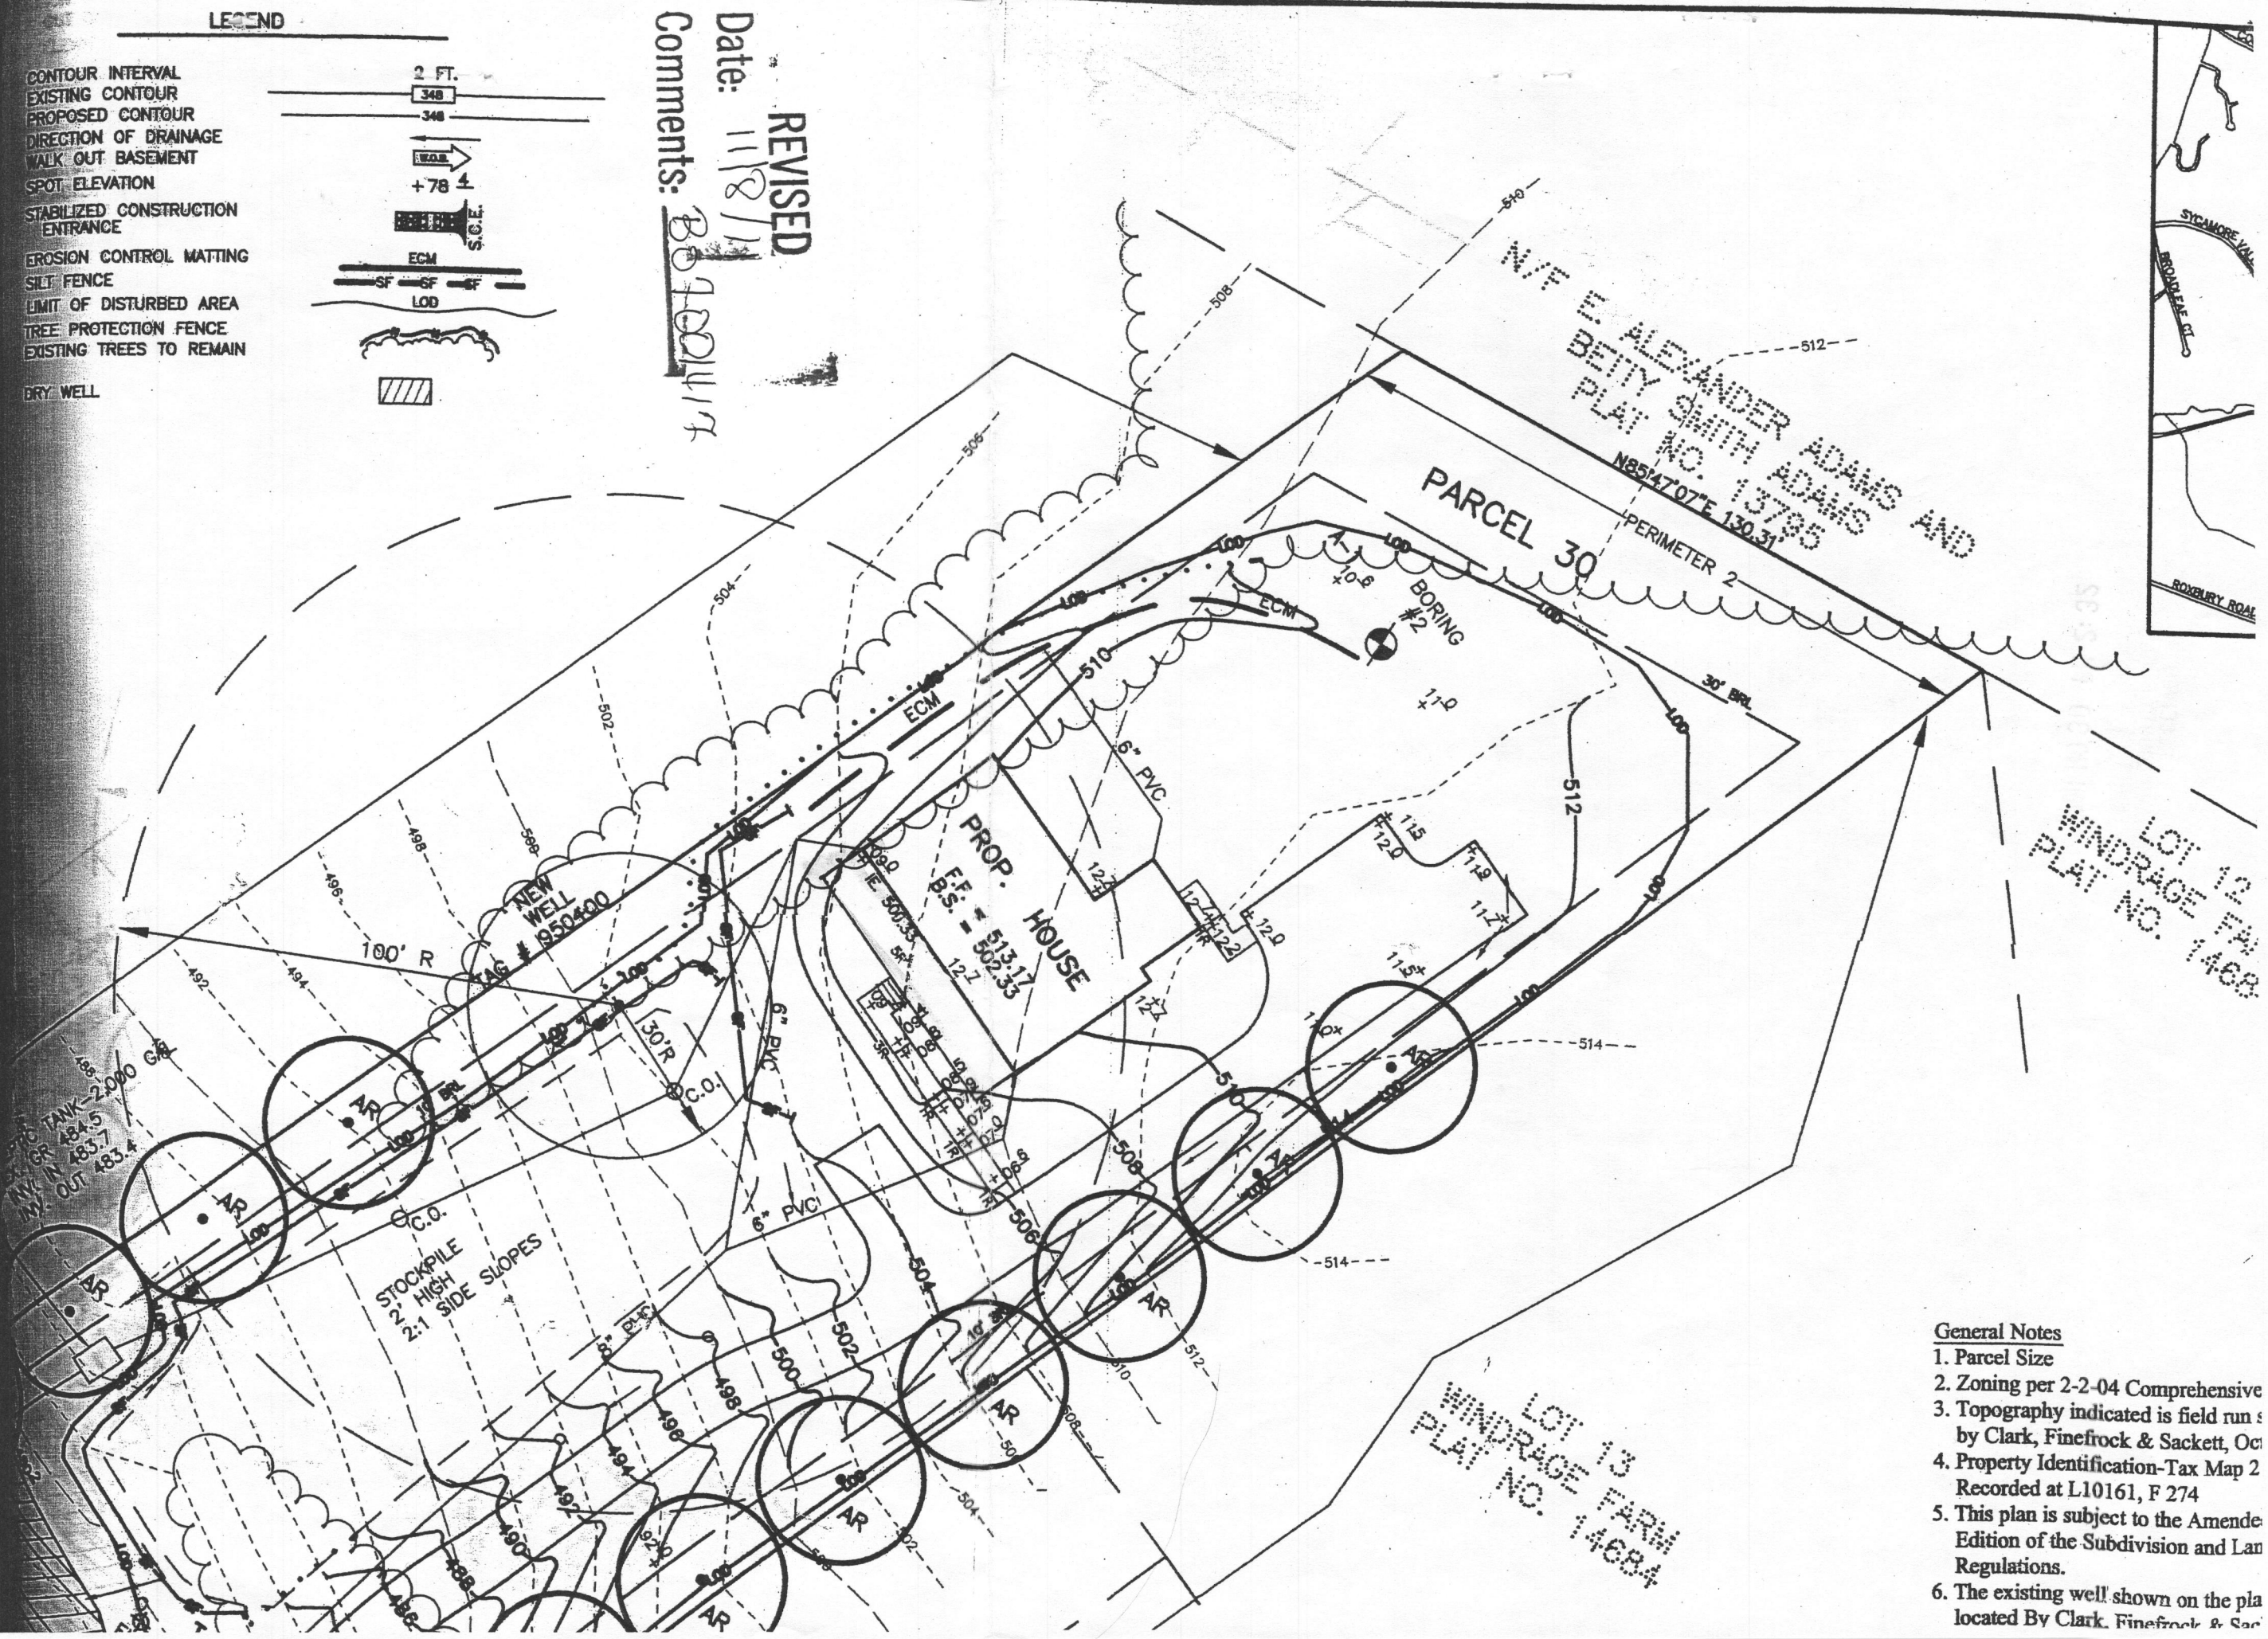

- General Notes**
1. Parcel Size
 2. Zoning per 2-2-04 Comprehensive
 3. Topography indicated is field run s by Clark, Finefrock & Sackett, Oc
 4. Property Identification-Tax Map 2 Recorded at L10161, F 274
 5. This plan is subject to the Amende Edition of the Subdivision and Lan Regulations.
 6. The existing well shown on the pla located By Clark, Finefrock & Sac