

Approved
P-Plan
1/25/08



A/P 5152

Brown L 2'

Red/Orange heavy Sol 4 1/2'

Brown per Yellow SL 10'

Yellow/Brown SL w/ trace Rock 12'

5151

Brown/Black L 1'

Red/Brown Sol 3 1/2'


Yellow/Orange SL w/ trace Rock 13'

5153

Brown L 1'

Orange/Brown Sol 3'

Yellow/Brown SL w/ trace Rock 12'

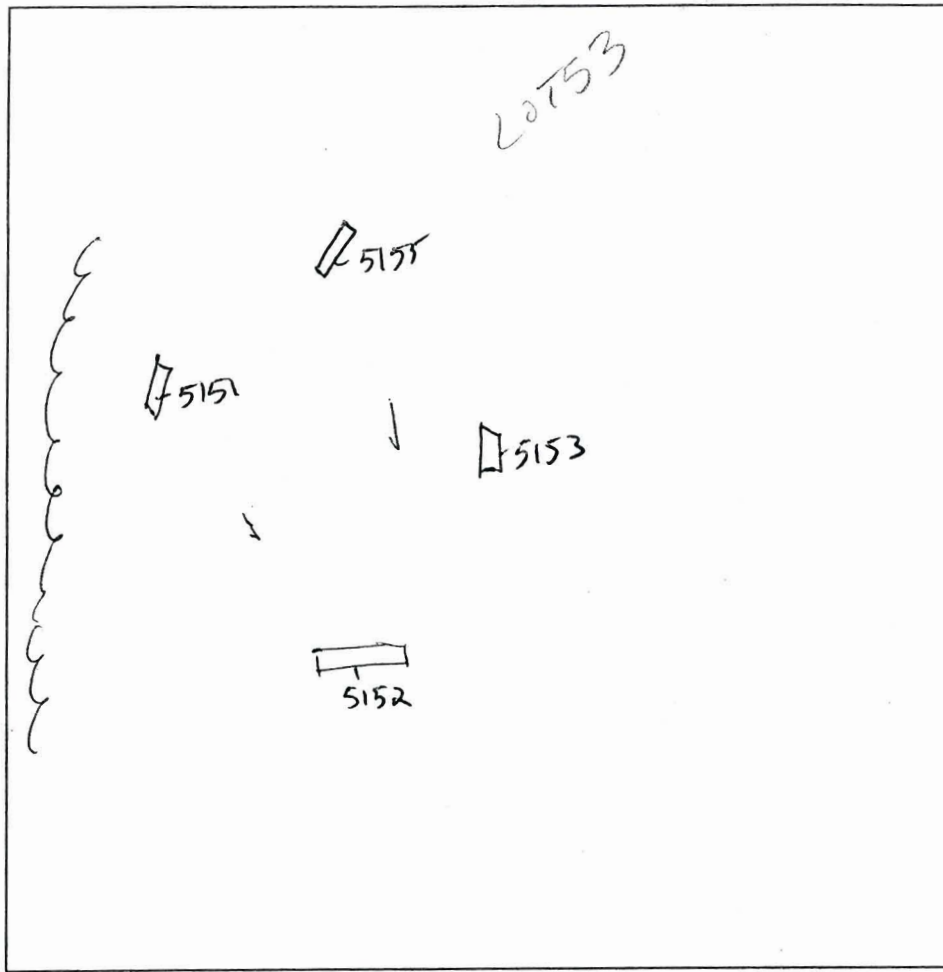

5155

Brown L 1'

Red/Orange Sol 3'

Yellow/Brown SL w/ trace Rock 13'

DATE	TEST #	DEPTH	START	BREAK 1" DROP	STOP 2" DROP	TIME OF 2nd INCH	P/F/H
9/16/05	5152	5' / 12'	11:29	11:31	11:35	4min	P
	5151	4' / 13'	11:38	11:41	11:46	5min	P
	5153	- / 12'	- Visual -			ok	P
	5155	3 1/2' / 13'	11:55	11:58	12:02	4min	P


REMARKS lot 68 lot 53

SANITARIAN _____ BACKHOE _____ OTHERS _____

TEST HOLES USED IN SDA _____ AVG. PERC TIME _____ SQ. FT/BR _____

TRENCH WIDTH _____ INLET DEPTH _____ MAX. BOT DEPTH _____ EFFECTIVE SW _____

AP 5157
 Brown L 1'
 Orange/Brown near Sol 2'
 Gray mottling D-3 4 1/2'

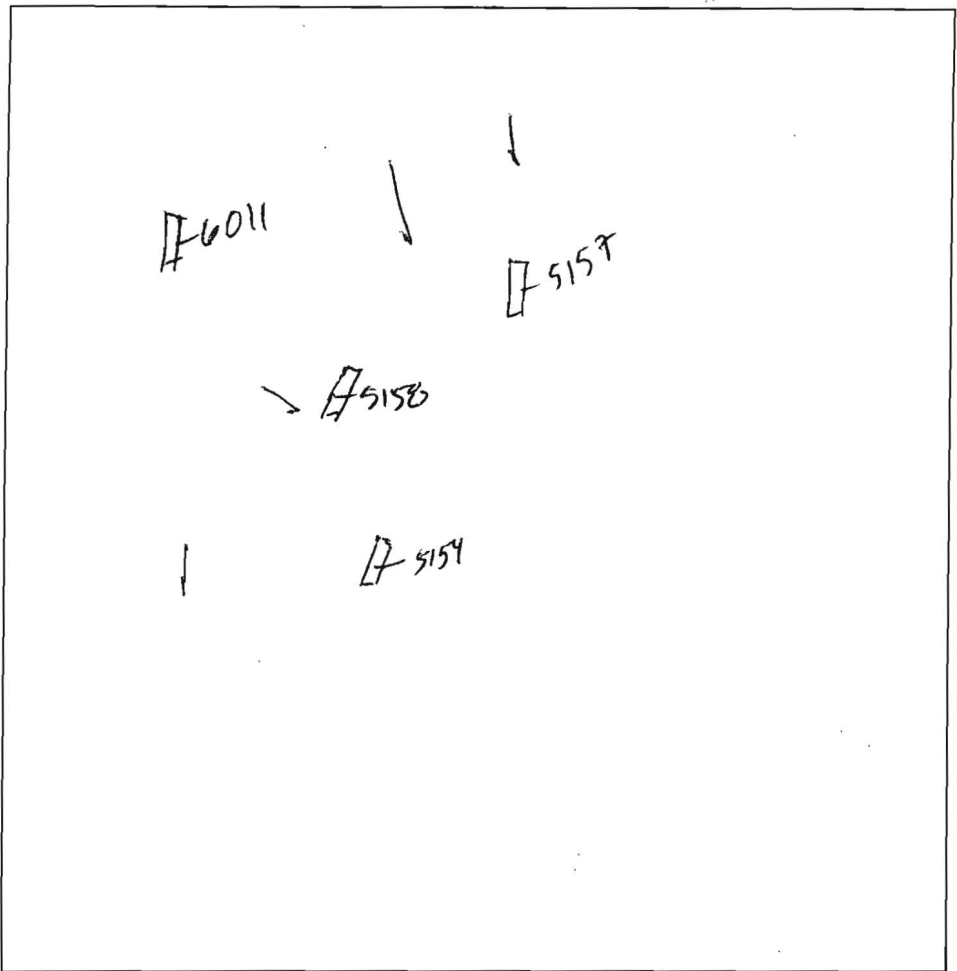

6011
 Brown L 1'
 Red/orange micas Sol 3 1/2'
 Yellow/Brown Sol of trace Rock 12'

5154
 Brown L 1'
 Brown/Red Orange w/ spots Sol cherty area
 Yellow/Brown micas Sol 10'
 Yellow/Brown Sol of trace Rock 12'

5158
 Brown L 2'
 Orange/Brown Sol 3'
 Yellow/Brown Sol of trace Rock 4 1/2'

DATE	TEST #	DEPTH	START	BREAK 1" DROP	STOP 2" DROP	TIME OF 2nd INCH	P/F/H
9/16/05	5157	4 1/2'	- Visual			Deep Cling mottling	F
	5154	3 1/2' / 12'	11.16	11.19	11.25	6min	P
	5158	14'	- Visual			OK	P
	6011	4 / 12'	12.57	12.53	12.56	3mw	P

REMARKS ~~lot 65~~ 54
 SANITARIAN py BACKHOE _____ OTHERS _____
 TEST HOLES USED IN SDA _____ AVG. PERC TIME _____ SQ. FT/BR _____
 TRENCH WIDTH _____ INLET DEPTH _____ MAX. BOT DEPTH _____ EFFECTIVE SW _____