

C1 5308

SEQUENCE NO. (MDE USE ONLY)

STATE OF MARYLAND WELL COMPLETION REPORT

THIS REPORT MUST BE SUBMITTED WITHIN 45 DAYS AFTER WELL IS COMPLETED.

1 2 3 8 (THIS NUMBER IS TO BE PUNCHED IN COLS. 3-6 ON ALL CARDS)

FILL IN THIS FORM COMPLETELY PLEASE TYPE

COUNTY NUMBER

ST/GO USE ONLY DATE RECEIVED MM DD YY 01 13 11

DATE WELL COMPLETED MM DD YY 06 06 11

Depth of Well 320 (TO NEAREST FOOT)

9/26/2011 O.K. BB

PERMIT NO. FROM "PERMIT TO DRILL WELL" HO-95-2010

OWNER Dibert STREET OR RFD 2300 Ericole Court TOWN Ellicott City

WELL LOG table with columns: DESCRIPTION, FEET (FROM, TO), check if water bearing. Includes entries for Dirt, Hard Gray, Med hard gray, Hard Gray, and Borehole #2.

GROUTING RECORD form including WELL HAS BEEN GROUTED, TYPE OF GROUTING MATERIAL (CEMENT, BENTONITE CLAY), NO. OF BAGS, NO. OF POUNDS, GALLONS OF WATER, DEPTH OF GROUT SEAL.

CASING RECORD form including MAIN CASING TYPE, Nominal diameter, Total depth, OTHER CASING (if used).

SCREEN RECORD form including screen type or open hole, insert appropriate code below (STEEL, BRASS, HO, PL, OT).

DEPTH (nearest ft.) table with columns for casing and screen diameters and depths.

PUMPING TEST form including HOURS PUMPED, PUMPING RATE, METHOD USED TO MEASURE PUMPING RATE, WATER LEVEL, TYPE OF PUMP USED.

PUMP INSTALLED form including DRILLER INSTALLED PUMP, IF DRILLER INSTALLS PUMP, TYPE OF PUMP INSTALLED, CAPACITY, PUMP HORSE POWER, PUMP COLUMN LENGTH, CASING HEIGHT.

LOCATION OF WELL ON LOT form including SHOW PERMANENT STRUCTURE, LANDMARKS AND INDICATE NOT LESS THAN TWO DISTANCES.

WELL HYDROFRACTURED form with YES/NO options.

CIRCLE APPROPRIATE LETTER form with options A, E, P.

I HEREBY CERTIFY THAT THIS WELL HAS BEEN CONSTRUCTED IN ACCORDANCE WITH COMAR 28.04.04 "WELL CONSTRUCTION" AND IN CONFORMANCE WITH ALL CONDITIONS STATED IN THE ABOVE CAPTIONED PERMIT...

DRILLERS LIC. NO. and SIGNATURE form for David Kelly and Jason Morrison.

SITE SUPERVISOR (sign. of driller or journeyman responsible for sitework if different from permittee)

GRAVEL PACK IF WELL DRILLED WAS FLOWING WELL INSERT F IN BOX 68.

MDE USE ONLY (NOT TO BE FILLED IN BY DRILLER) form with fields for TELESCOPE CASING, LOG INDICATOR, OTHER DATA.

B 1 6483

SEQUENCE NO. (MDE USE ONLY)

STATE OF MARYLAND APPLICATION FOR PERMIT TO DRILL WELL

STATE PERMIT NUMBER

HO-95-2090 fill in this form completely

534541 please type

Date Received (APA) 04 01 11

OWNER INFORMATION

8 MM DD YY 13
15 Last Name Owner First Name 34
Dibert Steve
36 Street or RFD 55
12300 Ericole Cr.
57 Town 70 State 72 Zip 76
Ellicott City MD 21042

B 3 LOCATION OF WELL


8 COUNTY 21
Howard
23 SUBDIVISION 42
Triadelphia Woods
SECTION 44 46 LOT 48 50
19
West Friendship
52 NEAREST TOWN 71
MILES FROM TOWN (enter 0 if in town) B 1 1/2
73 76 77 78

DRILLER INFORMATION

DAVID KELLY M W D 304
Driller's Name 76 License No. 81
Jones Well Drilling Inc
Firm Name
3700 Rush Rd. Jarrettsville MD 21084
Address
David Kelly 3-15-11
Signature Date

B 4

DIRECTION OF WELL FROM TOWN (CIRCLE BOX)

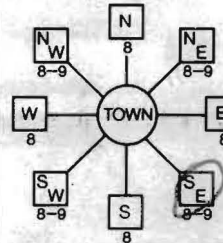

(12300) Ericole Cr.
11 NEAR WHAT ROAD 30
ON WHICH SIDE OF ROAD (CIRCLE APPROPRIATE BOX)
34 37
340 305 37
DISTANCE FROM ROAD FT 38 39
ENTER FT OR MI
TAX MAP: 22 BLK: 6 PARCEL 528

B 2 WELL INFORMATION

APPROX. PUMPING RATE 0
(GAL. PER MIN.) 8 12
AVERAGE DAILY QUANTITY NEEDED 0
(GAL. PER DAY) 14 20

USE FOR WATER (CIRCLE APPROPRIATE BOX)

- D DOMESTIC POTABLE SUPPLY & RESIDENTIAL IRRIGATION
F FARMING (LIVESTOCK WATERING & AGRICULTURAL IRRIGATION
I INDUSTRIAL, COMMERCIAL, DEWATERING
P PUBLIC WATER SUPPLY WELL
T TEST, OBSERVATION, MONITORING
G GEO-THERMAL 2 holes closed loop

NOT TO BE FILLED IN BY DRILLER HEALTH DEPARTMENT APPROVAL

Howard 13 A34581
COUNTY NAME COUNTY NO.
STATE SIGNATURE INSERT S 41
DATE ISSUED 4/14/2011 Brown Baker 4/14/2012
43 MM DD YY 48 CO SIGNATURE EXP. DATE
NORTH GRID 528 0 0 0 EAST GRID 817 0 0 0
50 55 57 63

APPROXIMATE DEPTH OF WELL 320 FEET

APPROXIMATE DIAMETER OF WELL 6 INCH

METHOD OF DRILLING (circle one)

BORED (or Augered) JETTED Jetted & DRIVEN
AIR-ROTary AIR-PERCussion ROTARY (Hydraulic Rotary)
CABLE REVERSE-ROTary Drive-POINT
other

REPLACEMENT OR DEEPEMED WELLS (CIRCLE APPROPRIATE BOX)

- N THIS WELL WILL NOT REPLACE AN EXISTING WELL
Y THIS WELL WILL REPLACE A WELL THAT WILL BE ABANDONED AND SEALED
S THIS WELL WILL REPLACE A WELL THAT WILL BE USED AS A STANDBY-CONTACT LOCAL APPROVING AUTHORITY FOR POLICY ON STANDBY WELLS
D THIS WELL WILL DEEPEMED AN EXISTING WELL

PERMIT NUMBER OF WELL TO BE REPLACED OR DEEPEMED (IF AVAILABLE) 41

Not to be filled in by driller (MDE OR COUNTY USE ONLY)

APPROX. PERMIT NUMBER G

PERMIT No. HO-95-2090

SHOW MAJOR FEATURES OF BOX & LOCATE WELL WITH AN X


SOURCES OF DRILLING WATER

- 1.
2.
3.

WRITE THE BOX NUMBER FROM THE MAP HERE

E 76° 57' 00"
N 39° 16' 30"

DRAW A SKETCH BELOW SHOWING LOCATION OF WELL IN RELATION TO NEARBY TOWNS AND ROADS AND GIVE DISTANCE FROM WELL TO NEAREST ROAD JUNCTION

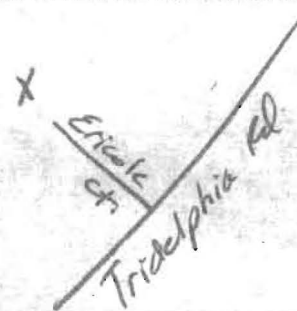


SPECIAL CONDITIONS

NOTE - APPROVING AUTHORITIES SHOULD USE SEPARATE SHEET IF NEEDED

Be Wary of Possible Damage to House Foundation

Site Visit move wells to the correct position

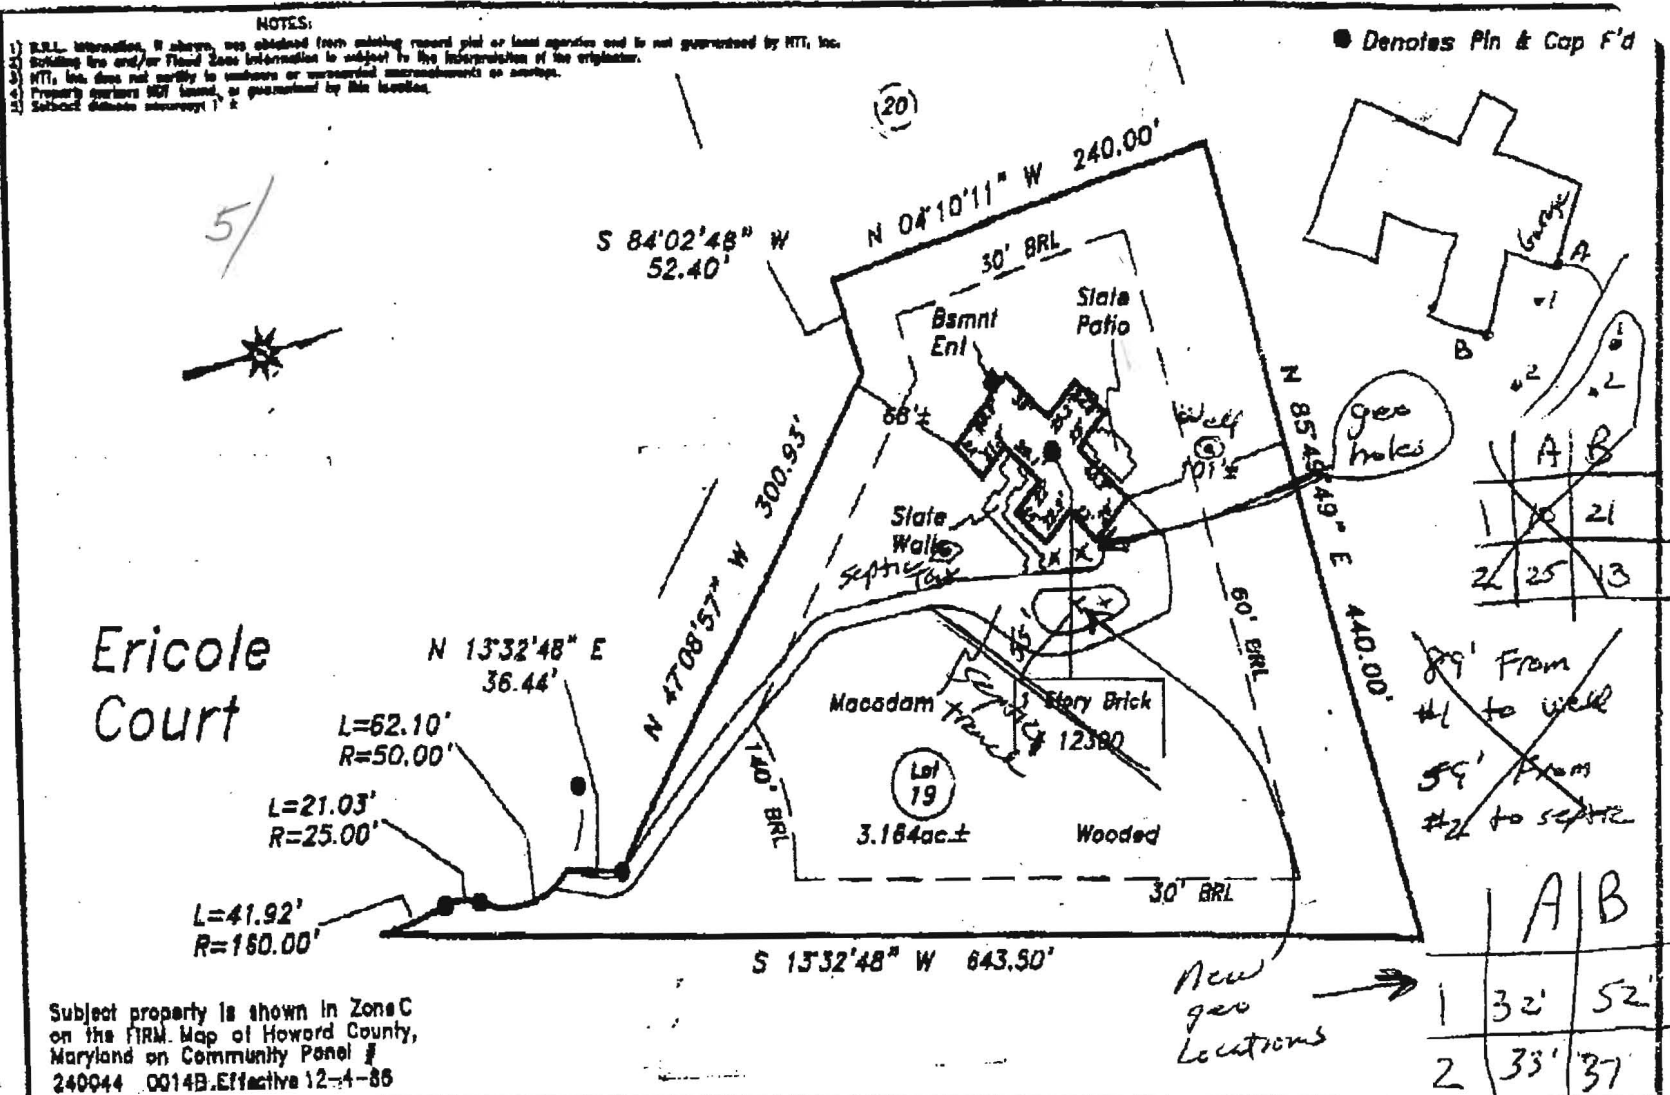

This is to certify that I have surveyed the property shown hereon, being known as Lot 19, TRIADELPHIA WOODS and recorded among the land records of Howard County, Maryland in Plat 6728 folio for the purpose of locating the improvements thereon.



LOCATION DRAWING
 12300 Ericole Court
 Howard County, Maryland
 Election District No. 03

NTT Associates, Inc.
 16205 Old Frederick Road
 Mt. Airy, Maryland 21771
 Ph. (410)442-2031
 Fax No. (410)442-1315

Scale: 1"=100'
 Date: 2-14-05
 Field By: Don
 Drawn By: Don
 Drawing # 05071400

This plat is of benefit to the consumer only insofar as it is required by a lender or a title insurance company or its agent in connection with contemplated transfer, financing, or refinancing purposes. This plat is not to be relied upon for the establishment of location of fences, garages, buildings, or other existing or future structures. This plat does not provide for the accurate identification of property boundary lines, but such identification may not be required for the transfer of title or for securing financing or refinancing.

11:44AM LOVES HEATING & AIR 14105512157

Page 2

180°49'49" E

440.00'

LOT 19

3.164 AC.±

EL. 4267.8
EXISTING WELL

BUILDING RESTRICTION LINE

5/2/2011
New
Borehole
Locations
BB

PROPOSED
DWELLING

FENCE

SILT

LI 47°00'51" W

LI 72


LI 84°26'41" E


LI 43°50'

LI 300.93'

LI 140' E

LI 32°48' E
LI 30.44'

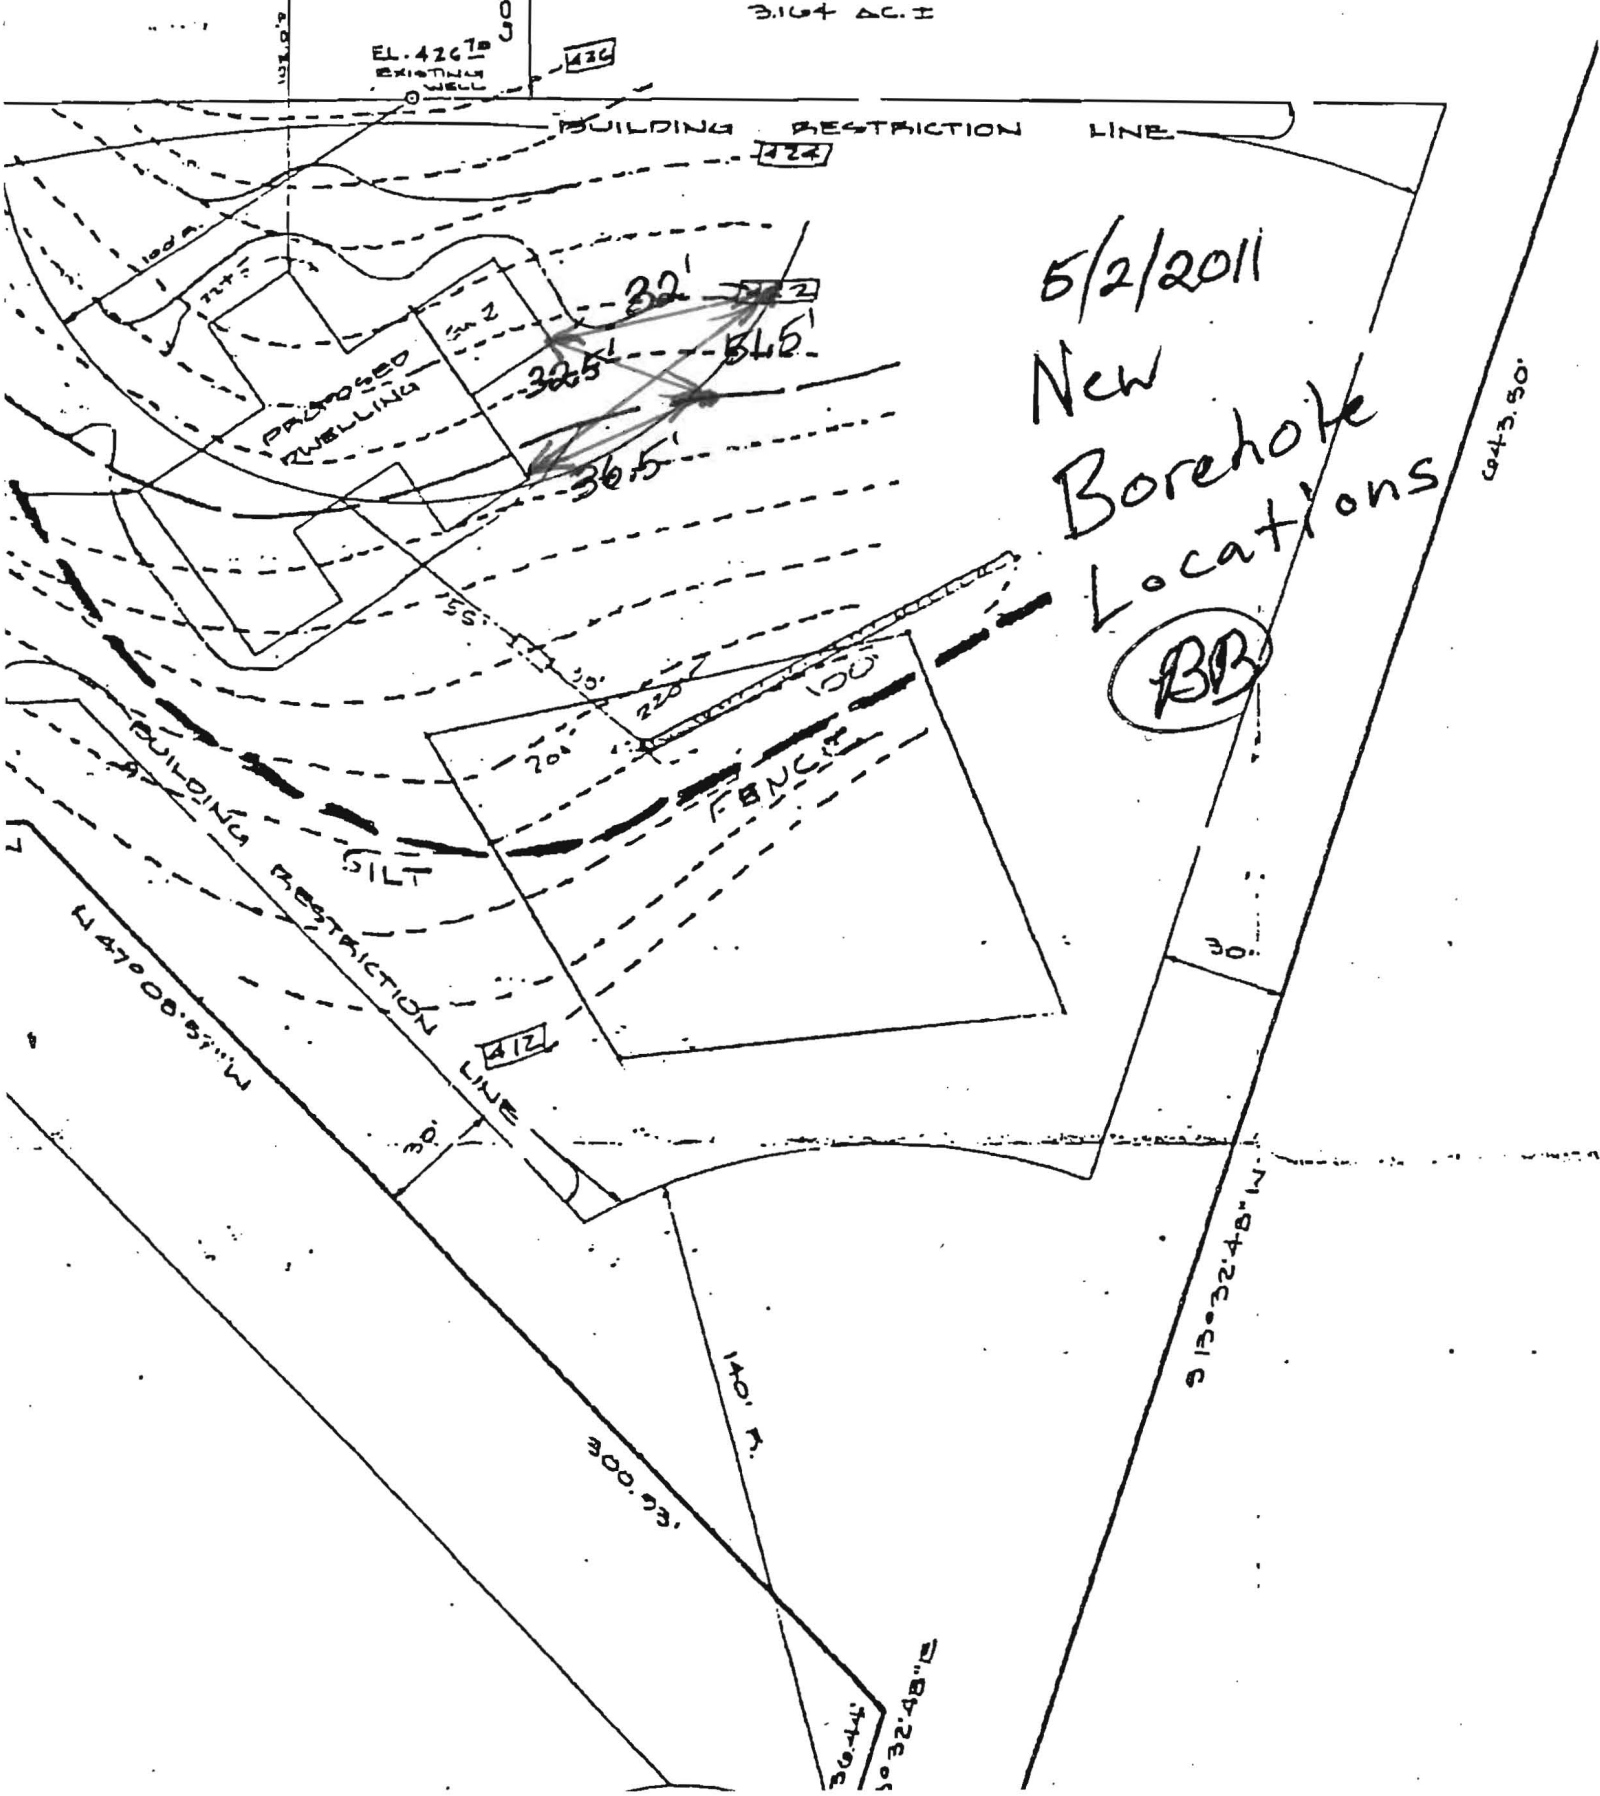

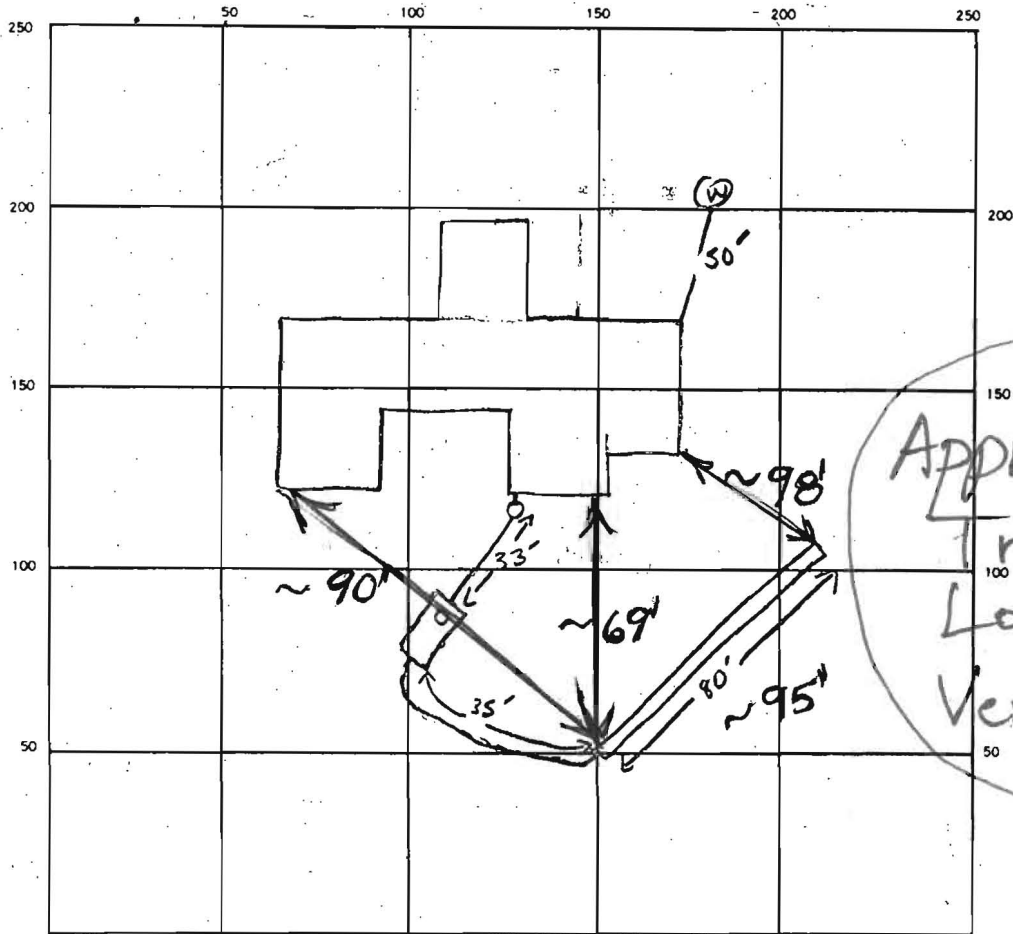

INDICATE NORTH. — NAME ADJOINING ROADWAY AS BASE LINE.

ERICOLE COURT

SEPTIC TANK LEVEL ✓ 1000 GRA CLEANOUTS AT HOUSE ✓ JT ✓

DISTRIBUTION BOX LEVEL N/A

DRAIN TILE FIELD DEPTH 9 FT. TRENCH WIDTH 2 FT. INLET DEPTH 3 FT.

EFFECTIVE GRAVEL DEPTH 6 FT. TOTAL LENGTH 80' FT.

NUMBER OF TRENCHES 1 ONE SIDEWALL / BOTTOM AREA 480 SQ. FT.

DRYWELL INSIDE DIAMETER — FT. EFFECTIVE DEPTH BELOW INLET — FT.

ABSORBENT AREA 480 SQ. FT.

REMARKS 12-17-87 OK TO START TRENCH. SA

DATE SYSTEM APPROVED 12-17-87 INSPECTOR S. Abel