



# APPLICATION

## FOR PERCOLATION TESTING AND SITE EVALUATION

TEST DATE(S) \_\_\_\_\_ TEST TIME \_\_\_\_\_ A/P 522420

AGENCY REVIEW: \_\_\_\_\_ DATE 4/25/05

DO NOT WRITE ABOVE THIS LINE

I HEREBY APPLY FOR THE NECESSARY TESTING/EVALUATION PRIOR TO ISSUANCE OF SEWAGE DISPOSAL SYSTEM PERMIT(S) TO:

CHECK AS NEEDED:

- CONSTRUCT NEW SEPTIC SYSTEM(S)
- REPAIR/ADD TO AN EXISTING SEPTIC SYSTEM
- REPLACE AN EXISTING SEPTIC SYSTEM

CHECK AS NEEDED:

- NEW STRUCTURE(S)
- ADDITION TO AN EXISTING STRUCTURE
- REPLACE AN EXISTING STRUCTURE

CHECK ONE:

- CREATE NEW LOT(S)
- BUILD ON AN EXISTING LOT IN A SUBDIVISION
- BUILD ON AN EXISTING PARCEL OF RECORD

IS THE PROPERTY WITHIN 2500' OF ANY RESERVOIR?

- YES
- NO

THE TYPE OF STRUCTURE IS:

- RESIDENTIAL WITH 4025 PROPOSED BEDROOMS IN THE COMPLETED STRUCTURE (NOTE UNKNOWN IF APPROPRIATE)
- COMMERCIAL (PROVIDE DETAIL OF NUMBERS AND TYPES OF EMPLOYEES/CUSTOMERS ON ACCOMPANYING PLAN)
- INSTITUTIONAL/GOVERNMENT (PROVIDE DETAIL OF NUMBERS AND TYPES OF EMPLOYEES/USERS ON ACCOMPANYING PLAN)

PROPERTY OWNER(S) Mrs. & Mrs. DONALD W. HUECH

DAYTIME PHONE 410-987-4990 CELL \_\_\_\_\_ FAX \_\_\_\_\_

MAILING ADDRESS 457 OLD ORCHARD CIR/E MILLERSVILLE MD 21042  
STREET CITY/TOWN STATE ZIP

APPLICANT FISHER, COLLINS & CARTER, INC

DAYTIME PHONE 410-461-2255 CELL \_\_\_\_\_ FAX 410-750-3784

MAILING ADDRESS 10272 BALTIMORE NATIONAL PIKE ELLCOTT CITY MD 21042  
STREET CITY/TOWN STATE ZIP

APPLICANT'S ROLE: DEVELOPER BUILDER BUYER RELATIVE/FRIEND REALTOR CONSULTANT

PROPERTY LOCATION  
SUBDIVISION/PROPERTY NAME FULTON MANOR II LOT NO. 1

PROPERTY ADDRESS 12276 HALL SHOP ROAD HIGHLAND  
STREET TOWN/POST OFFICE

TAX MAP PAGE(S) 40 GRID C PARCEL(S) 205 PROPOSED LOT SIZE 55,757 SQFT


AS APPLICANT, I UNDERSTAND THE FOLLOWING: THE SYSTEM INSTALLED SUBSEQUENT TO THIS APPLICATION IS ACCEPTABLE ONLY UNTIL PUBLIC SEWERAGE IS AVAILABLE. THIS APPLICATION IS COMPLETE WHEN ALL APPLICABLE FEES AND A SUITABLE SITE PLAN HAVE BEEN RECEIVED. I ACCEPT THE RESPONSIBILITY FOR COMPLIANCE WITH ALL M.O.S.H.A. AND "MISS UTILITY" REQUIREMENTS. APPROVAL IS BASED UPON SATISFACTORY REVIEW OF A PERC CERTIFICATION PLAN.

TEST RESULTS WILL BE MAILED TO APPLICANT.

SIGNATURE OF APPLICANT

HOWARD COUNTY HEALTH DEPARTMENT, BUREAU OF ENVIRONMENTAL HEALTH, WELL AND SEPTIC PROGRAM  
3525-H ELLICOTT MILLS DRIVE, ELLICOTT CITY, MARYLAND 21043-4544 (410) 313-1771 FAX (410) 313-2648  
TDD (410) 313-2323 TOLL FREE 1-877-4MD-DHMH

2741  
brown  
yellow brown silt micaceous  
orange b-silt & heavy  
Rice Blm  
yellow brown silt  
silt/silt mic

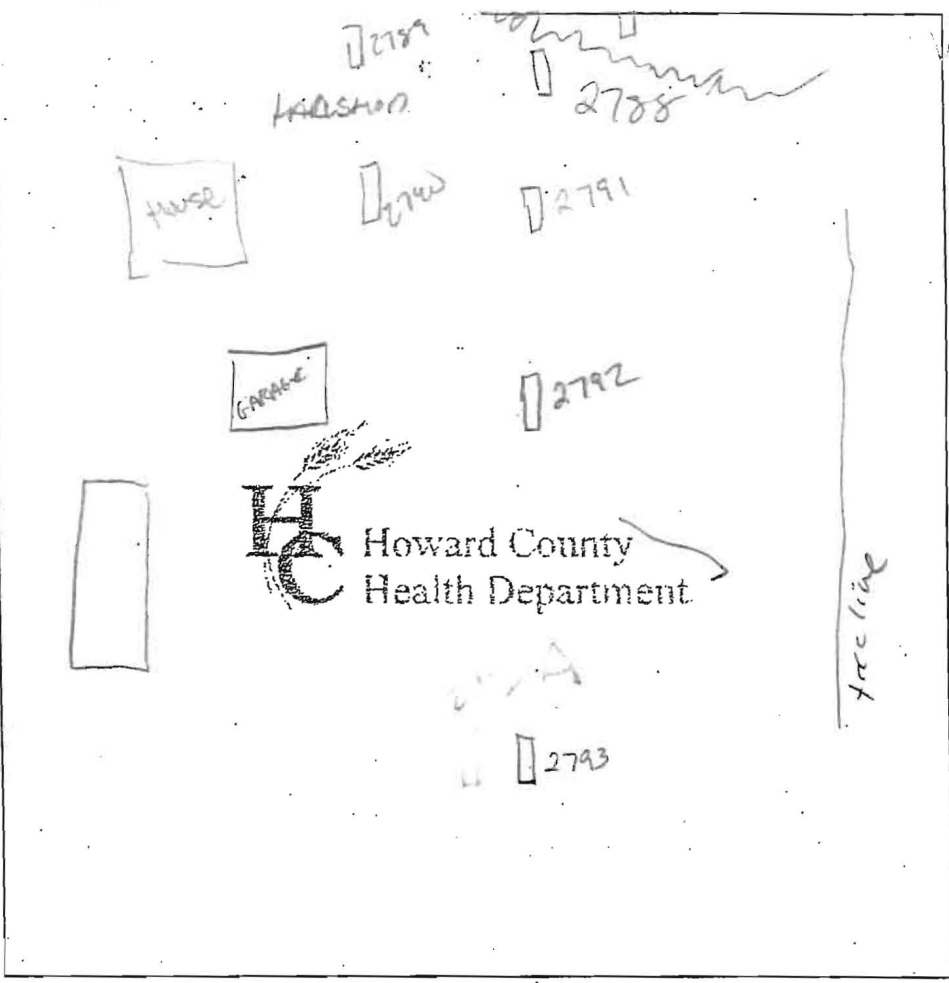

2787  
brown  
o-b-r silt ab  
o-b-r silt heavy to mid  
yellow brown silt  
15 <5% frags

2788  
brown  
red brown silt ab-micaceous  
r-b-o silt  
white-brown 15  
o-brown silt 5% cherty frags

2789  
brown  
r-o-b micaceous silt  
o-b-r silt  
o-b silt  
white st 15% quartz frags

2793 A  
brown  
5/4 10R weak red silt (ab) silt micaceous  
o-b-r silt heavy to light  
4/4 104R dark yellowish brown micaceous silt (fine)

2792  
brown fine  
weak red silt & silt  
4/4 104R dark yellowish brown fine silt  
micaceous  
flange gelsol  
silt <5% frags

DATE	TEST #	DEPTH	START	BREAK 1" DROP	STOP 2" DROP	TIME OF 2nd INCH	P/F/H
5/31/05	2793	6 / 13	9:44	9:50	9:59	9	P
✓	2792	6 / 13	9:37	9:39	9:42	2.5	P
✓	2791	8 / 13	9:30	Slow			F
✓	2789	6 / 13	9:59	10:20	10:46	26	P
✓	2788	7 / 13	10:14	10:23	10:31	8	P
✓	2790	6 / 13	12:08	12:10	12:12	2	P
✓	2792A	13	12:19	12:22	12:25	3	P

REMARKS - Perc #'s not on new plan! / Soils INCOS-STAIR.  
 SANITARIAN PAEY BACKHÖE K&K OTHERS \_\_\_\_\_  
 TEST HOLES USED IN SDA \_\_\_\_\_ AVG. PERC TIME \_\_\_\_\_ SQ.-FT/BR \_\_\_\_\_  
 TRENCH WIDTH \_\_\_\_\_ INLET DEPTH \_\_\_\_\_ MAX. BOT DEPTH \_\_\_\_\_ EFFECTIVE SW \_\_\_\_\_





# APPLICATION

## FOR PERCOLATION TESTING AND SITE EVALUATION

TEST DATE(S) \_\_\_\_\_ TEST TIME \_\_\_\_\_ A/P A519061

AGENCY REVIEW: \_\_\_\_\_ DATE 7/18/2003

DO NOT WRITE ABOVE THIS LINE

I HEREBY APPLY FOR THE NECESSARY TESTING/EVALUATION PRIOR TO ISSUANCE OF SEWAGE DISPOSAL SYSTEM PERMIT(S) TO:

CHECK AS NEEDED:

- CONSTRUCT NEW SEPTIC SYSTEM(S)
- REPAIR/ADD TO AN EXISTING SEPTIC SYSTEM
- REPLACE AN EXISTING SEPTIC SYSTEM

CHECK AS NEEDED:

- NEW STRUCTURE(S)
- ADDITION TO AN EXISTING STRUCTURE
- REPLACE AN EXISTING STRUCTURE

CHECK ONE:

- CREATE NEW LOT(S)
- BUILD ON AN EXISTING LOT IN A SUBDIVISION
- BUILD ON AN EXISTING PARCEL OF RECORD

IS THE PROPERTY WITHIN 2500' OF ANY RESERVOIR?

- YES
- NO

THE TYPE OF STRUCTURE IS:

- RESIDENTIAL WITH 4 PROPOSED BEDROOMS IN THE COMPLETED STRUCTURE (NOTE **UNKNOWN** IF APPROPRIATE)
- COMMERCIAL (PROVIDE DETAIL OF NUMBERS AND TYPES OF EMPLOYEES/ CUSTOMERS ON ACCOMPANYING PLAN)
- INSTITUTIONAL/GOVERNMENT (PROVIDE DETAIL OF NUMBERS AND TYPES OF EMPLOYEES/USERS ON ACCOMPANYING PLAN)

PROPERTY OWNER(S) OTHA UPCHURCH

DAYTIME PHONE \_\_\_\_\_ CELL \_\_\_\_\_ FAX \_\_\_\_\_

MAILING ADDRESS 457 OLD ORCHARD CIRCLE MILLERSVILLE MD. 21108  
STREET CITY/TOWN STATE ZIP

APPLICANT FISHER COLLINS AND CARTER

DAYTIME PHONE 410 461-2855 CELL \_\_\_\_\_ FAX 410 750 3784

MAILING ADDRESS 10272 BALTO NATIONAL PIKE ELLICOTT CITY MD. 21092  
STREET CITY/TOWN STATE ZIP

APPLICANT'S ROLE: DEVELOPER BUILDER BUYER RELATIVE/FRIEND REALTOR CONSULTANT

PROPERTY LOCATION  
SUBDIVISION/PROPERTY NAME FULTON MANOR II LOT NO. 1

PROPERTY ADDRESS PLEASANT VIEW DRIVE HIGHLAND  
STREET TOWN/POST OFFICE

TAX MAP PAGE(S) 40 GRID G PARCEL(S) p/o 205 PROPOSED LOT SIZE 3.0 AC

AS APPLICANT, I UNDERSTAND THE FOLLOWING: THE SYSTEM INSTALLED SUBSEQUENT TO THIS APPLICATION IS ACCEPTABLE ONLY UNTIL PUBLIC SEWERAGE IS AVAILABLE. THIS APPLICATION IS COMPLETE WHEN ALL APPLICABLE FEES AND A SUITABLE SITE PLAN HAVE BEEN RECEIVED. I ACCEPT THE RESPONSIBILITY FOR COMPLIANCE WITH ALL M.O.S.H.A. AND "MISS UTILITY" REQUIREMENTS. APPROVAL IS BASED UPON SATISFACTORY REVIEW OF A PERC CERTIFICATION PLAN. TEST RESULTS WILL BE MAILED TO APPLICANT.


SIGNATURE OF APPLICANT

HOWARD COUNTY HEALTH DEPARTMENT, BUREAU OF ENVIRONMENTAL HEALTH, WELL AND SEPTIC PROGRAM  
3525-H ELLICOTT MILLS DRIVE, ELLICOTT CITY, MARYLAND 21043-4544 (410) 313-1771 FAX (410) 313-2648  
TDD (410) 313-2323 TOLL FREE 1-877-4MD-DHMH

AVP  
 (4344)  
 Red Br Heavy Loam  
 4'-5'  
 Red Br Loam Scarce Rock  
 6'-7.5'  
 Beige Sa Loam  
 ~20% Saprolite  
 13.5'

(4343)  
 Red Br Heavy Loam ~10% Rock  
 5'-5.5'  
 Red Br Loam Scarce Rock  
 6.5'  
 Or Br Si Loam  
 ~10% Saprolite  
 Wet Near Bottom  
 3.5'

(4342)  
 Red Br Heavy Loam  
 4'-5'  
 Wet Or Br Si Loam Scarce Rock  
 11'  
 Caving  
 12'  
 Water Seepage Water  
 13'

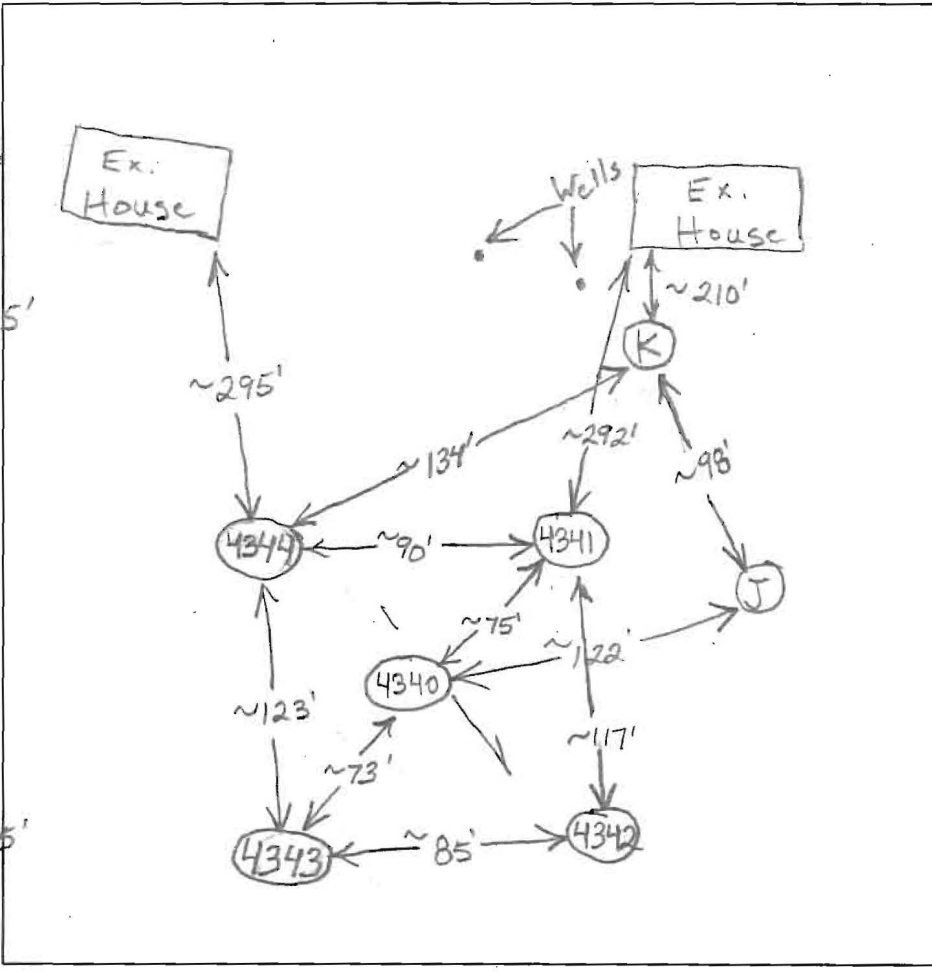

(4340)  
 Red Br Heavy Loam and Loam ~10% Rock  
 6.5'  
 Red Br Si Loam Turning To an Or Br Sa Loam  
 ~15% Saprolite  
 14'

(4341) (J)  
 Red Br Heavy Loam  
 5.5'  
 Light Br Sa Loam  
 ~25% Saprolite

(K)  
 Red Br Heavy Loam ~10% Rock  
 6'  
 Or Br Si Loam Scarce Rock  
 7.5'  
 Beige Sa Loam  
 ~20% Saprolite  
 14'

DATE	TEST #	DEPTH	START	BREAK 1" DROP	STOP 2" DROP	TIME OF 2nd INCH	P/F/H
9/17/03	4344	7' / 13.5' V	10:54	11:00	11:00	11:09:30	9 1/2 O.K.
	4343	7' 4" / 13.5' V	11:04:30	11:10:30	11:10:30	11:18	7 1/2 W.S.
		5' 11"	11:24	~ 1/8" in 15 Minutes			Slow
	4342	5' 9" / 13' V	11:28:30	~ 7/8" in 25 minutes			Slow (F)
	4340	6' 9" / 14' V	12:04	12:09	12:09	12:17	8 O.K.
	4341	7' / 14.5' V	11:51:30	11:55	11:55	12:00:30	5 1/2 O.K.
	J	6' 10" / 13.5' V	2:22	2:22:30	2:22:30	2:23:30	1 1/2 Total
		Repour 12" x 12"	2:32:20	2:33:55	2:33:55	2:35:50	~2 O.K.
	K	6.5' / 14' V	2:42:30	2:47	2:47	2:54:30	7 1/2 O.K.

REMARKS: Hole K is ~160' From The Well For The Existing House  
 SANITARIAN: B. Baker BACKHOE: K+K OTHERS:  
 TEST HOLES USED IN SDA: \_\_\_\_\_ AVG. PERC TIME: \_\_\_\_\_ SQ. FT/BR: \_\_\_\_\_  
 TRENCH WIDTH: \_\_\_\_\_ INLET DEPTH: \_\_\_\_\_ MAX. BOT DEPTH: \_\_\_\_\_ EFFECTIVE SW: \_\_\_\_\_