



CORYS COURT

ROXBURY RD
(SCENIC ROAD)
(LOCAL ROAD)

LOT 17
46 S.F.

LOT 1
58,229 S.F.

LOT 2
45,334 S.F.

LOT 16
47,221 S.F.

LOT 11
47,761 S.F.

LOT 10
45,254 S.F.

LOT 9
44,812 S.F.

LOT 15
49,697 S.F.

LOT 8
40,487 S.F.

LOT 14
51,471 S.F.

LOT 12
59,661 S.F.

LOT 13
51,632 S.F.

PARCEL 58
PARCEL A
DALE E. HAYETT JR AND
JOSEPHINE H. ZIMMERMAN I/C
39-11-654
PLAT NO. 14554
ZONED: RC-DEC

PARCEL 61
TODD G. PAYUK, TRUSTEE
56803690
ZONED: RC-DEC

Approved perc cert
3/26/07

COUNTY #

SOIL PROFILE


53
 Dr. Brown
 Loam 8"
 Brown
 Silty
 Loam 5'
 Red
 Brown
 Fine
 Silty
 Loam 12'
 12'

56

Str. brn
 CLLm
 sbk 2'
 rd
 Hbrn
 brn
 SL 4 1/2'
 5'
 majenta
 org
 tan
 fine
 S
 wk saprolite
 ~100% 13 1/2'

58A

MASSIVE STRUCTURE
 Strong
 brn
 CLLm
 Dense
 Trace R_x 4 1/2-5'
 Str brn, org brn
 S CLLm
 Trace R_x 6-6 1/2'
 brn: org brn
 SLm
 Trace R_x 8'
 org single
 fine grain
 sand trace
 Bottom 13'

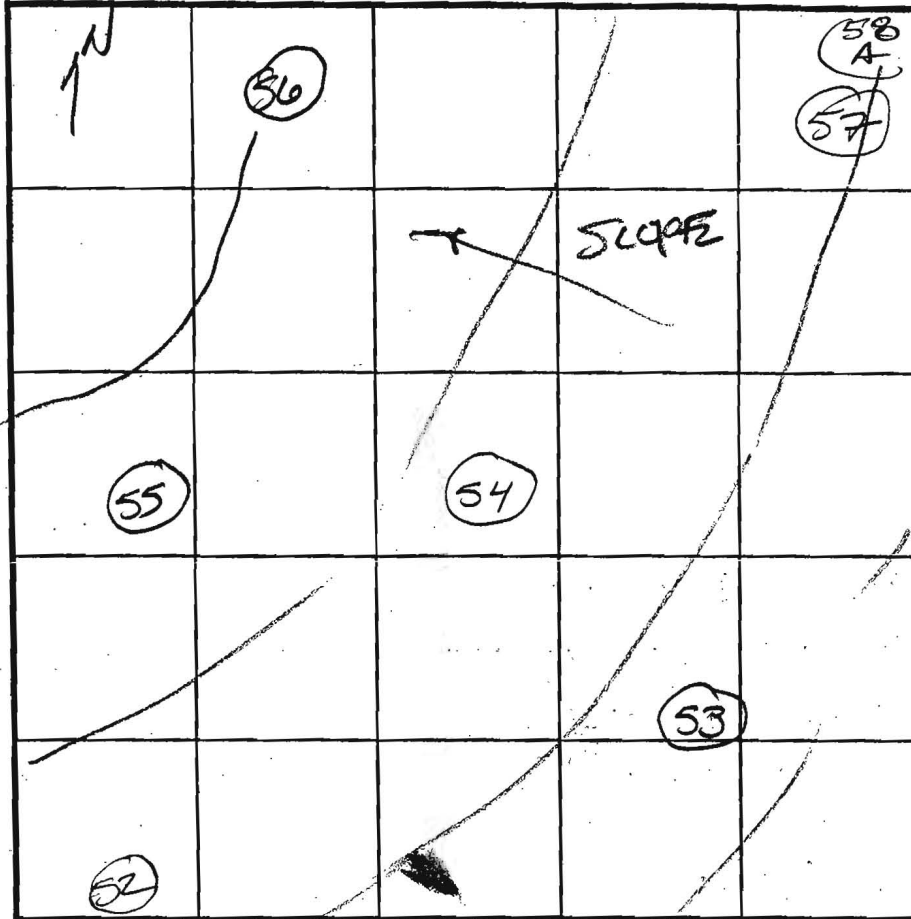

INDICATE NORTH - NAME ADJOINING ROADWAY AS BASE LINE.

SOIL PROFILE

55
 Strong
 brn
 Lm w/
 CL SKINS 1'
 Slim layer
 then
 silm 3'
 Densely
 packed
 rd brn
 yellow
 brn, tan
 Lm - 4 1/2'
 SLm
 Bottom 13 1/2'
 54
 Str brn
 CL Lm sbk
 SLm layer
 CLm layer + strong
 red 3 1/2'
 y brn, brn
 majenta
 Lm S-S
 fine
 wk sap ~10%
 Bottom 13 1/2'

DATE	TEST NO.	DEPTH	PRE-WET		TEST - 1" DROP		TIME
			START	STOP	START	STOP	
7/4/03	53	5 1/2' / 12'	2:20	2:23	2:23	2:28	5min P
7/10/03	56	5' S / 13 1/2' V	8:26 ⁰⁰	8:28 ³⁰	8:28 ³⁰	8:34 ⁰⁴	5 1/2 min P
	58A	6' S / 13' V	8:31	8:36	8:36	8:43	7min P
	55	5 1/2' S / 13 1/2' V	8:38	8:43	8:43	8:50	7min P
	54	6' / 13 1/2' V	8:40	8:49	8:49	8:53	4min P
7/9/03	57	8' / 13'	2:06	2:12	2:12	2:24	12min P

REMARKS 58A not per plan

TYPE OF SOIL

TESTED BY

FA

ALSO PRESENT

Rob Streetley
 Mark Johnson

TRENCH DESIGN DATA: AVERAGE PERCOLATION TIME

TRENCH WIDTH

INLET DEPTH

MAXIMUM BOTTOM DEPTH

SQ. FT/BEDROOM

LOT # 17

COUNTY #

SOIL PROFILE

0'

52

dk brown loam 1'

Red Si Cby loam 3'

Red Brown Si loam

L590 Rock

13'

SOIL PROFILE

0'

INDICATE NORTH - NAME ADJOINING ROADWAY AS BASE LINE.

DATE	TEST NO.	DEPTH	PRE-WET		TEST - 1" DROP		TIME
			START	STOP	START	STOP	
7/10/03	52	5 1/2' / 13	8:56	9:03	9:03	9:09	6 min

REMARKS _____

TYPE OF SOIL _____

TESTED BY FA ALSO PRESENT _____

TRENCH DESIGN DATA: AVERAGE PERCOLATION TIME _____ TRENCH WIDTH _____

INLET DEPTH _____ MAXIMUM BOTTOM DEPTH _____ SQ. FT./BEDROOM _____

Bob Sheekey
Mark Johnson