

COUNTY # _____
 SOIL PROFILE

①
 0' topsoil
 1' red org
 btm
 sa cl lm
 2.5'

②
 0' topsoil
 1' red brn
 sa cl lm
 3.5'


③
 0' topsoil
 1' red brn
 sa cl lm
 3.5'

④
 4' pale
 red brn
 sa lm
 13.5'

⑤
 0' topsoil
 1' red brn
 sa cl lm
 3.5'

⑥
 1' lt brn
 sa lm
 13.5'

⑦
 1' 20%
 scapr
 sh
 13.5'

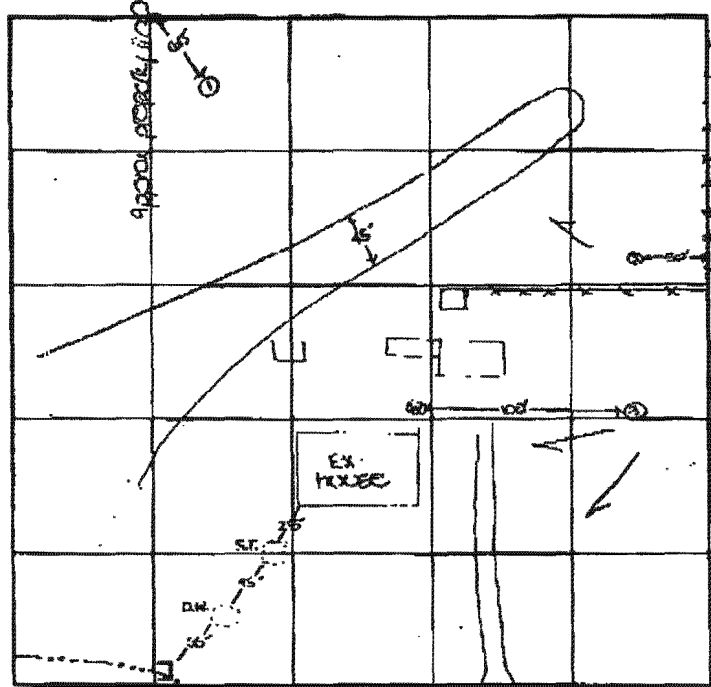

SOIL PROFILE

0'

INDICATE NORTH - NAME ADJOINING ROADWAY AS BASE LINE.
 Frederick Road

DATE	TEST NO.	DEPTH	PRE-WET		TEST - 1" DROP		TIME
			START	STOP	START	STOP	
1-7-00	1	4.0'S	10:41	10:42	10:42	10:44	2
		13.0'D	Visual	-see	profile		OK
	2	4.0'S	11:05a	11:15	11:15	11:30	15
		13.5'D	Visual	-see	profile		OK
	3	3.5'S	11:27	11:30	11:30	11:33	3
		13.5'D	Visual	-see	profile		OK

REMARKS _____

TYPE OF SOIL _____

TESTED BY DLS ALSO PRESENT owner, Fogle's

TRENCH DESIGN DATA: AVERAGE PERCOLATION TIME 60 TRENCH WIDTH 2

INLET DEPTH 3.5 MAXIMUM BOTTOM DEPTH 7.5 SQ. FT./BEDROOM 180