

DEPARTMENT OF INSPECTIONS, LICENSES AND PERMITS
 3430 COURT HOUSE DRIVE
 ELLICOTT CITY, MD 21043
 PERMITS (410)313-2455
 INSPECTIONS (410)313-1850

HOWARD COUNTY RESIDENTIAL HEATING-VENTILATION-AIR CONDITIONING AND REFRIGERATION PERMIT APPLICATION

HVACR PERMIT #
M10001009
 BUILDING PERMIT #
B10001506

BUILDING ADDRESS: 14182 DAY FARM RD.
GLENELEIGH, MD. 21737
SUBDIVISION:
CENSUS TRACT:
LOT:
BLOCK:
PROPERTY ID:
TYPE OF IMPROVEMENT:

SUITE/APT:
SECTION:
TAX MAP:
ZONE:
MAP COORDINATES:
USE:

OWNERS NAME: DAVE ACHESON
ADDRESS: 14182 DAY FARM RD.
CITY: GLENELEIGH
STATE: MD. **ZIP CODE:** 21737
HOME PHONE: **WORK PHONE:**

	<u>CHECK ONE</u>	<u>HOW MANY</u>	
SINGLE FAMILY DWELLING	<input checked="" type="checkbox"/>	<u>2</u>	ZONES
SINGLE FAMILY TOWNHOUSE	<input type="checkbox"/>	___	ZONES
MULTI-FAMILY / HOTEL/MOTEL	<input type="checkbox"/>	___	UNITS

COMPANY NAME: ROWAN HEATING + A/C
LICENSEE NAME: JAMES A ROWAN
ADDRESS: 12459 RT 216
CITY: HIGHLAND
STATE: MARYLAND **ZIP CODE:** 20777
PHONE: 301-604-2444 **HVACR LICENSE NO:** 2569

New
 Heating and Air Conditioning Heating System Only Other Work (Describe):
50. thermal
10/14/10
Replacement
 Heating
 Air Conditioning
 Heating and Air Conditioning
Additions and Alterations
 Heating
 Air Conditioning
 Heating and Air Conditioning
Approved
BB

Zones
 Permit Fee = # of Zones x \$40 = 80
 Technology Fee (10% of Permit Fee) = 8
 Plus Application Fee \$50
 Total Fees Due = 138

Units
 Permit Fee = # of Units x \$80 = _____
 Technology Fee (10% of Permit Fee) = _____
 Plus Application Fee \$50
 Total Fees Due = _____

HAVE CAREFULLY EXAMINED AND READ THIS APPLICATION AND KNOW IT IS TRUE AND CORRECT. THE WORK DESCRIBED HEREIN WILL BE PERFORMED BY A STATE HVACR LICENSED PERSON(S) INSURED TO CONTRACT WORK, AND ALL WORK WILL BE PERFORMED IN COMPLIANCE WITH APPLICABLE CODES AND STANDARDS OF HOWARD COUNTY AND THE STATE OF MARYLAND.

James A. Rowan 10/13/10
 SIGNATURE OF LICENSED CONTRACTOR DATE
James A Rowan 10/8/10

RINT NAME
Theresa A @ Rowan HVAC.com
 Make check payable to: DIRECTOR OF FINANCE OF HOWARD COUNTY
 \Chief\p\HVACR4.WPD REV 6/17/04


Validation

Check Number: 18165
 Cash: _____
 Receipt Number: 220628

10/12/10 M. Davis
Approved in
Accela

M10001009

ALLIED WELL DRILLING SITE PLAN

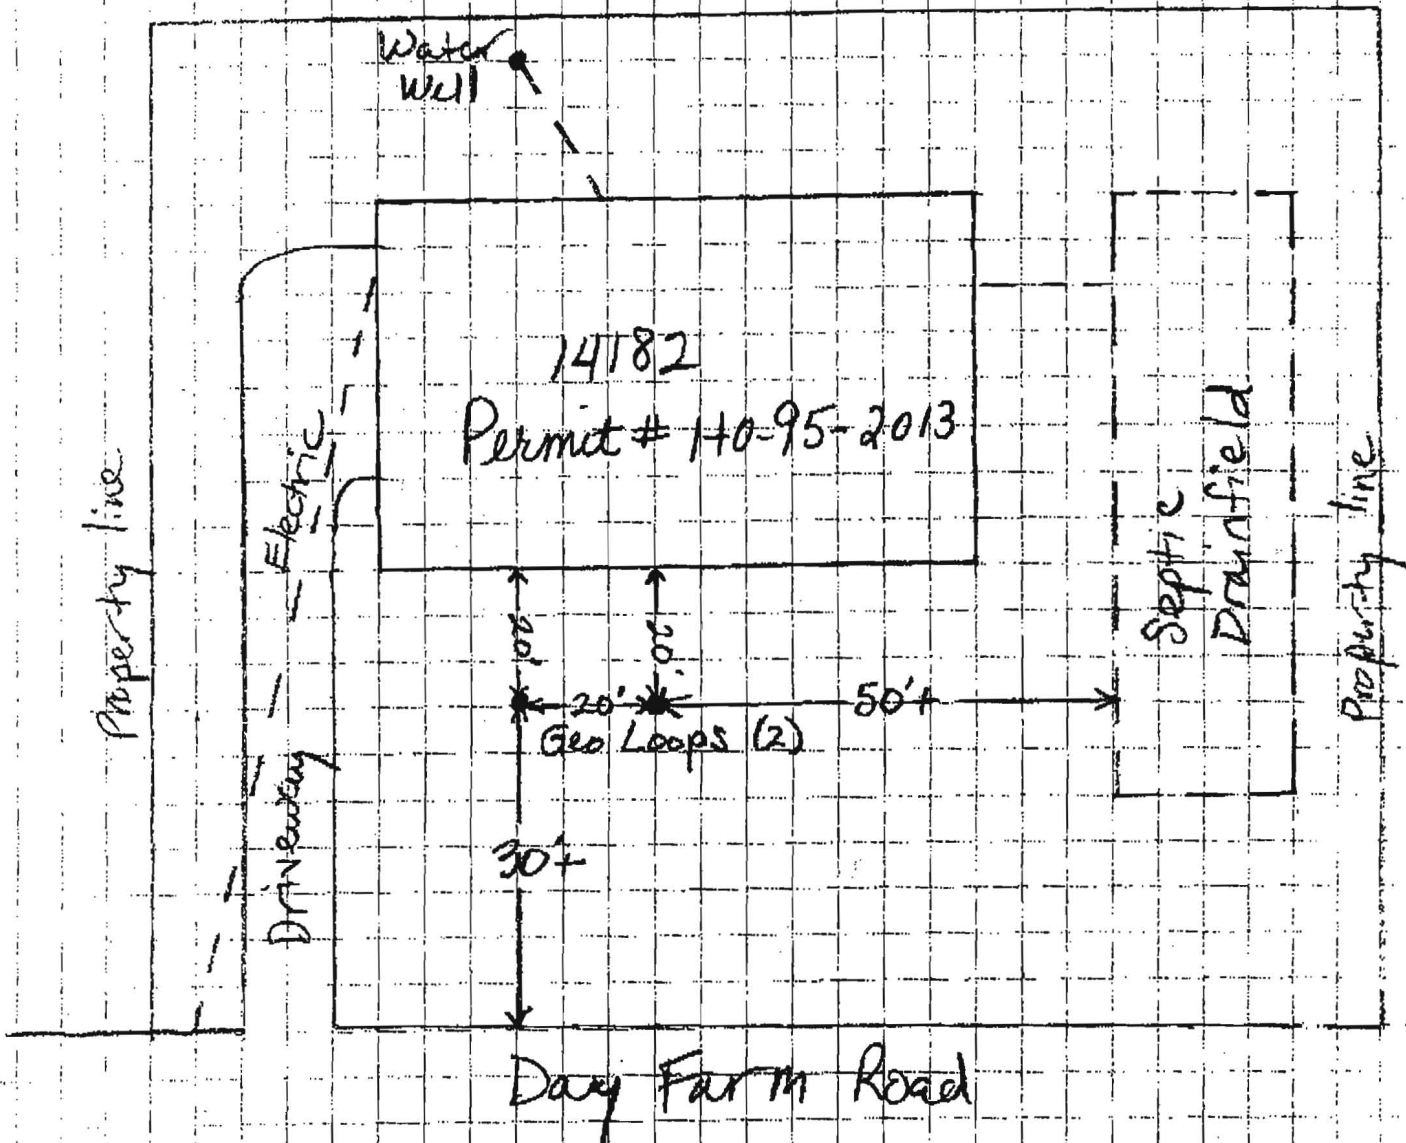

NEIGHBORING TAG #'S: _____

DISTANCE FROM HOUSE: 20'
 FROM SEPTIC: 50'+
 FROM SEWER: _____
 FROM PROPERTY LINE: 50'+
 FROM STREET: 30'+

TREES NEARBY: No
 UTILITY ISSUES: No
 MATS NECESSARY: No
 ACCESS FOR H/U: Yes - see Brea#

COMMENTS:

PERSON COMPLETING FORM: Andy T.