

LAYOUT 12/18/07 INSP 4 \_\_\_\_\_  
INSP 2 12/19/07 INSP 5 \_\_\_\_\_  
INSP 3 12/21/07 INSP 6 \_\_\_\_\_

ISSUE DATE: 11/28/07  
APPROVAL DATE: 5/8/08

# PERMIT

P 527927  
A \_\_\_\_\_

TAX ID #  
**ON-SITE SEWAGE DISPOSAL SYSTEM**  
**HOWARD COUNTY HEALTH DEPARTMENT**  
**BUREAU OF ENVIRONMENTAL HEALTH**

Fogles Septic Clean, Inc IS PERMITTED TO INSTALL  ALTER

ADDRESS: 580 Obrecht Road PHONE NUMBER: 401-795-5670

SUBDIVISION: Edgewood Farm LOT NUMBER: 10

ADDRESS: 14605 Cory's Court PROPERTY OWNER: Toll MD V LP

SEPTIC TANK CAPACITY (GALLONS): 2000 OUTLET BAFFLE FILTER REQUIRED

PUMP CHAMBER CAPACITY (GALLONS): \_\_\_\_\_ COMPARTMENTED TANK REQUIRED

NUMBER OF BEDROOMS: 5

SQUARE FEET PER BEDROOM: \_\_\_\_\_

LINEAR FEET OF TRENCH REQUIRED: 267

TRENCHES:	Trench to be 2.0 feet wide. Inlet 4.0 feet below original grade. Bottom maximum depth 8.0 feet below original grade. Effective area begins at 6.0 feet below original grade. 4.0 feet of stone below distribution pipe.
LOCATION:	
NOTES:	Install system per plan unless directed by HCHD. Layout inspection required prior to installation.

PLANS APPROVED: Sara Fegel DATE: 8/20/07

- NOTE: PERMIT VOID AFTER 2 YEARS
- NOTE: CONTRACTOR RESPONSIBLE FOR SCHEDULING A PRE-CONSTRUCTION INSPECTION FOR ALL INSTALLATIONS
- NOTE: WATERTIGHT SEPTIC TANKS REQUIRED
- NOTE: ALL PARTS OF SEPTIC SYSTEM SHALL BE 100 FEET FROM ANY WATER WELL
- NOTE: MANHOLE RISERS REQUIRED ON ALL SEPTIC TANKS AND PUMP CHAMBERS UNLESS SPECIFICALLY AUTHORIZED

**NEITHER THE HOWARD COUNTY COUNCIL NOR THE HEALTH DEPARTMENT IS RESPONSIBLE FOR THE SUCCESSFUL OPERATION OF ANY SYSTEM PERMITTEE RESPONSIBLE FOR OBTAINING FINAL APPROVAL ON THIS PERMIT CALL 410-313-1771 FOR INSPECTION OF SEPTIC SYSTEM**

NOT TO SCALE

\* See separate  
As - Built

11/11/08  
Need House  
Connection BB

ROAD

TRENCH/DRAINFIELD DATA		
WIDTH	INLET	BOTTOM
2'	4'	8.0'
NUMBER OF TRENCHES		3
TOTAL LENGTH		270'
ABSORPTION AREA		540'±SW
DISTRIBUTION BOX LEVEL		Level
DISTRIBUTION BOX BAFFLE		Yes
DISTRIBUTION BOX PORT		Yes

SEPTIC TANK DATA	
SEPTIC TANK 1 LEVEL	Yes
CAPACITY	2000 GAL
SEAM LOC	Top
TANK LID DEPTH	1.5'-2'
BAFFLES	Yes
BAFFLE FILTER	No
MANHOLE LOC	Front+Rear
6" PORT LOC	None
WATERTIGHT TEST	No
SEPTIC TANK 2 LEVEL	N/A
CAPACITY	_____ GAL
SEAM LOC	_____
TANK LID DEPTH	_____
BAFFLES	_____
BAFFLE FILTER	_____
MANHOLE LOC	_____
6" PORT LOC	_____
WATERTIGHT TEST	_____

PRE-CONSTRUCTION 12/18/07 Install a 70', 90' and 110' trench on contour across the top of the easement. Place the distribution box at the top easement corner that is closest to the house. BB

INSTALLATION 12/19/07 No work done. BB

12/21/07 Tank set, Distribution box set, Plumbing from tank to dist. box covered and tank covered. BB

12/26/07 middle trench dug and complete. OK to backfill and continue. KW

12/27/07 D box leveled w/ level. Last french almost finished. OK to cover when finished. KW

1/24/08 Need house connection. BB

FINAL INSPECTOR B. Baker

DATE OF APPROVAL 5/8/08

Cory's Ct.

H0-95-0767

82'

66'

Prop. Price

14605 Cory's Ct.

10

2.5'

8'

13'

5.5'

27.5'

11.5'

31.5'

61'

102'

43'

3'

36'

20'


80'


90'

100'

ROAD

NOT TO SCALE

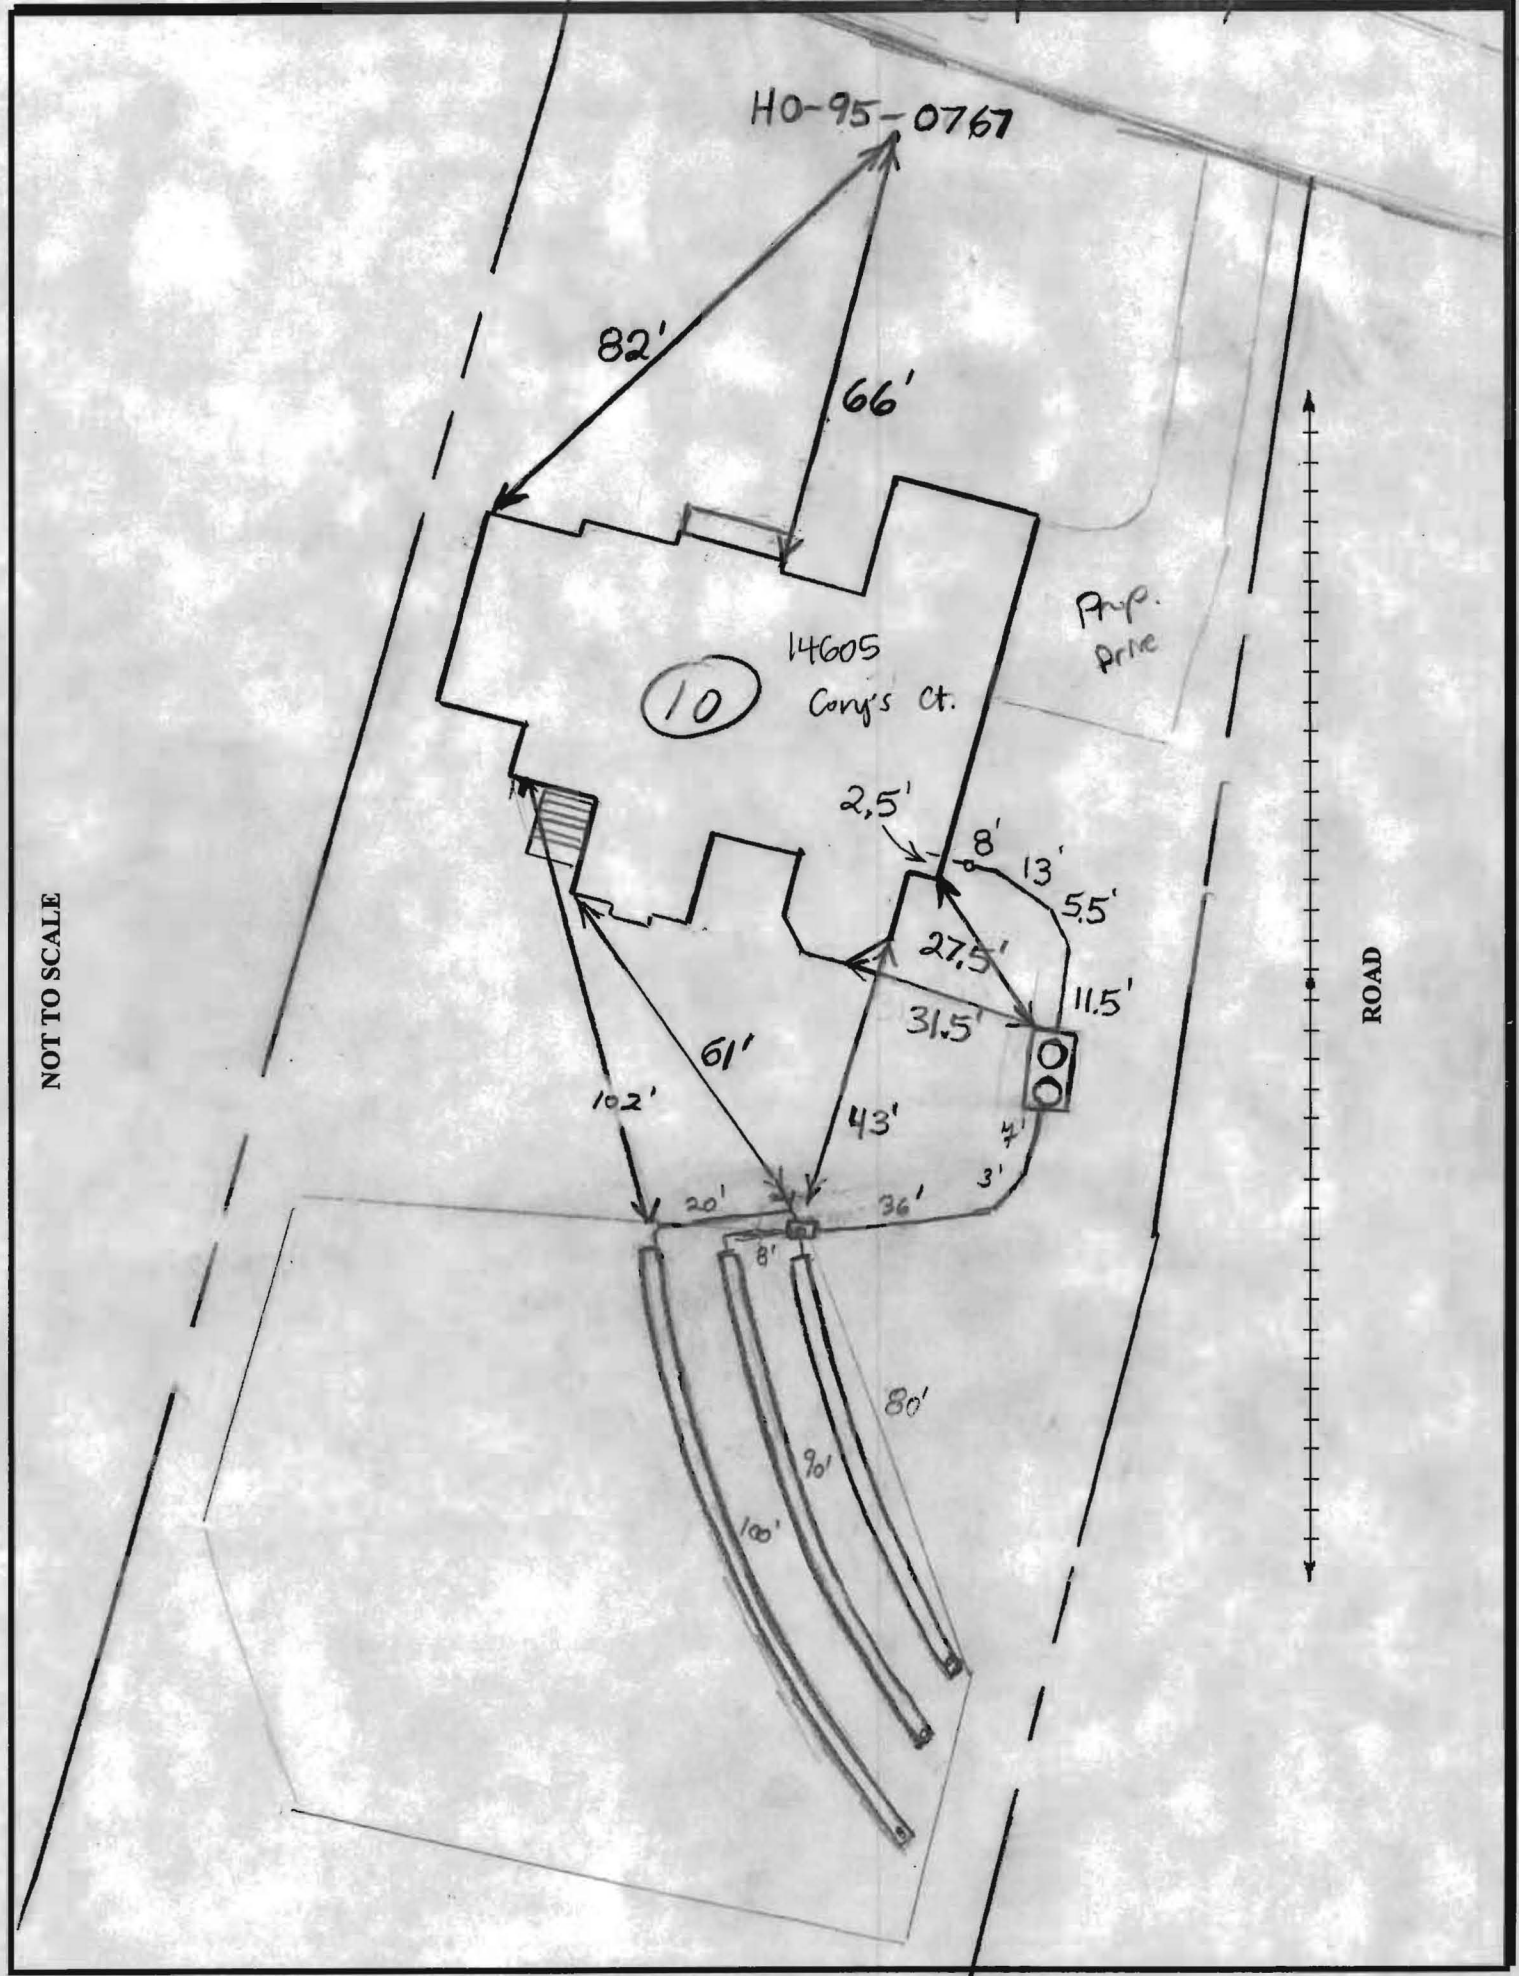

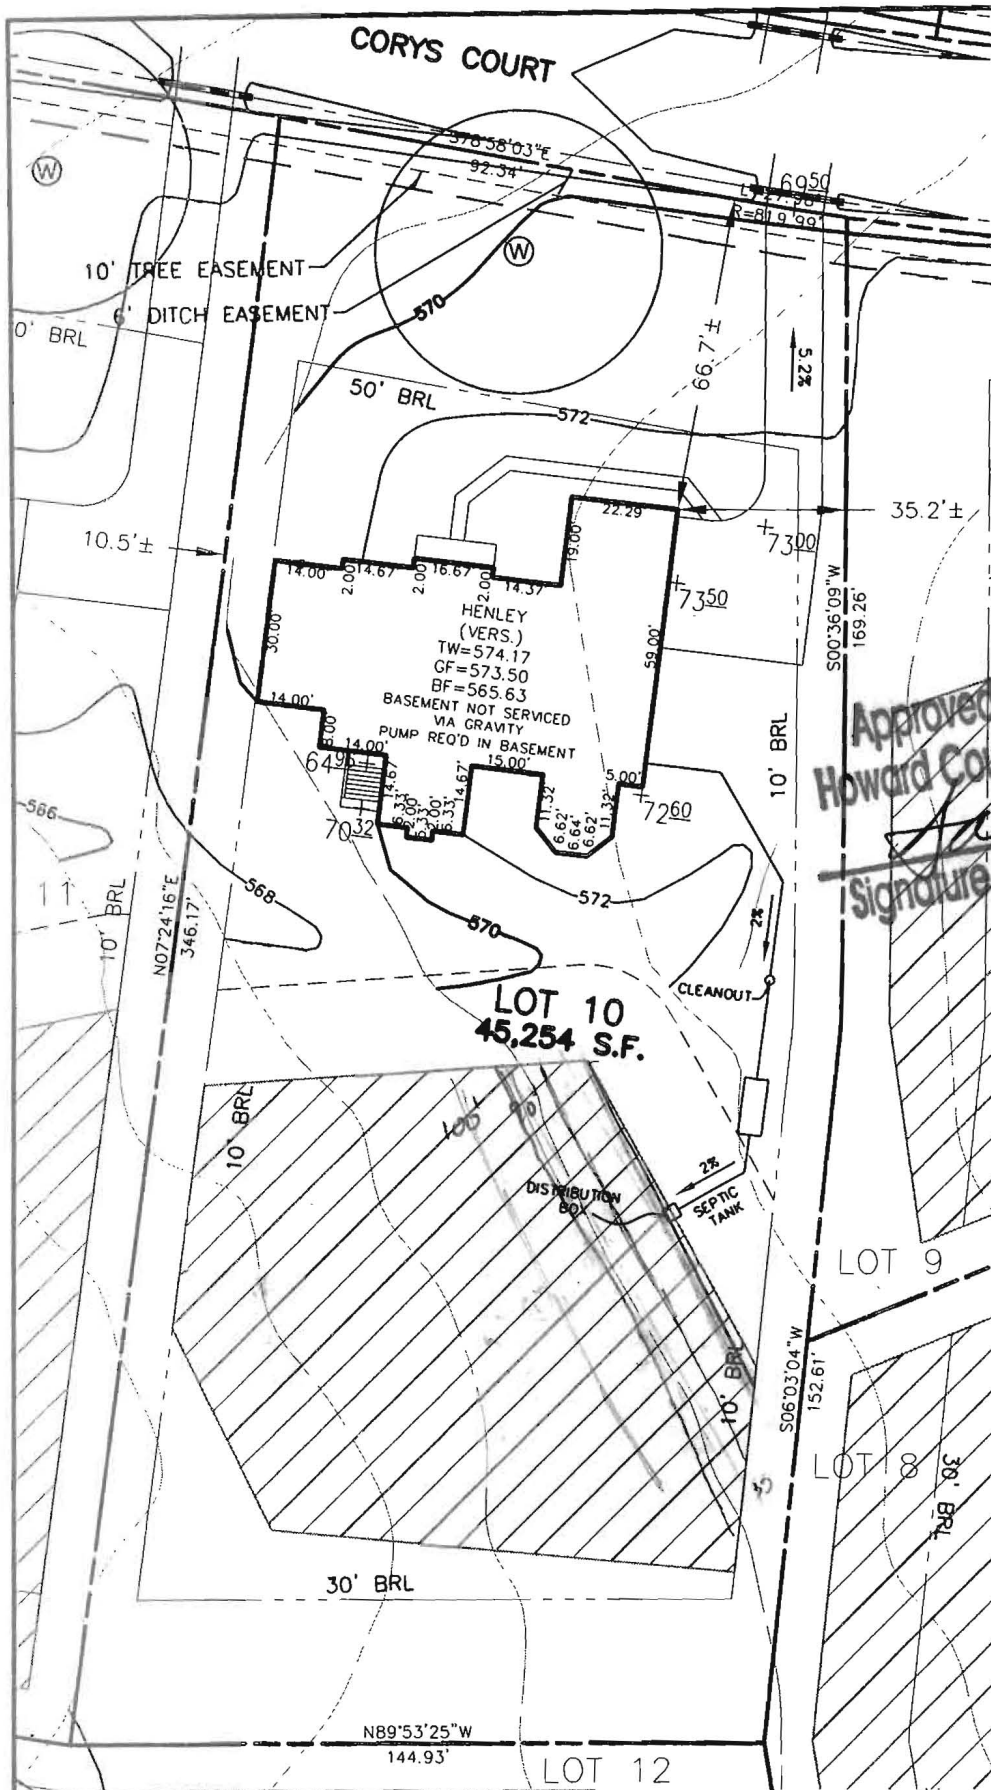

Approved Septic System Plan  
 Howard County Health Department  
 Signature: *[Signature]* Date: 8/20/07

75  
95  
100  
70  
90  
110

THE EXISTING WELL(S) SHOWN ON THIS PLAN (IDENTIFIED WITH THE ATTACHED WELLTAG NUMBER HO-95-0767) HAS BEEN FIELD LOCATED BY ESE CONSULTANTS- PROFESSIONAL LAND SURVEYOR(S), AND IS ACCURATELY SHOWN.

INV. @ HOUSE	569.8
GROUND @ INV. @ HOUSE	572.6
INV. IN TANK	568.1
INV. OUT TANK	567.8
TOP OF TANK	569.1
GROUND OVER TANK	572.1
INV. IN DIST. BOX	567.3
INV. OUT DIST. BOX	567.0
GROUND @ BOX	571.0

WELL No. HO-95-0767

ADDRESS: ??? CORYS COURT  
 GLENELG, MD 21737

BUILDING SETBACKS (B.R.L.'s) SHOWN HEREON PER SITE DEVELOPEMENT PLAN SETBACK DISTANCES SHOWN HEREON AS "±" HAVE AN ACCURACY OF ±0.1' FOOT.

TYPE: HENLEY (VERSAILLES)-  
 DAYLIGHT BASEMENT  
 ADD'L 1' TO HEIGHT OF BASEMENT  
 GUEST ELITE SUITE  
 NAPLES SUN ROOM ADDITION  
 SUPER EXPANDED FAMILY ROOM

OPTION No. 018  
 OPTION No. 070  
 OPTION No. 035  
 OPTION No. 529  
 OPTION No. 534

PLOT PLAN:  
 LOT #10  
**EDGEWOOD FARM**  
 LIBER 4174, FOLIO 0436  
 PLAT No. 19266  
 FOURTH ELECTION DISTRICT  
 HOWARD COUNTY, MARYLAND


ESE

Land Planning  
 Engineering  
 Land Surveying

ESE Consultants Inc.  
 7164 Columbia Gateway Dr.  
 Suite 203  
 Columbia, MD 21046  
 TEL: 410-872-9105  
 FAX: 410-872-4870

DATE: 08/21/07      SCALE: 1"=40'      FILE: LOT\_10  
 CHK'D: GVS      JOB#: 1498      DRAWN: GVS/CRC

# CORYS COURT

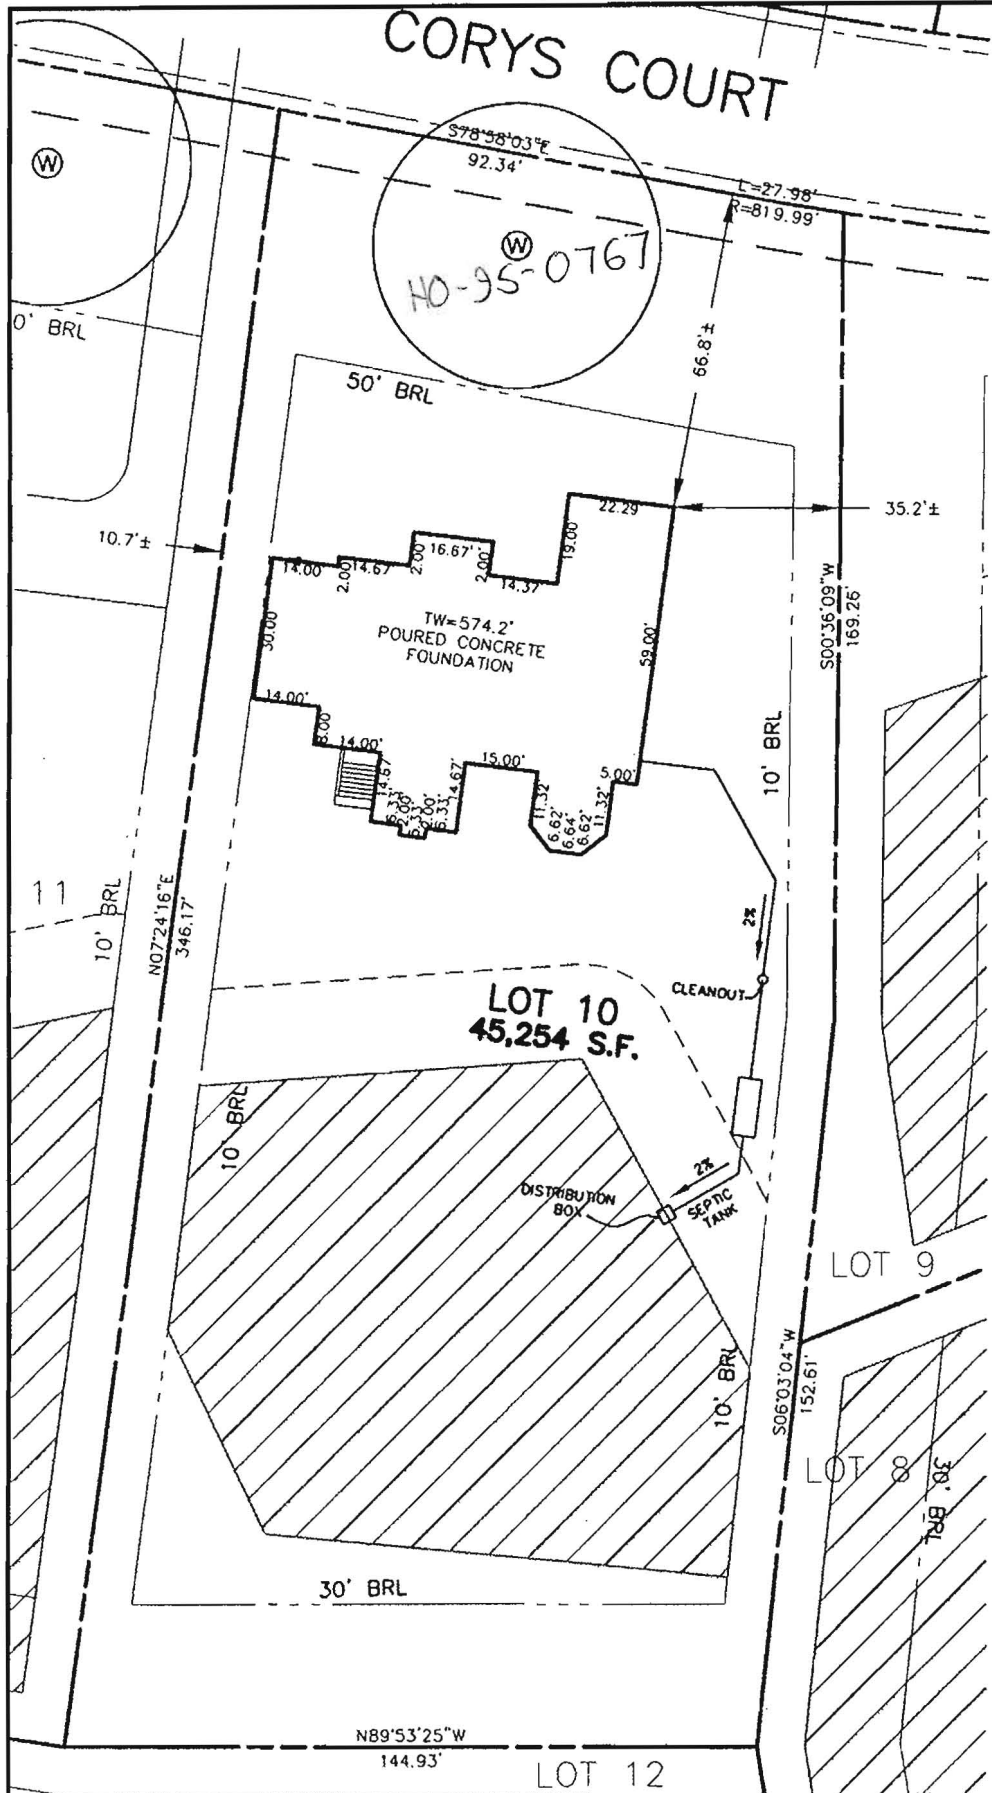

11-28-07  
Wall check OK  
HG


ADDRESS: 14605 CORYS COURT  
GLENELG, MD 21737  
PERMIT #: B07003241

### SURVEYOR'S CERTIFICATE

I HEREBY CERTIFY THAT THE POSITION OF THE EXISTING IMPROVEMENTS SHOWN HEREON HAVE BEEN CAREFULLY ESTABLISHED BY ACCEPTED LAND SURVEYING PRACTICES AND THAT, UNLESS SHOWN, THERE ARE NO VISIBLE ENCROACHMENTS EITHER WAY ACROSS THE PROPERTY LINES. THE PLAN IS OF BENEFIT TO A CONSUMER ONLY INsofar AS IT IS REQUIRED BY A LENDER OR A TITLE INSURANCE COMPANY OR ITS AGENT IN CONNECTION WITH CONTEMPLATED TRANSFER, FINANCING, OR REFINANCING. THE PLAN IS NOT TO BE RELIED UPON FOR THE ESTABLISHMENT OR LOCATION OF FENCES, GARAGES, BUILDINGS, OR OTHER EXISTING OR FUTURE IMPROVEMENTS. THE PLAN DOES NOT PROVIDE FOR THE ACCURATE IDENTIFICATION OF PROPERTY BOUNDARY LINES, BUT SUCH IDENTIFICATION MAY NOT BE REQUIRED FOR THE TRANSFER OF TITLE OR SECURING FINANCING OR REFINANCING. THIS DRAWING WAS PREPARED W/O THE BENEFIT OF A TITLE REPORT.

SIGNATURE: MICHAEL JOE BOYCE      21328      MD. LIC NO.      DATE

WALL CHECK  
LOT #10  
**EDGEWOOD FARM**  
LIBER 4174, FOLIO 0436  
PLAT No. 19266  
FOURTH ELECTION DISTRICT  
HOWARD COUNTY, MARYLAND

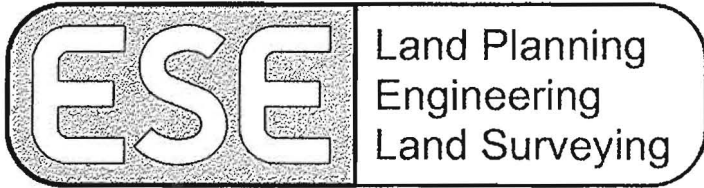

ESE Consultants Inc.  
7164 Columbia Gateway Dr.  
Suite 203  
Columbia, MD 21046  
TEL: 410-872-9105  
FAX: 410-872-4870

DATE: 10/12/07      SCALE: 1"=40'      FILE: LOT\_10  
CHK'D: MJB      JOB#: 1498      DRAWN: KSM



North America

WEIGHMASTER	PLANT ID	MARRIOTTSVILLE PLANT	TICKET NO.	152552
MCRAWFOR	30614	11411 MARRIOTTSVILLE ROAD, MARRIOTTSVILLE, MD	DATE	12/27/2007
ORDER NO.	LOCATION	Plant Phone : 410-461-8800	TIME IN	8:12
2101		Dispatch Phone : 410-461-8800	TIME OUT	10:07
CUSTOMER ID	CUSTOMER NAME		GROSS	31416 kg
3286928	FOGLES SEPTIC CLEAR		TARE	11648 kg
P.O. NUMBER	JOB NUMBER	QUOTE #	NET	19767 kg
		16116		21.79 tn
				19.77 t

JOB ADDRESS	ZONE #	HIRED ID	HIRED ID DESC	TRUCK ID	TRUCK DESC
MARYLAND VARIOUS-AGG, MARRIOTTSVILLE, MD			OWN CUSTOMER OWN 6674		FOGLES SEPTIC 6
DELIVERY INSTRUCTIONS	DELIVERY			E33530D	
MARYLAND VARIOUS-AGG		N			

PRODUCT ID	PRODUCT DESCRIPTION	QTY	QTY TODAY	LOAD #	UOM	PRICE	SUB TOTAL	TAX	TOTAL
AB7014	ASTM #4	21.79	43.15	2	TN				

STANDBY TIME APPROVAL	STANDBY TIME

RECEIVED BY	DRIVER'S SIGNATURE

C1817424



North America

TICKET NO.

152527

WEIGHMASTER	PLANT ID	MARRIOTTVILLE PLANT
MCRAWFOR	30614	11411 MARRIOTTVILLE ROAD, MARRIOTTVILLE, MD
ORDER NO.	LOCATION	Plant Phone : 410-461-8800
		Dispatch Phone : 410-461-8800

DATE	TIME IN	TIME OUT
12/27/2007	8:12	8:17

CUSTOMER ID	CUSTOMER NAME
3286928	FOGLES SEPTIC CLEA
P.O. NUMBER	JOB NUMBER
	15116
QUOTE #	

68400 lb	GROSS	31026 kg	MAX GVW
25600 lb	TARE	11648 kg	70000 lb
42720 lb	NET	19377 kg	
21.36 tn		19.38 t	

JOB ADDRESS	ZONE #	HIRED ID	HIRED ID DESC	TRUCK ID	TRUCK DESC
MARYLAND VARIOUS-AGG, MARRIOTTVILLE, MD			OWN CUSTOMER OWN 6674		FOGLES SEPTIC 6
DELIVERY INSTRUCTIONS	DELIVERY			E336300	
MARYLAND VARIOUS-AGG		N			

PRODUCT ID	PRODUCT DESCRIPTION	QTY	QTY TODAY	LOAD #	UOM	PRICE	SUB TOTAL	TAX	TOTAL
AG7014	ASTM #4	21.36	21.36	1	TN				

STANDBY TIME APPROVAL	STANDBY TIME

RECEIVED BY	DRIVER'S SIGNATURE

C1817399



North America

WEIGHMASTER	PLANT ID	MARRIOTTSVILLE PLANT		TICKET NO.		152490	
MCRANFOR	30614	11411 MARRIOTTSVILLE ROAD, MARRIOTTSVILLE, MD		DATE	TIME IN	TIME OUT	
ORDER NO.	LOCATION	Plant Phone	: 410-461-8800	12/26/2007	8:03	11:17	
2031		Dispatch Phone	: 410-461-8800				
CUSTOMER ID	CUSTOMER NAME			36050 lb	GROSS	16356 kg	MAX GVW
3286928	FOGLES SEPTIC CLEAR			16520 lb	TARE	7493 kg	40000 lb
P.O. NUMBER	JOB NUMBER	QUOTE #		19540 lb	NET	8863 kg	
		16116		9.77 tn		8.06 t	
JOB ADDRESS			ZONE #	HIRED ID	HIRED ID DESC	TRUCK ID	TRUCK DESC
MARYLAND VARIOUS-AGG, MARRIOTTSVILLE, MD					OWN CUSTOMER OWN 5239		FOGLES SEPTIC 5
DELIVERY INSTRUCTIONS				DELIVERY		E336480	
MARYLAND VARIOUS-AGG				N			

PRODUCT ID	PRODUCT DESCRIPTION	QTY	QTY TODAY	LOAD #	UOM	PRICE	SUB TOTAL	TAX	TOTAL
AG7014	ASTM #4	9.77	30.43	3	TN				
<p><i>JACK HALE</i> <i>12-26-07</i></p>									

STANDBY TIME APPROVAL	STANDBY TIME

RECEIVED BY	DRIVER'S SIGNATURE

C1817363



North America

WEIGHMASTER PLANT ID

MARRIOTTSTVILLE PLANT

TICKET NO.

152479

MCRAWFOR 30614

11411 MARRIOTTSTVILLE ROAD, MARRIOTTSTVILLE, MD 21104

DATE TIME IN TIME OUT

ORDER NO. LOCATION

Plant Phone : 410-461-8800

12/26/2007 8:03 9:58

2031

Dispatch Phone : 410-461-8800

CUSTOMER ID CUSTOMER NAME

37140 lb GROSS 16846 kg MAX GWW

3286928 FOGLES SEPTIC CLEAR

16520 lb TARE 7493 kg 40000 lb

P.O. NUMBER JOB NUMBER QUOTE #

20620 lb NET 9353 kg

16116

10.31 tn 9.35 t

JOB ADDRESS ZONE # HIRED ID HIRED ID DESC TRUCK ID TRUCK DESC

MARYLAND VARIOUS-AGG, MARRIOTTSTVILLE, MD

OWN CUSTOMER OWN 5239 FOGLES SEPTIC 5

DELIVERY INSTRUCTIONS DELIVERY

E336480

MARYLAND VARIOUS-AGG

N

PRODUCT ID	PRODUCT DESCRIPTION	QTY	QTY TODAY	LOAD #	UOM	PRICE	SUB TOTAL	TAX	TOTAL
AB7014	ASTM #4	10.31	20.66	2	TN				

STANDBY TIME APPROVAL STANDBY TIME

RECEIVED BY DRIVER'S SIGNATURE

C1817352

DLCMDT01 (3/07)



North America

TICKET NO.

152497

WEIGHMASTER PLANT ID MARRIOTTSVILLE PLANT

MCRAWFOR 30614 11411 MARRIOTTSVILLE ROAD, MARRIOTTSVILLE, MD

ORDER NO. LOCATION Plant Phone : 410-461-8800 12/26/2007 8:03 12:16  
2031 Dispatch Phone : 410-461-8800

CUSTOMER ID CUSTOMER NAME

3286928 FOGLES SEPTIC CLEAR

P.C. NUMBER JOB NUMBER QUOTE #

16116

36900 lb	GROSS	16737 kg	MAX GVW
16520 lb	TARE	7493 kg	40000 lb
20380 lb	NET	9244 kg	
10.19 tn		9.24 t	

JOB ADDRESS ZONE # HIRED ID HIRED ID DESC TRUCK ID TRUCK DESC

MARYLAND VARIOUS-AGS, MARRIOTTSVILLE, MD OWN CUSTOMER OWN 5239 FOGLES SEPTIC 5

DELIVERY INSTRUCTIONS DELIVERY

E33648D

MARYLAND VARIOUS-AGS

N

PRODUCT ID	PRODUCT DESCRIPTION	QTY	QTY TODAY	LOAD #	UOM	PRICE	SUB TOTAL	TAX	TOTAL
AG7014	ASTM #4	10.19	40.62	4	TN				

61  
Dios  
TAKC

STANDBY TIME APPROVAL STANDBY TIME

Empty box for standby time approval

RECEIVED BY DRIVER'S SIGNATURE

Empty box for received by and driver's signature

C1817370



North America

WEIGHMASTER PLANT ID

MARRIOTTSTVILLE PLANT

TICKET NO.

152508

MCRGWFOR 30614

11411 MARRIOTTSTVILLE ROAD, MARRIOTTSTVILLE, MD 21104

DATE TIME IN TIME OUT

ORDER NO. LOCATION

2031

Plant Phone : 410-461-8800

12/26/2007 8:03 13:46

Dispatch Phone : 410-461-8800

CUSTOMER ID CUSTOMER NAME

3286928 FOGLES SEPTIC CLEAN

34880 lb	GROSS	15021 kg	MAX GVW
16520 lb	TARE	7493 kg	40000 lb
18360 lb	NET	8328 kg	
9.18 tn		8.33 t	

P.O. NUMBER JOB NUMBER QUOTE #

16116

JOB ADDRESS ZONE # HIRED ID HIRED ID DESC TRUCK ID TRUCK DESC

MARYLAND VARIOUS-AGG, MARRIOTTSTVILLE, MD

OWN CUSTOMER OWN 5239 FOGLES SEPTIC 5

DELIVERY INSTRUCTIONS DELIVERY

E33648D

MARYLAND VARIOUS-AGG

N

PRODUCT ID	PRODUCT DESCRIPTION	QTY	QTY TODAY	LOAD #	UOM	PRICE	SUB TOTAL	TAX	TOTAL
AB7014	ASTM #4	9.18	49.80	5	TN				

STANDBY TIME APPROVAL	STANDBY TIME

RECEIVED BY	DRIVER'S SIGNATURE

C1817381

North America

TICKET NO.

152454

WEIGHMASTER      PLANT ID

MARRIOTTSTVILLE PLANT

MCPAINFOR      30614

11411 MARRIOTTSTVILLE ROAD, MARRIOTTSTVILLE, MD

DATE	TIME IN	TIME OUT
------	---------	----------

ORDER NO.      LOCATION

Plant Phone : 410-461-8800

12/26/2007      8:03      8:11

Dispatch Phone : 410-461-8800

CUSTOMER ID      CUSTOMER NAME

3286928      FOGLES SEPTIC CLEAN

37220 lb	GROSS	16882 kg	MAX GWW
----------	-------	----------	---------

16520 lb	TARE	7493 kg	40000 lb
----------	------	---------	----------

20700 lb	NET	9389 kg	
----------	-----	---------	--

10.35 tn		9.39 t	
----------	--	--------	--

P.O. NUMBER      JOB NUMBER      QUOTE #

16116

JOB ADDRESS	ZONE #	HIRED ID	HIRED ID DESC	TRUCK ID	TRUCK DESC
-------------	--------	----------	---------------	----------	------------

MARYLAND VARIOUS-AGG, MARRIOTTSTVILLE, MD      OWN      CUSTOMER OWN 5239      FOGLES SEPTIC 5

DELIVERY INSTRUCTIONS	DELIVERY
-----------------------	----------

E33648D

MARYLAND VARIOUS-AGG      N

PRODUCT ID	PRODUCT DESCRIPTION	QTY	QTY TODAY	LOAD #	UOM	PRICE	SUB TOTAL	TAX	TOTAL
A87014	ASTM #4	10.35	10.35		TN				

STANDBY TIME APPROVAL	STANDBY TIME

RECEIVED BY	DRIVER'S SIGNATURE

C1817327