

C1 7030

SEQUENCE NO. (MDE USE ONLY)

STATE OF MARYLAND WELL COMPLETION REPORT

THIS REPORT MUST BE SUBMITTED WITHIN 45 DAYS AFTER WELL IS COMPLETED.

(THIS NUMBER IS TO BE PUNCHED IN COLS. 3-6 ON ALL CARDS)

FILL IN THIS FORM COMPLETELY PLEASE TYPE

COUNTY NUMBER 13 A518964

ST/CO USE ONLY DATE Received MM DD YY 8 13

DATE WELL COMPLETED MM DD YY 3 27 07

Depth of Well 200 (TO NEAREST FOOT) 5/3/07

PERMIT NO. FROM "PERMIT TO DRILL WELL" HO-95-0767

OWNER: Toll Brothers, Inc. last name first name TOWN: Glenelg STREET OR RFD: Corys Court SUBDIVISION: Edgewood Farm SECTION: LOT: 10

WELL LOG Not required for driven wells

Table with columns: DESCRIPTION (Use additional sheets if needed), FEET (FROM, TO), check if water bearing. Rows include: RED SANDY MICA SOIL, BROWN WEATHERED SANDSTONE, WEATHERED ROCK, HARD GRAY ROCK, WATER BEARING AT: 95' + 160'

GROUTING RECORD yes no

WELL HAS BEEN GROUTED (Circle Appropriate Box) Y N TYPE OF GROUTING MATERIAL (Circle one) CEMENT CM BENTONITE CLAY BC NO. OF BAGS 20 NO. OF POUNDS 1880 GALLONS OF WATER 120 DEPTH OF GROUT SEAL (to nearest foot) from 0 TOP 52 ft. to 65 BOTTOM 58 ft. (enter 0 if from surface)

CASING RECORD

Diagram showing casing types insert appropriate code below. Codes: ST STEEL, CO CONCRETE, PL PLASTIC, OT OTHER. MAIN CASING TYPE: PL Nominal diameter top (main) casing (nearest inch): 6 Total depth of main casing (nearest foot): 65

OTHER CASING (if used) diameter inch depth (feet) from to

SCREEN RECORD

Diagram showing screen type or open hole insert appropriate code below. Codes: ST STEEL, BR BRASS, HO OPEN HOLE, PL PLASTIC, OT OTHER. DEPTH (nearest ft.): HO 65 200

NUMBER OF UNSUCCESSFUL WELLS: 0

WELL HYDROFRACTURED yes Y no N

CIRCLE APPROPRIATE LETTER A WELL WAS ABANDONED AND SEALED WHEN THIS WELL WAS COMPLETED E ELECTRIC LOG OBTAINED P TEST WELL CONVERTED TO PRODUCTION WELL

I HEREBY CERTIFY THAT THIS WELL HAS BEEN CONSTRUCTED IN ACCORDANCE WITH COMAR 26.04.04 "WELL CONSTRUCTION" AND IN CONFORMANCE WITH ALL CONDITIONS STATED IN THE ABOVE CAPTIONED PERMIT, AND THAT THE INFORMATION PRESENTED HEREIN IS ACCURATE AND COMPLETE TO THE BEST OF MY KNOWLEDGE.

DRILLERS LIC. NO. 1 MWD 355 DRILLERS SIGNATURE (MUST MATCH SIGNATURE ON APPLICATION)

LIC. NO. 1 D

SITE SUPERVISOR (sign. of driller or journeyman responsible for sitework if different from permittee)

C 2 DEPTH (nearest ft.)

Table with columns: 1, 2, 3, 75, 76. Rows include: A 8 9 11 15 17 21, C 2 23 24 26 30 32 36, S 36 39 41 45 47 51, R 36 39 41 45 47 51, E, S, L, O, T, S, I, Z, E, 1, 2, 3. DIAMETER OF SCREEN (NEAREST INCH) 56 60 from to

GRAVEL PACK IF WELL DRILLED WAS FLOWING WELL INSERT F IN BOX 68


MDE USE ONLY (NOT TO BE FILLED IN BY DRILLER) T (E.R.O.S.) W Q 70 72 74 75 76 TELESCOPE CASING LOG INDICATOR OTHER DATA

C 3 PUMPING TEST

HOURS PUMPED (nearest hour) 3 8 9 PUMPING RATE (gal. per min.) 8.57 PUMPING RATE (gal. per min.) 11 15 METHOD USED TO MEASURE PUMPING RATE BUCKET WATER LEVEL (distance from land surface) BEFORE PUMPING 50 17 20 ft. WHEN PUMPING 80 22 25 ft. TYPE OF PUMP USED (for test) A air P piston T turbine C centrifugal R rotary O other (describe below) J jet S submersible

PUMP INSTALLED

DRILLER INSTALLED PUMP YES NO IF DRILLER INSTALLS PUMP, THIS SECTION MUST BE COMPLETED FOR ALL WELLS. TYPE OF PUMP INSTALLED PLACE (A,C,J,P,R,S,T,O) IN BOX 29 CAPACITY: GALLONS PER MINUTE (to nearest gallon) 31 35 PUMP HORSE POWER 37 41 PUMP COLUMN LENGTH (nearest ft.) 43 47 CASING HEIGHT (circle appropriate box and enter casing height) + above - below LAND SURFACE (nearest foot) 1

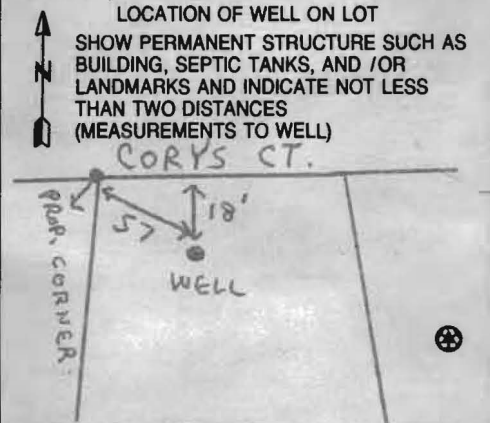

B 1 9359

SEQUENCE NO. (MDE USE ONLY)

STATE OF MARYLAND APPLICATION FOR PERMIT TO DRILL WELL please type 526283

STATE PERMIT NUMBER Ho-95-0767 fill in this form completely

Date Received (APA)

OWNER INFORMATION

8 MM DD YY 13 15 Last Name Owner First Name 34 7104 Columbia Gateway Dr, Suite Columbia, Md 21046 230 57 Town 70 State 72 Zip 76


B 3 LOCATION OF WELL

8 COUNTY 21 Howard Edgewood Farms 23 SUBDIVISION 42 SECTION 44 46 LOT 10 48 50 52 NEAREST TOWN Glenelg 71 MILES FROM TOWN (enter 0 if in town) 2 MI 73 76 77 78

DRILLER INFORMATION

76 Driller's Name Michael Barlow MW D 355 81 76 License No. 81 Bardon Well Drilling Srvc Firm Name 533 Underwood Ln, Bel Air, Md 21014 Address Signature Date 3/13/07

B 4 DIRECTION OF WELL FROM TOWN (CIRCLE BOX)

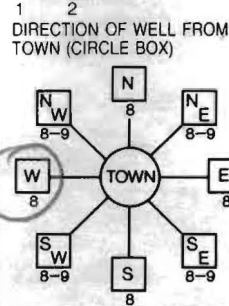

11 NEAR WHAT ROAD 30 RONS COURT ON WHICH SIDE OF ROAD (CIRCLE APPROPRIATE BOX) 34 37 38 39 DISTANCE FROM ROAD ENTER FT OR MI 90 TAX MAP 21 BLK 22 PARCEL 90

B 2 WELL INFORMATION APPROX. PUMPING RATE 5 GAL. PER MIN. 8 12 AVERAGE DAILY QUANTITY NEEDED 500 GAL. PER DAY 14 20

USE FOR WATER (CIRCLE APPROPRIATE BOX)

- D DOMESTIC POTABLE SUPPLY & RESIDENTIAL IRRIGATION (circled) F FARMING (LIVESTOCK WATERING & AGRICULTURAL IRRIGATION) I INDUSTRIAL, COMMERCIAL, DEWATERING P PUBLIC WATER SUPPLY WELL T TEST, OBSERVATION, MONITORING G GEO-THERMAL

NOT TO BE FILLED IN BY DRILLER HEALTH DEPARTMENT APPROVAL

Howard (13) A518964 COUNTY NAME COUNTY NO. STATE SIGNATURE INSERT S 41 DATE ISSUED 3/21/2007 Brian Baker 3/21/2008 43 MM DD YY 48 CO SIGNATURE EXP. DATE NORTH GRID 518 0 0 0 EAST GRID 793 0 0 0 50 55 57 63

APPROXIMATE DEPTH OF WELL 300 FEET 24 28 APPROXIMATE DIAMETER OF WELL 6 INCH NEAREST INCH

METHOD OF DRILLING (circle one)

BORED (or Augered) JETTED Jetted & DRIVEN 30 AIR-ROTary AIR-PERCussion ROTARY (Hydraulic Rotary) 37 CABLE REVerse-ROTary DRive-POINT other

REPLACEMENT OR DEEPEMED WELLS (CIRCLE APPROPRIATE BOX)


N THIS WELL WILL NOT REPLACE AN EXISTING WELL Y THIS WELL WILL REPLACE A WELL THAT WILL BE ABANDONED AND SEALED 39 S THIS WELL WILL REPLACE A WELL THAT WILL BE USED AS A STANDBY-CONTACT LOCAL APPROVING AUTHORITY FOR POLICY ON STANDBY WELLS D THIS WELL WILL DEEPEEN AN EXISTING WELL PERMIT NUMBER OF WELL TO BE REPLACED OR DEEPEMED (IF AVAILABLE) 41 52

SHOW MAJOR FEATURES OF BOX & LOCATE WELL WITH AN X

SOURCES OF DRILLING WATER 1. 2. 3.

WRITE THE BOX NUMBER FROM THE MAP HERE E 79893 000 000 N 52018

DRAW A SKETCH BELOW SHOWING LOCATION OF WELL IN RELATION TO NEARBY TOWNS AND ROADS AND GIVE DISTANCE FROM WELL TO NEAREST ROAD JUNCTION

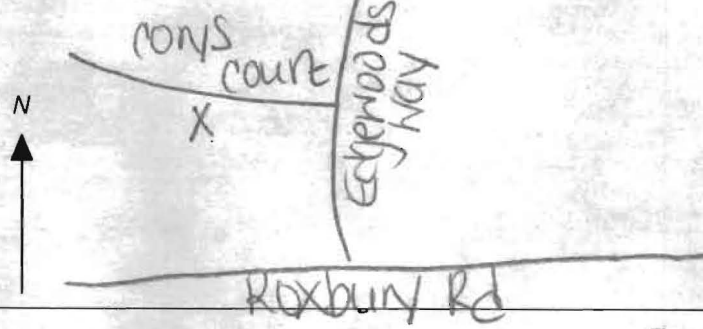

Not to be filled in by driller (MDE OR COUNTY USE ONLY)

APPROX. PERMIT NUMBER Ho 2006 0004 PERMIT No Ho-95-0767 70 71 72 73 74 75 76 77 78 79

SPECIAL CONDITIONS

NOTE APPROVING AUTHORITIES SHOULD USE SEPARATE SHEET IF NEEDED



**MICHAEL BARLOW WELL DRILLING & SERVICE, INC.**  
**522 Underwood Lane**                      **Bel Air, Maryland 21014**  
**(410) 838-6910**                                **Fax (410) 838-3582**

**WELL YIELD REPORT**

Date Test Completed: **March 27, 2007**

Well Depth: **200** feet

Customer	<u>Toll Brothers</u>	Permit #	<u>HO-95-0767</u>
Road	<u>Edgewoods Way</u>	Subdivision	<u>Edgewood Farms</u>
City	<u>Glenelg</u>	Section	
State	<u>Maryland</u>	Lot #	<u>10</u>

Time	Water Level feet	Time to Fill 1-gallon bucket seconds	G.P.M.
9:00 AM	50	7	8.57
9:15 AM	65	7	8.57
9:30 AM	75	7	8.57
9:45 AM	80	7	8.57
10:00 AM	80	7	8.57
10:15 AM	80	7	8.57
10:30 AM	80	7	8.57
10:45 AM	80	7	8.57
11:00 AM	80	7	8.57
11:15 AM	80	7	8.57
11:30 AM	80	7	8.57
11:45 AM	80	7	8.57
12:00 PM	80	7	8.57
12:15 PM	80	7	8.57
12:30 PM	80	7	8.57
12:45 PM	80	7	8.57

**HOWARD COUNTY HEALTH DEPARTMENT  
BUREAU OF ENVIRONMENTAL HEALTH  
WATER AND SEWERAGE PROGRAM  
TEL: (410)313-2640 FAX: (410)313-2648**

**Information Form for the Installation of the Well Pump, Pitless Adapter, and Supply Piping**

**NOTE: The installer is responsible for requesting an inspection prior to 9 am on the day of the desired inspection. No work is to be covered until approved by the Health Department. All installations must comply with the National Standard Plumbing Code (NSPC, as amended locally) and COMAR 26.04.04 (MD Well Construction Regulations). Submission of a complete form is required prior to Use and Occupancy approval.**

Company Name: Home Land Pump & Water Telephone #: 443-894-8659  
Address: 5414 A Arcadia Ave  
Upperco MD 21155

(Must circle one) Licensed Plumber      Licensed Well Driller      Licensed Well Pump Installer  
License # and name of individual responsible for the field installation:  
Name (Print): Michael Dodd License# PI 0161

**\*A licensed individual must perform the actual installation. Apprentices must be under the direct supervision of a licensed journeyman or master plumber, pump installer or well driller. Licenses may be subjected to field verification.**

Name of Property Owner: Toil Brothers Telephone #: 301-370-0335 - Brett  
Subdivision: The Reserve at Triadelphia Crossing Lot #: 10 Well Tag #: HO-95-0767  
Site Address: 14605 Cornys Ct  
Glenn Dale, MD 21737

<b>Submersible Pump Data</b>	<b>Pitless Adapter</b>	<b>Well Cap and Electric Conduit</b>
Make: <u>Grundfos</u>	Make: <u>Campbell</u>	Two piece watertight cap: <input checked="" type="checkbox"/>
Model #: <u>1554E07130</u>	Model #: <u>PA-800</u>	Screened, vented well cap: <input checked="" type="checkbox"/>
Pump Capacity <u>15</u> GPM	Depth: <u>42</u> (36" min)	Cap secured to casing: <input checked="" type="checkbox"/>
Well Yield: <u>8.5</u> GPM	NSF approved: <input checked="" type="checkbox"/>	Conduit min 18" B.G.: <input checked="" type="checkbox"/>
Depth of well encountered at time of pump installation: <u>200</u> (feet)		Conduit secured to well cap: <input checked="" type="checkbox"/>

If pump capacity exceeds well yield, a low water cut off switch is required by NSPC 1990 Section 17.8.4  
Torque arrestors or Cable guards are required - Must circle one  
Safety rope, if used, attached to inside of well casing with eye bolt     


<b>Piping to house</b>	<b>House Connection</b>
Type: <u>SID RG HDPE Pipe</u>	PVC sleeved to undisturbed soil at wall penetration: <input checked="" type="checkbox"/>
PSI: <u>160</u> (160 psi min)	Approximate length of sleeve (5 foot minimum): <u>6'</u>
Depth of supply line: <u>42</u> (36" min)	Sleeve caulked and sealed properly: <input checked="" type="checkbox"/>

**The water supply line is required to be at least ten feet from the septic tank, pump chamber, sewage piping, distribution box, drainfields, and sewage reserve area. If this cannot be accomplished, contact this office for approval prior to installation.**

Signature of company representative responsible for installation: [Signature] date: 3/6/08

**For Health Department Use Only - Not to be completed by Installer**

Date Insp. Requested: \_\_\_\_\_ Date Insp. Approved: 11/6/07 KW  
Inspection Data: Pitless adapter and water supply line at least 36" below grade   
Two piece cap installed and attached to casing securely   
Elec. conduit extends at least 18" below grade/attached to cap properly   
Safety rope installed inside of well casing   
Correct well tag attached properly and casing 8" above finished grade   
Water supply line sleeved adequately at house connection   
Adequate grout observed below pitless adapter

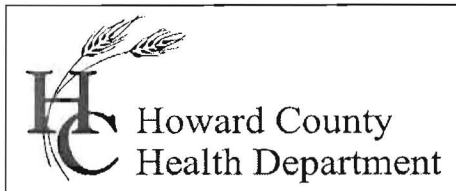

Bureau of Environmental Health  
7178 Gateway Drive Columbia, MD 21046  
(410) 313-2640 Fax (410) 313-2648  
TDD (410) 313-2323 Toll Free 1-866-313-6300  
website: www.hchealth.org

Peter L. Beilenson, M.D., M.P.H., Health Officer

May 9, 2008

Toll MD V, LP  
7164 Columbia Gateway Drive, #230  
Columbia, MD 21046

SENT VIA FACSIMILE 410-481-2278

RE: Edgewood Farm, Lot 10  
14605 Corys Court  
Glenelg, MD 21737  
BP #: B07003241  
Well Permit #: HO-95-0767

Dear Sirs:

This is to advise you that the septic system for the above referenced property has been installed and inspected. **Final approval of the septic system was granted on 05/08/2008. Final approval of the well line connection to the dwelling was approved on 11/06/2007.**

The water sample results indicate that the water samples submitted for testing were free of coliform and fecal coliform bacteria at the time of sampling and are bacteriologically safe for drinking. The water sample results were found to be in compliance with COMAR water quality standards.

#### INTERIM CERTIFICATE OF POTABILITY

This certifies that the initial sampling requirements of COMAR 26.04.04 "Well Regulations" have been met for the water supply system installed under well permit #HO- 95-0767. Although the submitted sample results are in compliance with COMAR standards, the Health Department does not guarantee water supplies. Based upon satisfactory investigation and evaluation, the Howard County Health Department as authorized by the Maryland Department of the Environment accepts this well system as required by COMAR 26.04.04.

This certificate may become final upon completion of the second bacteriological test, which is to be taken by the county health department within six months of receipt of this letter. **Please contact (410) 313-1792 to schedule a final water sample appointment. Currently, there is no charge for this final sampling.**

Date of Water Sample(s): 04/24/2008  
Date of Well Completion: 03/27/2007

Approving Authority,

Stuart Oster, R. S.  
Well & Septic Program

cc: Building Inspector's Office  
Community Health Services  
File





TRACE LABORATORIES, INC  
5 North Park Drive  
Hunt Valley, MD 21030 USA  
Telephone: 410/584-9099 / Fax: 410/584-9117  
Website: www.trace-labs.com / Email: info@trace-labs.com

Maryland State Certified Laboratory # 318

**LETTER OF RESULTS**

Home Land Septic Consulting  
Attn: Tim Sholtzberger  
5414-A Arcadia Road  
Upperco, Maryland 21155

Report Date: April 28, 2008

S/O#: 68081

*The following information was provided by Home Land Septic Consulting:*

Reference: Edgewood Farm @ the Reserve at Triadelphia Crossing  
Lot #10  
Glencelg, Maryland 21737

Well Information: HO-95-0767 2-Piece Cap  
Field pH: 5.5 Units

Date/Time Sampled: April 24, 2008 at 4:00 pm  
Date/Time Received: April 25, 2008 at 11:30 am

Listed below are results of drinking water analyses on a water sample collected by self (certified sampling #8065TS) and delivered to Trace Laboratories for analysis:

<u>Parameter</u>	<u>Result</u>	<u>MCL</u>	
Total Coliform:	Absent	Absent	Pass
E. coli:	Absent	Absent	
Nitrate-N:	8.3 mg/L as N	10 mg/L as N	Pass
Turbidity:	<1.0 NTU	10 NTU	Pass

MCL=Maximum Contamination Level

Allison R. Milburn  
Manager - Drinking Water Testing

NOTE: Trace Laboratories is not responsible for the collection or the transportation of the sample.